

STA. 0+00 LINE E
CONST. STD. 5.0' DIA.
MANHOLE
N 5506.7818
E 4989.3943

INSTALL:
10 L.F. OF 8" STUB-OUT
@ 0.50% NORTH & SOUTH
STA. 2+46.50 LINE E
CONST. STD. 5' DIA.
MANHOLE
RIM 569.5
N 5511.9394
E 5235.8403

STA. 5+20.00 LINE E
CONST. STD. 5' DIA.
MANHOLE
RIM 574.50
N 5494.0881
E 5505.9065

STA. 8+20.88 LINE E
CONST. STD. 5' DIA.
MANHOLE
RIM 580.00
N 5500.3814
E 5806.7202

STA. 11+96.04 LINE E
CONST. STD. 5' DIA.
MANHOLE
RIM 579.00
N 5866.8031
E 5851.5517


STA. 13+51.88 (21.50' RT)
FIELDCREST DRIVE=
STA. 9+58.03 LINE A=
STA. 16+83.45 LINE E
CONST. 5' DIA.
DROP MANHOLE
RIM 585.45

BENCHMARK: ELEV. = 600.69
CITY OF ROCKWALL R-19
BRASS MONUMENT AT THE N/W CORNER OF
SILVERVIEW & DIAMOND WAY. 500' ± SOUTH OF
S.H. 276.

BENCHMARK: ELEV. = 583.56
R.R. SPIKE SET IN THE CENTERLINE OF S.H. 276
3600± WEST OF F.M. 549

NOTE:
1. SANITARY SEWER LOCATED 7' BACK OF CURB.

CURVE	RADIUS	DELTA	TANGENT	LENGTH	CHORD	BEARING	PC STA.	PT STA.
C-1	200.00'	28°03'16"	49.97'	97.93'	96.95'	S 77°10'18"	2+46.50	3+44.43
C-2	200.00'	18°06'02"	31.86'	63.18'	62.92'	N 17°49'16"	8+20.88	8+84.06
C-3	1608.50'	05°33'39"	78.12'	156.11'	156.05'	N 11°33'05"	8+84.06	10+40.17
C-4	271.50'	32°53'35"	80.15'	155.87'	153.73'	N 02°06'54"	10+40.17	11+96.04
C-5	831.50'	05°50'40"	42.44'	84.82'	84.78'	N 69°05'58"	11+96.04	12+80.86

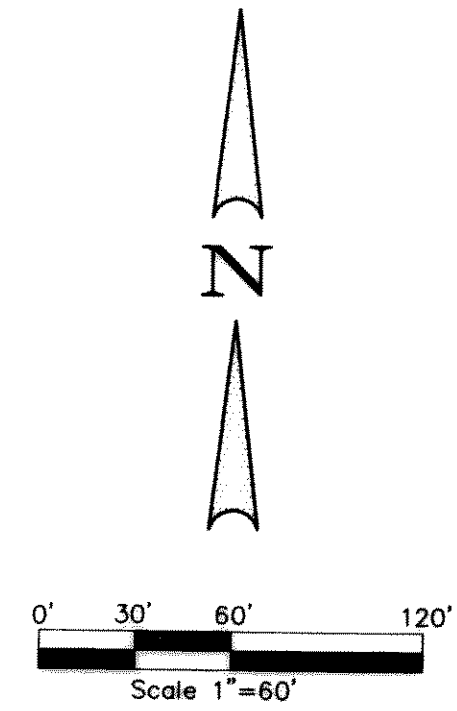

**OFFSITE
SANITARY SEWER PLAN
LINE 'E'**

W.H. BAIRD SURVEY, ABSTRACT NO. 25
CITY OF ROCKWALL
ROCKWALL COUNTY, TEXAS

CONTINENTAL HOMES
621 WEST COLLEGE STREET
GRAPEVINE, TEXAS 76051

Scale : 1"=60' Date : 4-10-00
Designed By : DA
Drawn By : DA
Checked By : FEM
File : 3200WSE2.DWG View :
Project No. : 3200.01

**SHEET
19A
OF
32**

NO.	9/12/00	DATE	ADDED MANHOLE PER CITY	REVISION	RE	APPROV.
						Winkelman & Associates, Inc. CONSULTING CIVIL ENGINEERS & SURVEYORS 1925 West Loop West, Suite 100 Dallas, Texas 75220 www.winkelman.com (972) 486-7990