

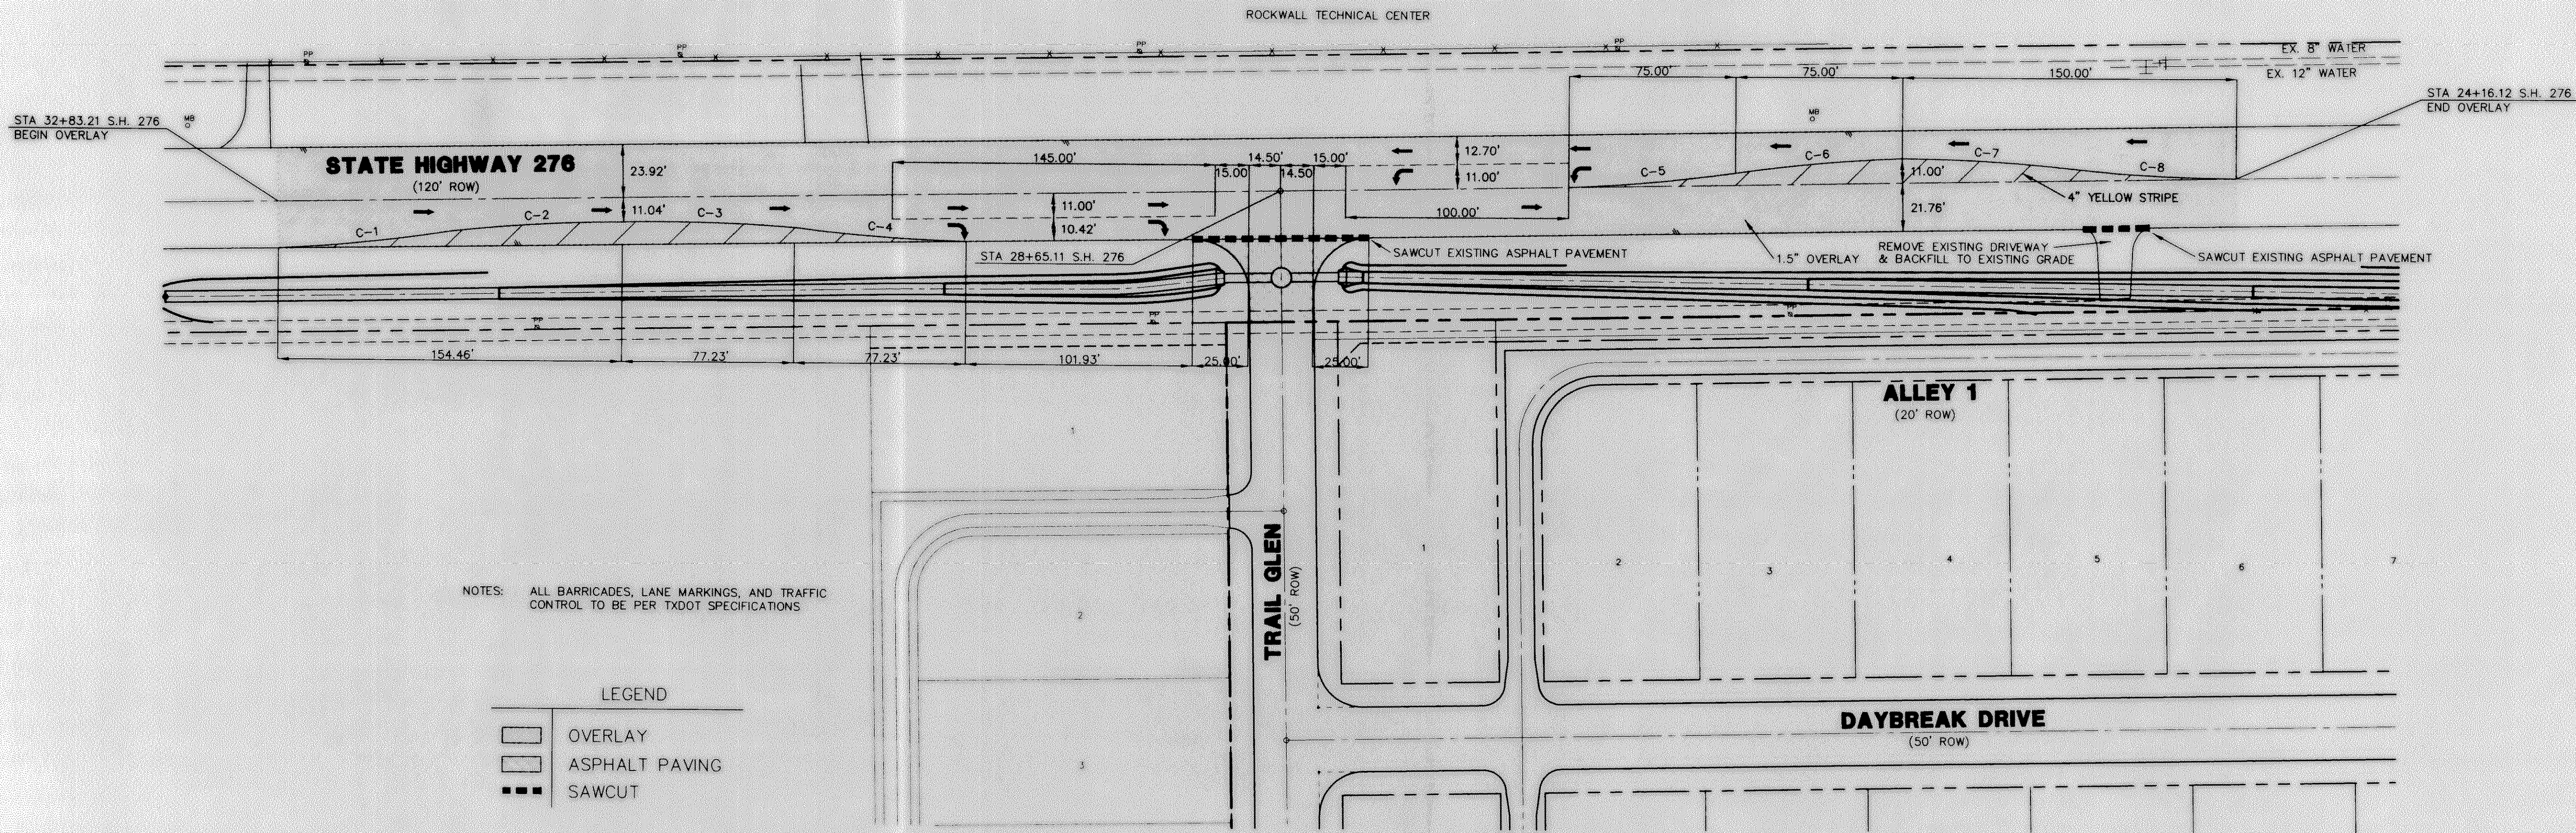


CURVE	RADIUS	DELTA	TANGENT	LENGTH	CHORD	BEARING
C-1	723.84'	06°12'37"	39.27'	78.46'	78.42'	S 83°53'19" W
C-2	715.00'	06°10'55"	38.61'	77.14'	77.11'	N 86°38'00" E
C-3	715.00'	06°10'55"	38.61'	77.14'	77.11'	S 88°33'02" W
C-4	715.00'	06°13'03"	38.83'	77.59'	77.55'	N 85°47'26" W
C-5	715.00'	06°01'45"	37.65'	75.24'	75.20'	S 84°47'27" W
C-6	715.00'	06°01'43"	37.65'	75.23'	75.20'	N 84°47'25" E
C-7	715.00'	06°01'43"	37.65'	75.23'	75.20'	S 86°49'15" W
C-8	715.00'	06°01'45"	37.65'	75.24'	75.20'	N 86°49'17" W

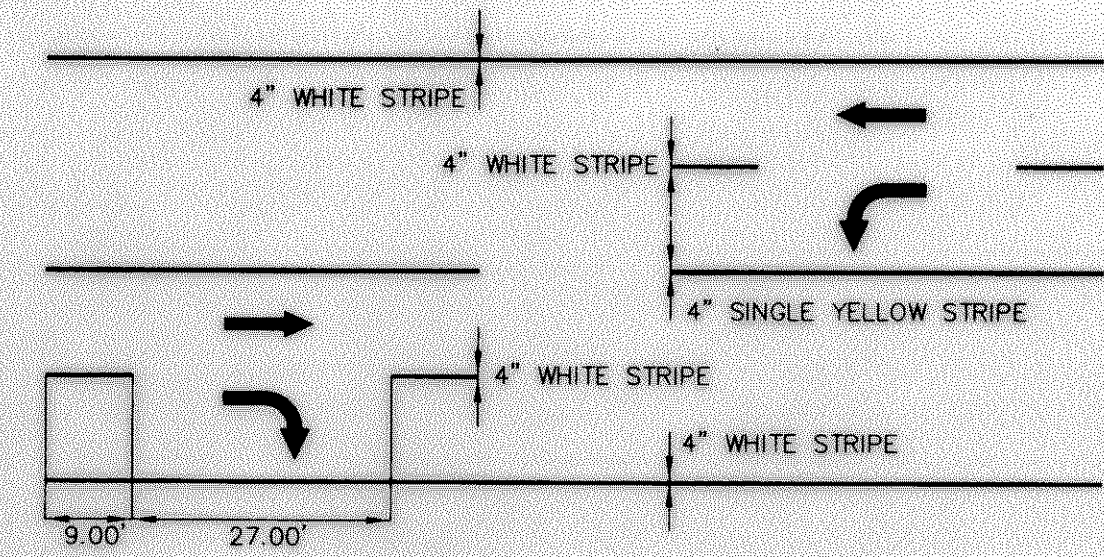

NOTES: ALL BARRICADES, LANE MARKINGS, AND TRAFFIC CONTROL TO BE PER TxDOT SPECIFICATIONS

LEGEND	
	OVERLAY
	ASPHALT PAVING
	SAWCUT

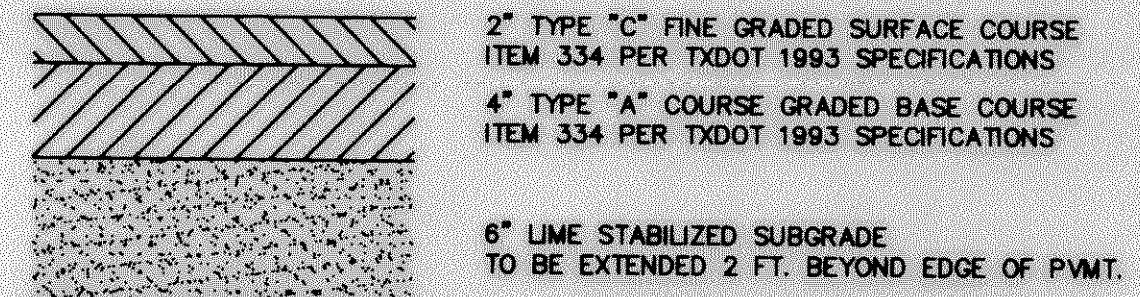


ASPHALT PAVEMENT SECTION

**BENCHMARK:** ELEV. = 600.69  
 CITY OF ROCKWALL R-19  
 BRASS MONUMENT AT THE N/W CORNER OF  
 SILVERVIEW & DIAMOND WAY, 500' ± SOUTH OF  
 S.H. 276.

**BENCHMARK:** ELEV. = 583.56  
 R.R. SPIKE SET IN THE CENTERLINE OF S.H. 276  
 3600± WEST OF F.M. 549

Winkelman & Associates, Inc. hereby states that this plan, to the best of our knowledge and belief, was prepared by us or under our direct supervision and that we are a duly licensed professional engineer in the State of Texas. We warrant that the information furnished herein is true and correct and that we are not aware of any facts or circumstances which would render the information furnished herein false or misleading.

*[Signature]* 10-2-00

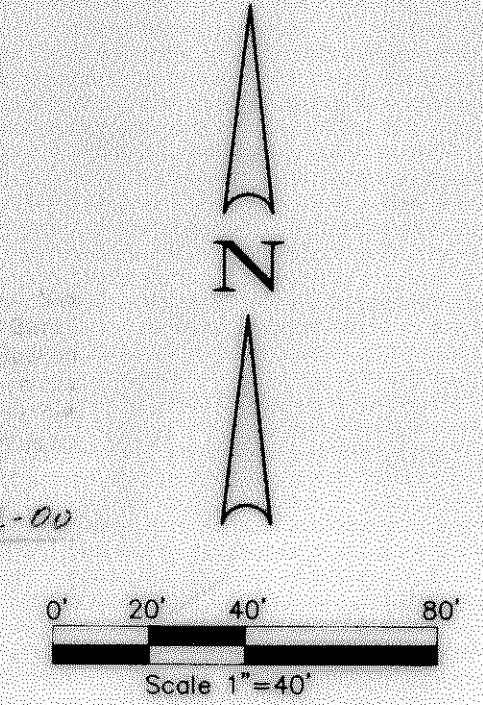

NO.	DATE	REVISION	APPROV.

**Winkelman & Associates, Inc.**  
 CONSULTING CIVIL ENGINEERS & SURVEYORS  
 1825 Hillside Blvd., Suite 100  
 Dallas, Texas 75210  
 (972) 988-7900  
 www.winkelman.com

STATE OF TEXAS  
 ENGINEER  
 E. L. WOODLIF, JR.  
 87449

W.H. BAIRD SURVEY, ABSTRACT NO. 25  
 CITY OF ROCKWALL  
 ROCKWALL COUNTY, TEXAS  
 CONTINENTAL HOMES  
 621 WEST COLLEGE STREET  
 GRAPEVINE, TEXAS 76051

**STATE HIGHWAY 276 & TRAIL GLEN  
 PAVING & STRIPING PLAN**

Scale : 1"=40' Date : 2/9/00  
 Designed By : DA  
 Drawn By : DA  
 Checked By : FEM  
 File : 3200PS/DWG View :  
 Project No. : 32001.01