


NO.	DATE	REVISION	APPROV.

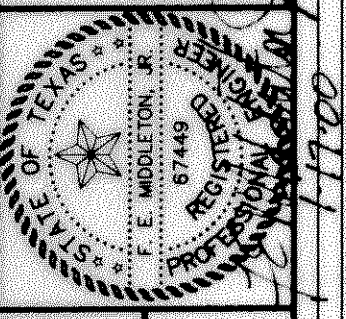

W.H. BAIRD SURVEY, ABSTRACT NO. 25  
 CITY OF ROCKWALL  
 ROCKWALL COUNTY, TEXAS  
 CONTINENTAL HOMES  
 621 WEST COLLEGE STREET  
 GRAPEVINE, TEXAS 76051

**PAVING PROFILE**  
**ALLEY 1**  
**STA. 0+00 TO 16+55.67**

Scale: 1" = 10'-0" Date: 1-3-00  
 Designed By: MK  
 Drawn By: DA  
 Checked By: FEM  
 File: 32001A.DWG View:  
 Project No.: 32001.01

*F. E. Mink* 10-2-00