


BENCHMARK:
CITY OF ROCKWALL R-19
BRASS MONUMENT AT THE N/W CORNER OF
SILVERVIEW & DIAMOND WAY, 500' ± SOUTH OF
S.H. 276.
ELEV. = 563.56
BENCHMARK:
R.R. SPIKE SET IN THE CENTERLINE OF S.H. 276
3600E WEST OF F.M. 549

Scale: 1" = 10'
Designed By: RB
Drawn By: DA
Checked By: FEM
File: 32001551.DWG
View:
Project No.: 32001.01

SANITARY SEWER PROFILE
LINE 'B'
STA. 0+00 TO STA. 17+90

W.H. BARD SURVEY, ABSTRACT NO. 25
CITY OF ROCKWALL
ROCKWALL COUNTY, TEXAS
CONTINENTAL HOMES
621 WEST COLLEGE STREET
GRAPEVINE, TEXAS 76051

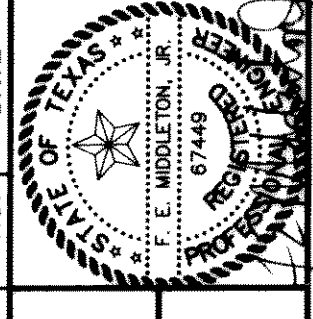

Winkelman & Associates, Inc.
CONSULTING CIVIL ENGINEERS & SURVEYORS
6700 Wilshire Plaza Drive, Suite 100
Dallas, Texas 75230
(972) 490-2999 FAX
www.winkelman.com

NO.	DATE	REVISION	APPROV.
1	4-10-00	REVISED LINE 'B'	RB

4-11-00