


STATION	PC	PT	PI	PA	PERCENT	CHORD BEARING	CHORD LENGTH	TANGENT LENGTH	RADIUS	DELTA	CURVE DATA
580.00	580.00	580.00	580.00	580.00	0.70	N 08°12'59" W	115.00	2001.25	205.67	407.14	C-1
585.00	585.00	585.00	585.00	585.00	0.70	N 08°12'59" W	115.00	2001.25	205.67	407.14	C-2
590.00	590.00	590.00	590.00	590.00	0.70	N 08°12'59" W	115.00	2001.25	205.67	407.14	C-3
595.00	595.00	595.00	595.00	595.00	0.70	N 08°12'59" W	115.00	2001.25	205.67	407.14	C-4

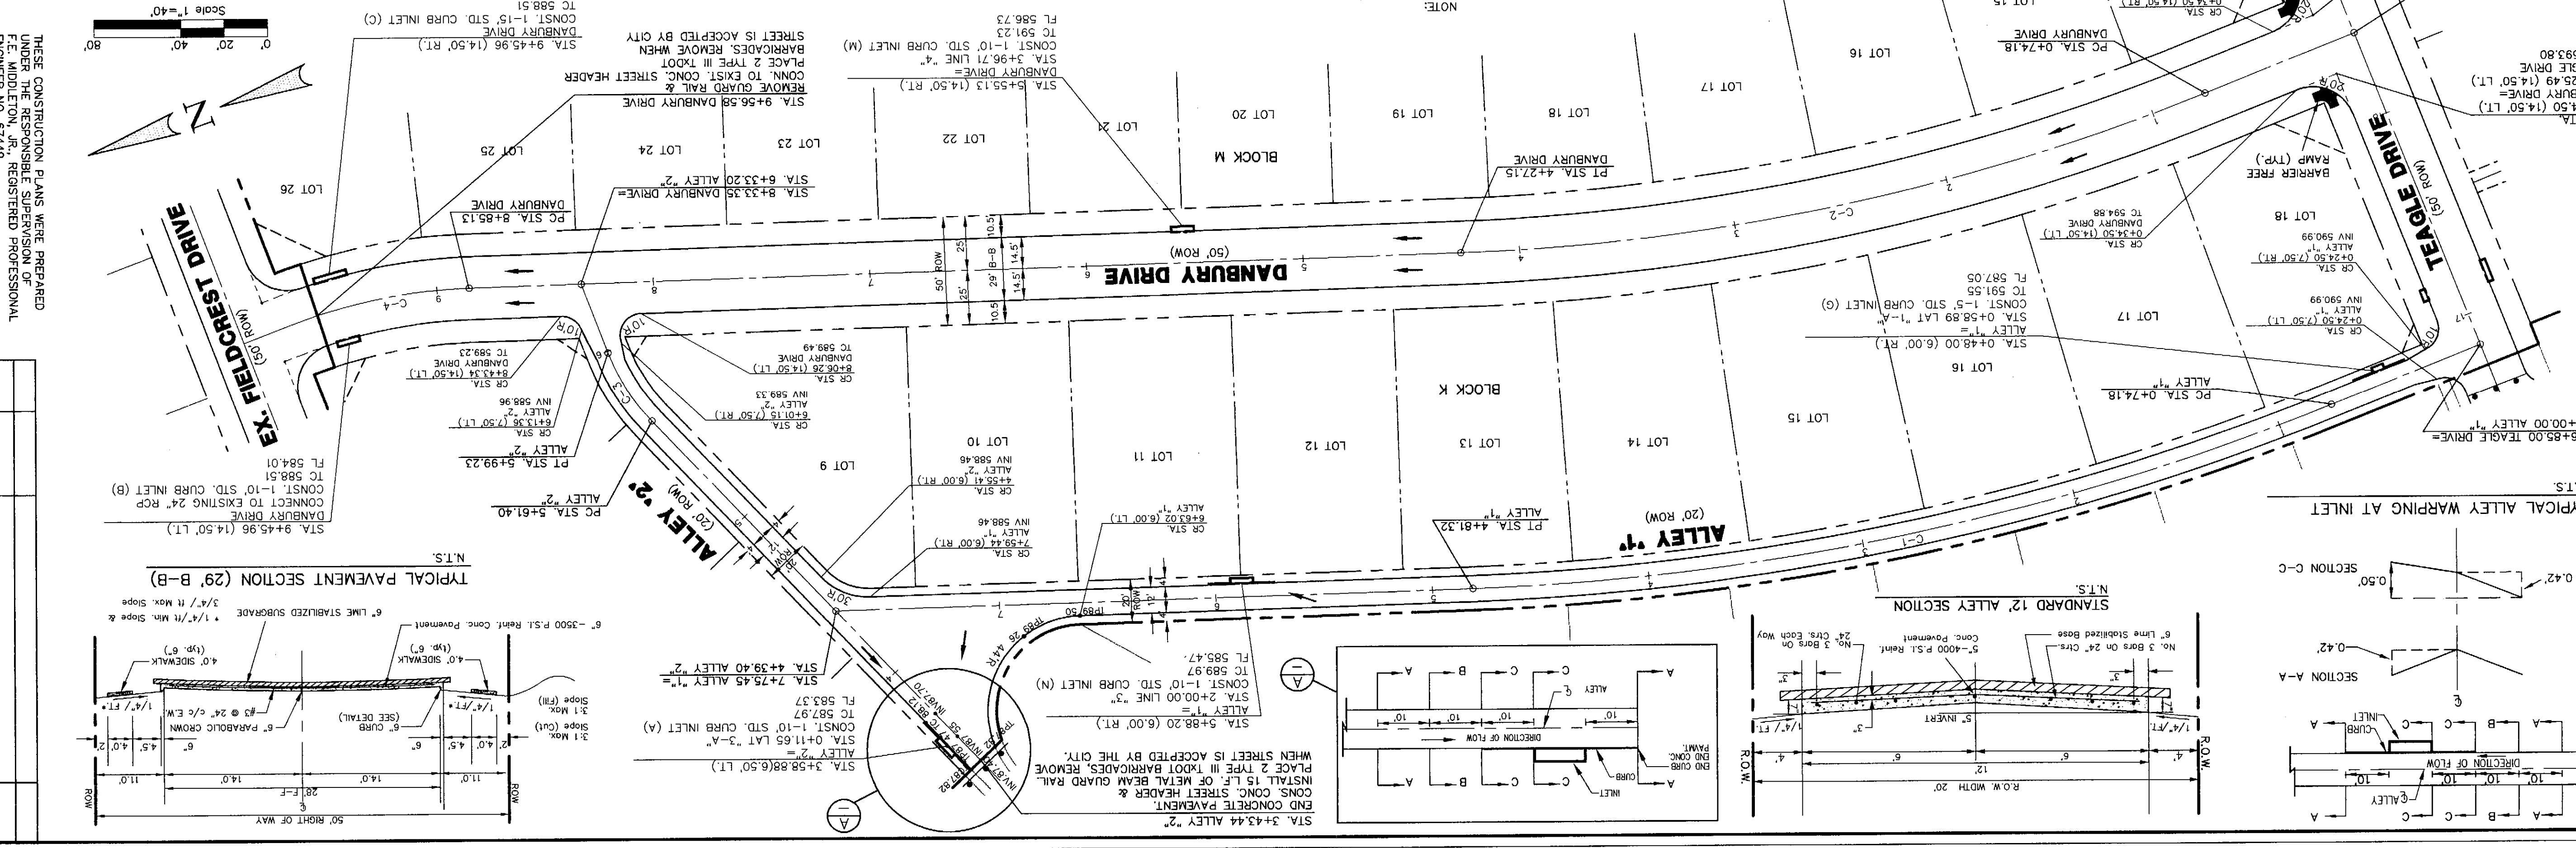

THE SEAL APPEARING ON THIS DOCUMENT WAS AUTHORIZED BY F.E. MIDDLETON, JR., P.E. #67449

W.H. BAIRD SURVEY ABSTRACT NO. 25
CITY OF ROCKWALL
ROCKWALL COUNTY, TEXAS

CONTINENTAL HOMES
621 WEST COLLEGE STREET
GRAPEVINE, TEXAS 76051

Winkelman & Associates, Inc.
CONSULTING CIVIL ENGINEERS & SURVEYORS
6120 National Plaza Drive, Suite 100
Dallas, Texas 75230
(972) 460-2700
FAX (972) 460-2700 132

20
2
Scale: 1" = 40'
Date: 02/14/01
Designed By: RB
Drawn By: DA
Checked By: FEM
File: 3200101.DWG
Project No.: 3200101

PAVING PLAN & PROFILE
DANBURY DRIVE
ALLEY '1' & ALLEY '2'
LOFLAND FARMS, PHASE 2

NO. DATE REVISION APPROV.