

Winkelmann & Associates, Inc. hereby states that the information furnished herein is true and correct to the best of our knowledge as of the date hereof. We warrant that the documents have been prepared in accordance with the standards and practices of the profession of civil engineering and that we are duly licensed and qualified to perform the services herein. We warrant that the documents are prepared in accordance with the standards and practices of the profession of civil engineering and that we are duly licensed and qualified to perform the services herein. We warrant that the documents are prepared in accordance with the standards and practices of the profession of civil engineering and that we are duly licensed and qualified to perform the services herein.

DATE: 12-10-01


Scale: 1" = 1'-0" Date: 02/14/01  
 Designed By: RB  
 Drawn By: DA  
 Checked By: FEW  
 File: 3200\A2.DWG  
 Project No.: 3200\01

**PAVING PROFILE**  
**ALLEY '4' & ALLEY '6'**  
**LOFLAND FARMS, PHASE 2**

THE SEAL APPEARING ON THIS DOCUMENT WAS AUTHORIZED BY F.E. MIDDLETON, JR., P.E. #67449

THESE CONSTRUCTION PLANS WERE PREPARED UNDER THE RESPONSIBLE SUPERVISION OF F.E. MIDDLETON, JR., REGISTERED PROFESSIONAL ENGINEER NO. 67449

W.H. BARD SURVEY, ABSTRACT NO. 25  
 CITY OF ROCKWALL  
 ROCKWALL COUNTY, TEXAS  
 CONTINENTAL HOMES  
 621 WEST COLLEGE STREET  
 GRAPEVINE, TEXAS 76051

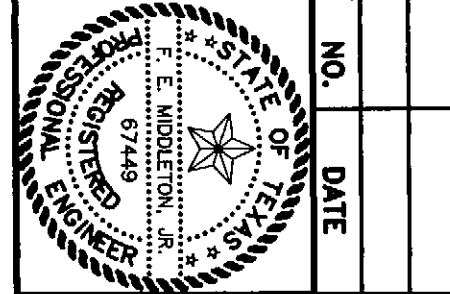

**Winkelmann & Associates, Inc.**  
 CONSULTING CIVIL ENGINEERS & SURVEYORS  
 6200 Highway 289, Suite 100  
 www.winkelmann.com  
 (972) 261-2793 FAX

NO.	DATE	REVISION	APPROV.