

Winkelman & Associates, Inc.  
 I certify as to the correctness or quality of construction as no field inspection was performed.  
 The standards and specifications as set forth herein provided by the Department of Transportation are hereby accepted and incorporated into the contract.  
 I hereby state that this plan, to the best of our knowledge and belief, is correct and complete.  
 Winkelman & Associates, Inc. hereby states that this plan is a true and correct copy of the original as shown to the City of Rockwall, Texas.  
 DATE: 12-10-99

THE SEAL APPEARING ON THIS DOCUMENT WAS AUTHORIZED BY F.E. MIDDLETON, JR., P.E. #97449


THESE CONSTRUCTION PLANS WERE PREPARED UNDER THE RESPONSIBLE SUPERVISION OF F.E. MIDDLETON, JR., REGISTERED PROFESSIONAL ENGINEER NO. 97449.

W.H. BAIRD SURVEY, ABSTRACT NO. 25

Scale: 1" = 10'-0"  
 Date: 02/14/01  
 Designed By: RB  
 Drawn By: DA  
 Checked By: FEW  
 File: 32001A2.DWG  
 Project No.: 32001.01

**PAVING PROFILES**  
**ALLEY '3' & ALLEY '5'**  
**LOFLAND FARMS, PHASE 2**

CITY OF ROCKWALL  
 ROCKWALL COUNTY, TEXAS  
 CONTINENTAL HOMES  
 621 WEST COLLEGE STREET  
 GRAPEVINE, TEXAS 76051

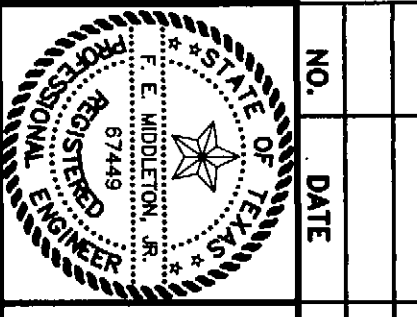

**Winkelman & Associates, Inc.**  
 CONSULTING CIVIL ENGINEERS • SURVEYORS  
 6750 Hillcrest Road, Suite 100  
 Dallas, Texas 75230  
 (972) 485-7900  
 (972) 485-7889 FAX

NO.	DATE	REVISION	APPROV.