

THESE CONSTRUCTION PLANS WERE PREPARED UNDER THE RESPONSIBLE SUPERVISION OF F.E. MIDDLETON, JR., REGISTERED PROFESSIONAL ENGINEER NO. 87449.

DATE: 5-20-02

APPROVED: [Signature]

THE SEAL APPEARING ON THIS DOCUMENT WAS AUTHORIZED BY F.E. MIDDLETON, JR., P.E. #67449

Winkelman & Associates, Inc. hereby states that this plan to the best of our knowledge is "As Built" and is based on the original approved construction documents. We have made no changes to the information provided by the contractor. Winkelman & Associates, Inc. does not certify as to the correctness or quality of construction as no field inspection was made.

[Signature]

WINKELMAN & ASSOCIATES, INC.

DATE: 5-20-02

NO.	DATE	REVISION	APPROV.
5-20-02		ADDITION OF ONE 5' STD. CURB INLET	FEM


**STORM SEWER PROFILES**  
**LINE '8' & LINE '9'**  
**LOFLAND FARMS, PHASE 4**

BENCHMARK: ELEV. = 500.69  
CITY OF ROCKWALL, TEXAS  
BRASS MONUMENT AT THE N/W CORNER OF  
S.W. 27th & DIAMOND HWY. 500 ± SOUTH OF  
S.W. 27th

BENCHMARK: ELEV. = 563.56  
BENCH MARK IN THE CENTERLINE OF STA. 27+00  
3600± WEST OF F.M. 549

Scale: H: 1"=20'  
Date: 5-20-02  
Designed By: RB  
Drawn By: MK  
Checked By: FEM  
File: 320024517.DWG View: 1  
Project No.: 32002.01

**SHEET**  
**14**  
**OF**  
**24**

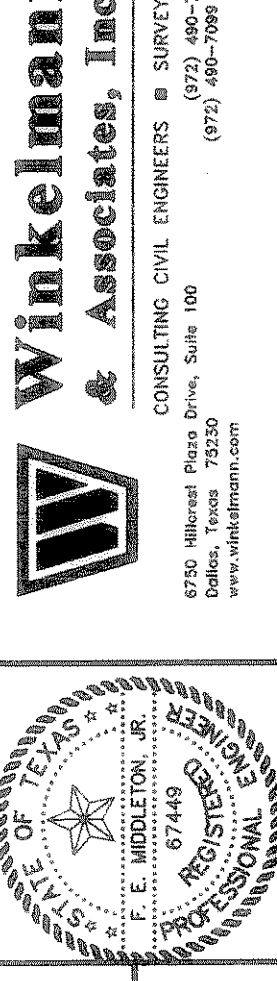

W.H. BAIRD SURVEY, ABSTRACT NO. 25  
CITY OF ROCKWALL  
ROCKWALL COUNTY, TEXAS  
CONTINENTAL HOMES  
621 WEST COLLEGE STREET  
GRAPEVINE, TEXAS 76051

