



BENCHMARK: ELEV. = 600.69  
 CITY OF ROCKWALL R-19  
 BRASS MONUMENT AT THE N/W CORNER OF  
 SILVERVIEW & DIAMOND WAY, 500' ± SOUTH OF  
 S.H. 276.

BENCHMARK: ELEV. = 583.56  
 R.R. SPIKE SET IN THE CENTERLINE OF S.H. 276  
 3600± WEST OF F.M. 549

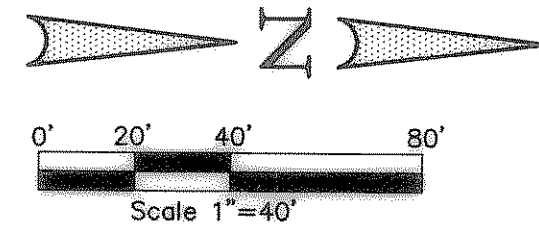

NOTE:  
 ALL FILL TO BE COMPACTED  
 WITH SHEEPS FOOT ROLLER

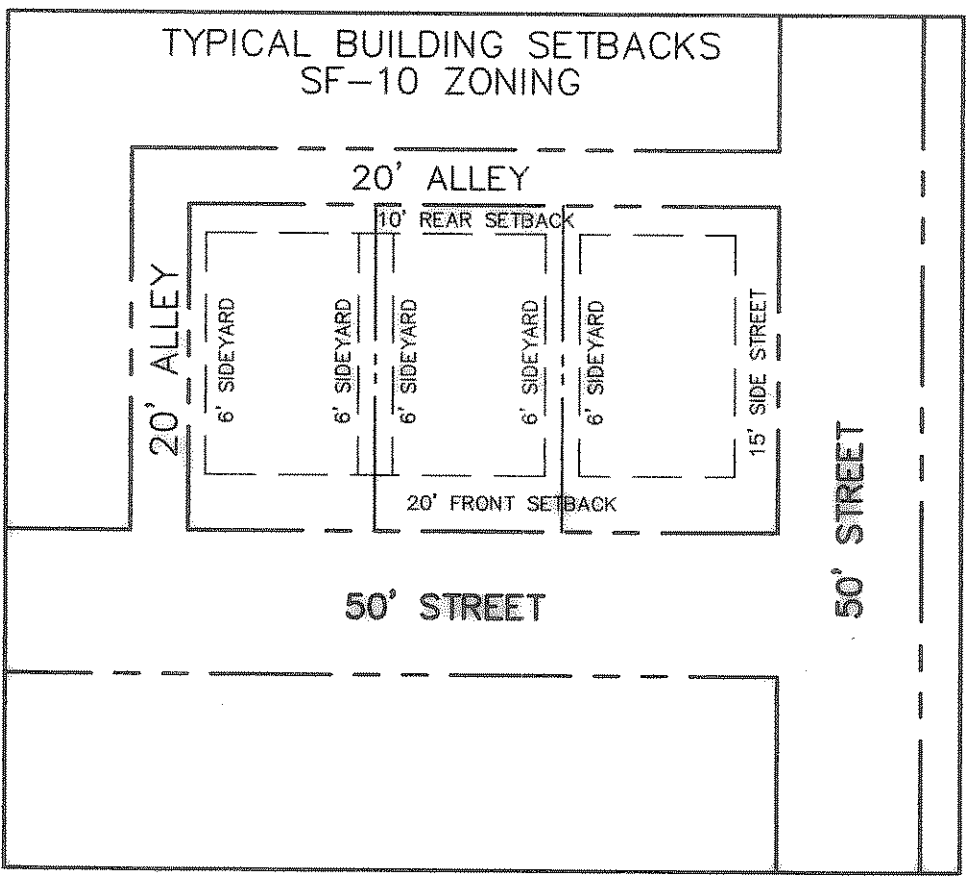

AS BUILT  
 Winkelmann & Associates, Inc. hereby states that this plan, to the best of our knowledge is "As Built." Modifications from the originally approved construction requirements have been made as per information provided by the contractor. Winkelmann & Associates, Inc. does not certify as to the correctness or quality of construction as no field inspection was performed.  
 W. N. Winkelmann 5/14/04  
 WINKELMANN & ASSOCIATES, INC. DATE

THESE CONSTRUCTION PLANS WERE PREPARED UNDER THE RESPONSIBLE SUPERVISION OF  
 MD. NAIM UDDIN KHAN, REGISTERED PROFESSIONAL ENGINEER NO. 87776  
 W. N. Winkelmann 9/15/03

LOFLAND FARMS, PHASE 5A  
 BAIRD SURVEY, ABSTRACT NO. 25  
 CITY OF ROCKWALL  
 ROCKWALL COUNTY, TEXAS


CONTINENTAL HOMES  
 621 WEST COLLEGE STREET  
 GRAPEVINE, TEXAS 76051

LOT GRADING PLAN  
 LOFLAND FARMS, PHASE 5-A


Scale: 1"=40' Date: 04-01-03  
 Designed By: RB  
 Drawn By: MK  
 Checked By: MK  
 File: 320045AL.GI.DWG  
 Project No.: 32004.01

SHEET  
 31  
 OF  
 35


NO.	DATE	REVISION	APPROV.

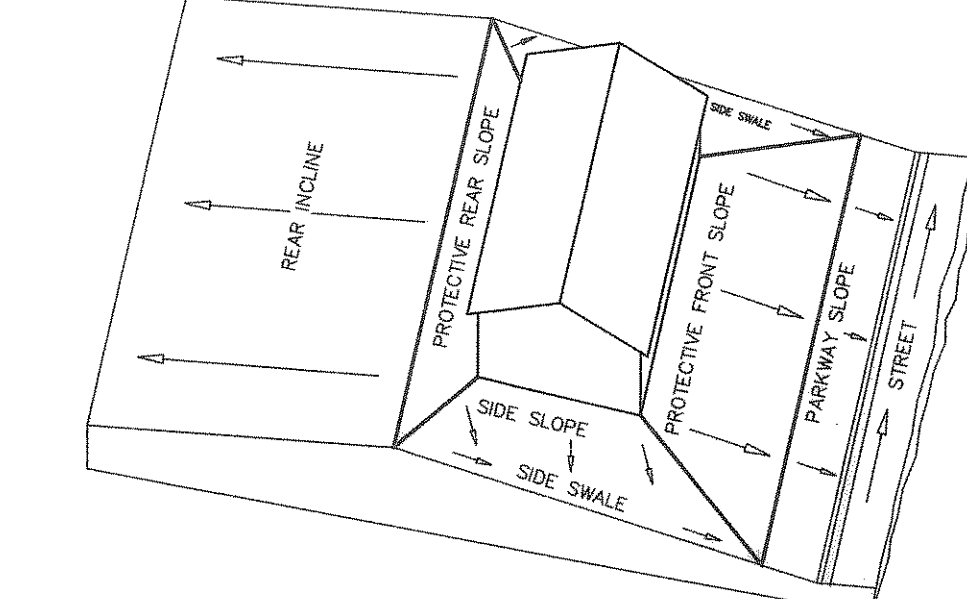

LOT GRADING TYPE B

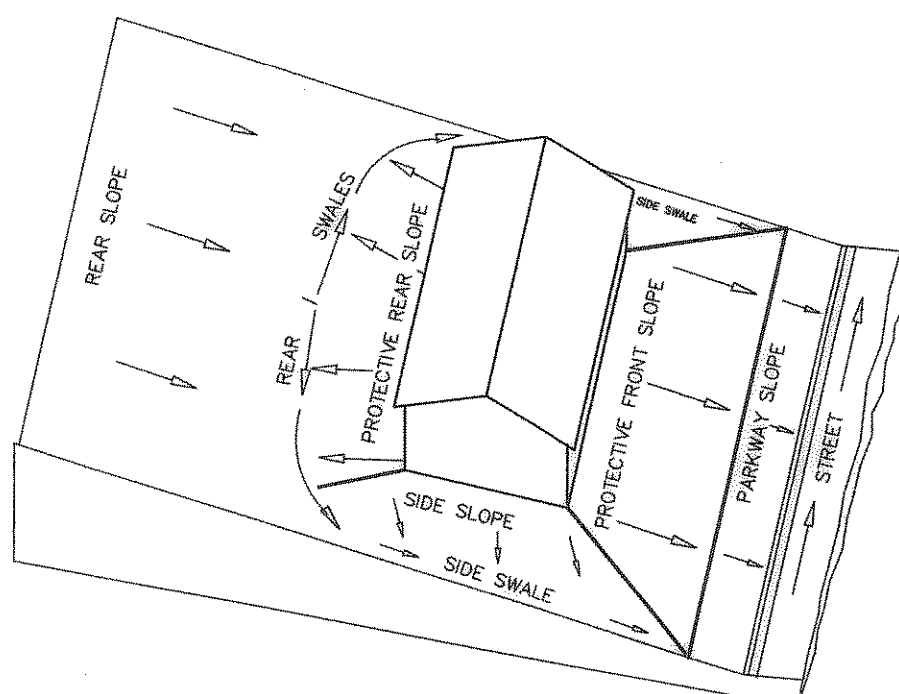

LOT GRADING TYPE A

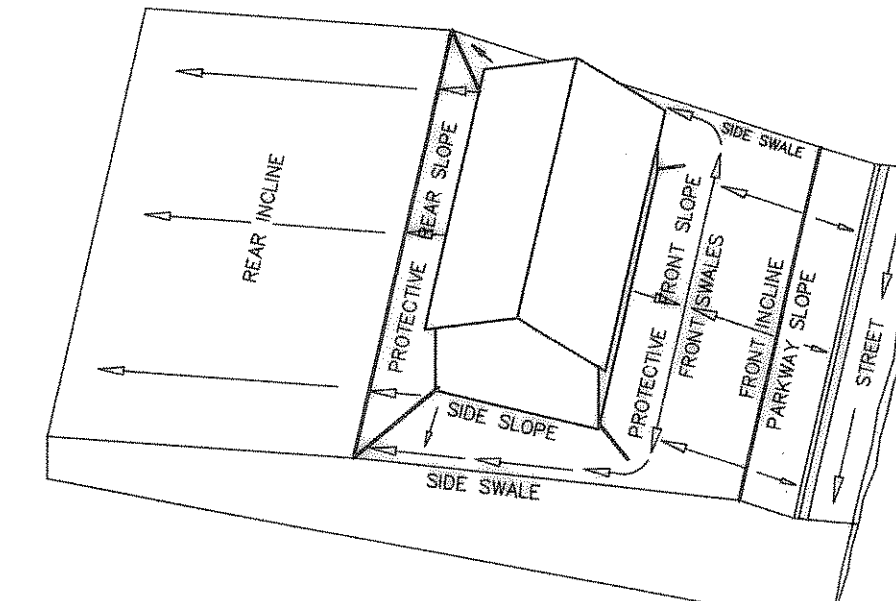

LOT GRADING TYPE C

