


- LEGEND**
- FP = FINISHED PAD
 - FF = FINISHED FLOOR
 - TW = TOP OF WALL
 - BW = BOTTOM OF WALL
 - EW = END OF WALL
 - 570 EXISTING CONTOURS
 - 560 PROP. CONTOURS
 - 61.5 SPOT GRADE
 - FLOW ARROWS
 - D.E. = DRAINAGE EASEMENT
 - PROPOSED 100YR FLOODPLAIN BOUNDARY
 - WS = PROP. 100YR FLOOD WATER SURFACE ELEVATION
 - 11+85 CROSS-SECTION NUMBER

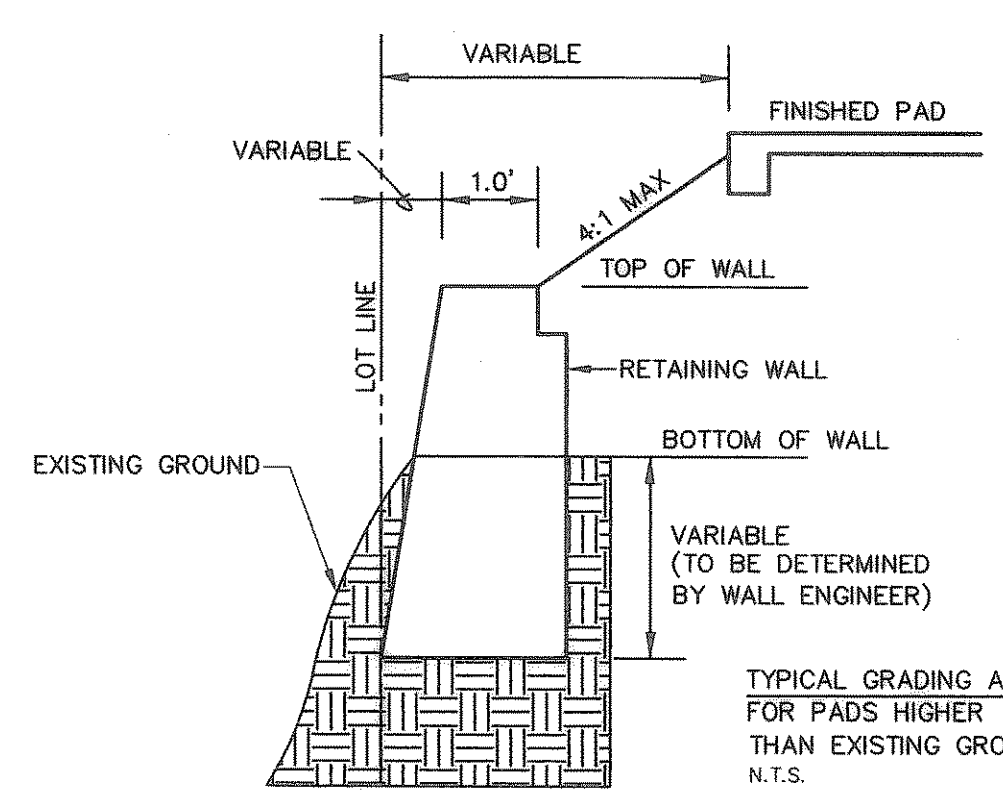

NOTE:
TABULAR STEEL FENCE TO BE INSTALLED
AT THE TOP OF WALL ADJACENT
TO CREEK WITH THE SITE WORK

NOTE:
ALL FILL TO BE COMPACTED
WITH SHEEPS FOOT ROLLER

Winkelmann & Associates, Inc. hereby states that this plan, to the best of our knowledge is "As Built." Modifications from the originally approved construction documents have been made as per information provided by the contractor. Winkelmann & Associates, Inc. does not certify as to the correctness or quality of construction as no field inspection was performed.

W. Naimuddin 5/14/04
WINKELMANN & ASSOCIATES, INC. DATE

APPROV.	
REVISION	
NO.	DATE


THESE CONSTRUCTION PLANS WERE PREPARED UNDER THE RESPONSIBLE SUPERVISION OF M.D. NAIM UDDIN KHAN, REGISTERED PROFESSIONAL ENGINEER NO. 87776

MD. NAIM UDDIN KHAN 9/4/03

THE SEAL APPEARING ON THIS DOCUMENT WAS AUTHORIZED BY M.D. NAIM UDDIN KHAN, # 87776

W.H. BAIRD SURVEY, ABSTRACT NO. 25
CITY OF ROCKWALL
ROCKWALL COUNTY, TEXAS

CONTINENTAL HOMES
621 WEST COLLEGE STREET
GRAPEVINE, TEXAS 76051

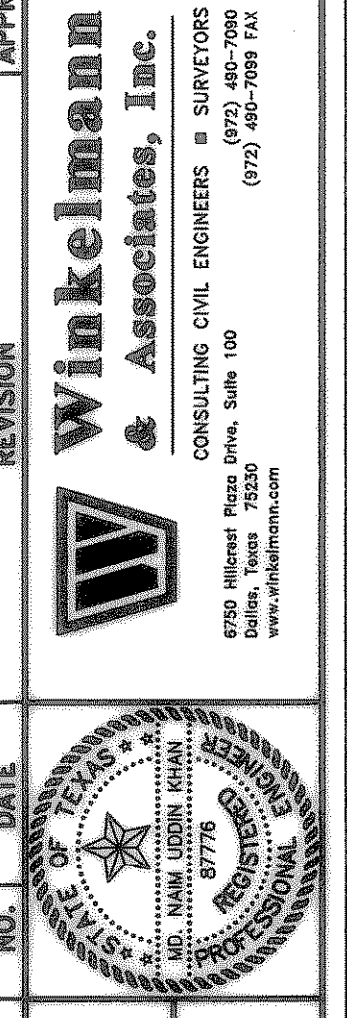

Winkelmann & Associates, Inc.
CONSULTING CIVIL ENGINEERS & SURVEYORS
6200 Hillcrest Plaza, Suite 100
Rockwall, Texas 75087
972-967-9200
www.winkelmann.com

LOT GRADING PLAN

Scale: 1"=40'
Designed By: RB
Drawn By: MK
Checked By: NK
File: 32004SALG3.DWG
Project No.: 32004-01

DATE: 09-04-03

BENCHMARK: ELEV. = 600.69
CITY OF ROCKWALL R-19
BRASS MONUMENT AT THE N/W CORNER OF
SILVERVIEW & DIAMOND WAY, 500' ± SOUTH OF
S.H. 276.

BENCHMARK: ELEV. = 583.56
R.R. SPIKE SET IN THE CENTERLINE OF S.H. 276
3600± WEST OF F.M. 549

SHEET 33 OF 35