


MATCHLINE: SEE IR-01
DETAIL A

MATCHLINE: SEE IR-03
DETAIL A

A STABLEGLEN DRIVE
SCALE: 1"=20'-0"

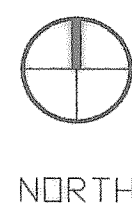

- LEGEND**
- RAINBIRD #1804 POP UP SPRAY HEAD WITH 8' MPR NOZZLE UNLESS NOTED OTHERWISE.
 - RAINBIRD #1804 POP UP SPRAY HEAD WITH MPR SERIES NOZZLE AS NOTED BELOW
 - ⊙ RAINBIRD PEB SERIES ELECTRIC REMOTE CONTROL VALVE
 - ▲ RAINBIRD #3RC QUICK COUPLING VALVE
 - ⊞ FEBCO 850 1 1/2" D.C.A. INSTALLED PER CITY CODE
 - 1 1/2" IRRIGATION WATER METER AND TAP
 - RAINBIRD ESP-LX SERIES AUTOMATIC CONTROLLER WITH PENN A-19 FREEZE SENSOR AND MINI-CLICK RAIN SENSOR
 - CLASS 200 PVC MAINLINE PIPE
 - CLASS 200 (EXCEPT 1/2 INCH #315) PVC LATERAL PIPE
 - == CLASS 200 SLEEVE PIPES

L.I.C. SHALL SELECT MPR SERIES SPRAY NOZZLES FOR "HEAD-TO-HEAD" COVERAGE, ADJUSTED FOR MINIMUM OVERSPRAY ONTO WALLS AND WALKS. NO OVERSPRAY INTO STREETS IS PERMITTED.

ALL IRRIGATION METERS SHALL HAVE DOUBLE CHECK VALVES AND BACKFLOW PREVENTORS.

IF CITY NEEDS TO WORK IN R.O.W. IRRIGATION SYSTEM TO BE REMOVED AND REPLACED BY OWNER OR H.O.A. AT NO COST TO CITY.

**Ironwood
Design Group**

Landscape Architecture
Land Planning

302 Brookside Drive
Grapevine, Texas 76051


Grapevine Office
(Ph.) 817-329-7643
(Fax) 817-488-5833

These Drawings and Specifications are to be an instrument of service and shall remain the property of the Ironwood Design Group. They are not to be used on other projects or extensions to this project except by agreement in writing from the Ironwood Design Group. Ironwood Design Group is not responsible for construction means, methods, sequence or procedures, or for safety precautions and programs in connection with the project.

**LOFLAND FARMS
PHASE 5A
ROCKWALL, TEXAS**
**CONTINENTAL HOMES
621 WEST COLLEGE STREET
GRAPEVINE, TEXAS**

Project Number:	
Drawn By:	JBP
Checked By:	RGB
Issue Date:	11-04-02
Scale:	1"=20'-0"
Revisions	

AS-BUILT

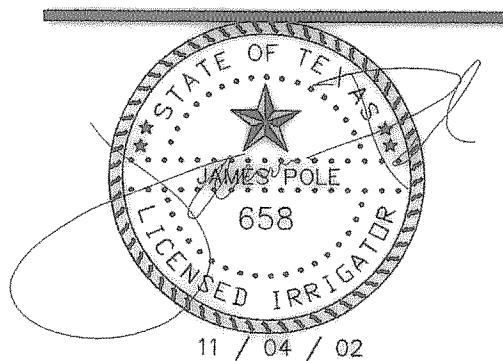

IRRIGATION PLAN

James Pole
LANDSCAPE IRRIGATION SPECIALIST
CONSULTING, DESIGN, SPECIFICATIONS
TEXAS LICENSED IRRIGATOR #658

2815 WOODHAVEN
DENTON, TEXAS 76209

PHONE: 940.243.2364

Sheet Number

IR-02