

Ironwood Design Group


Landscape Architecture
Land Planning

302 Brookside Drive Grapevine, Texas 76051

Grapevine Office (Ph.) 817-329-7643 (Fax) 817-488-5833

Issue Date: 11-04-02 Scale: 1"=20'-0"

AS-BUILT

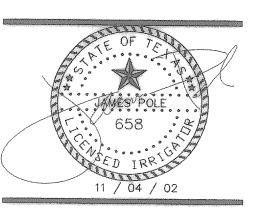

IRRIGATION PLAN

IR-03

SCALE: 1"=20'-0"

MATCHLINE: SEE BOTTOM LEFT

2615 WOODHAVEN DENTON, TEXAS 76209

PHONE: 940.243.2364

SCALE: 1"=20'-0"

NORTH