


STABLEGLEN DRIVE


SCALE: 1"=20'-0"


MATCHLINE: SEE IR-03

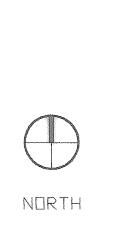


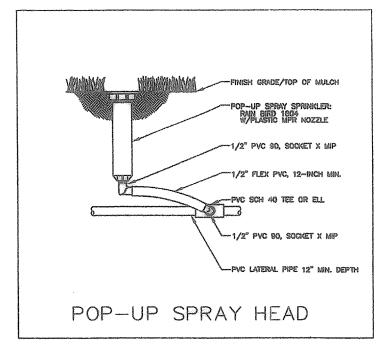


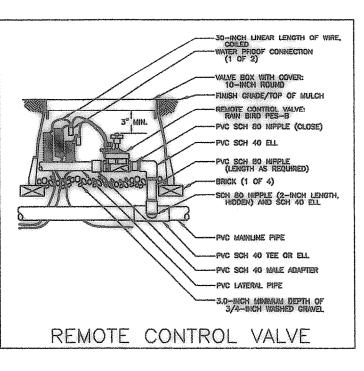

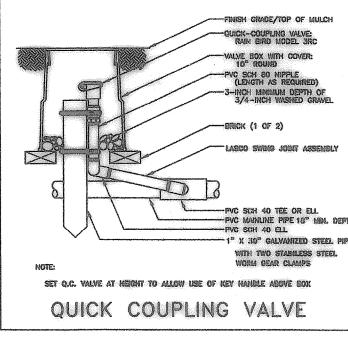

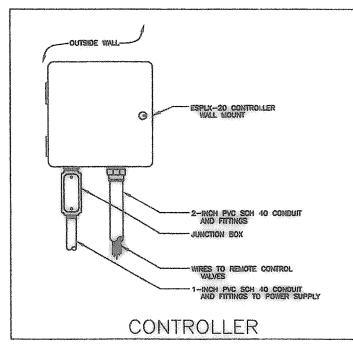

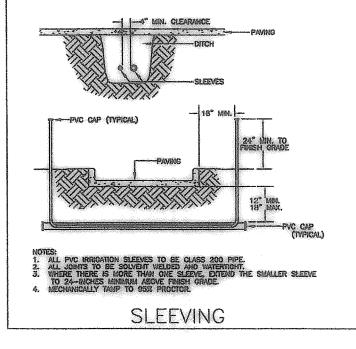

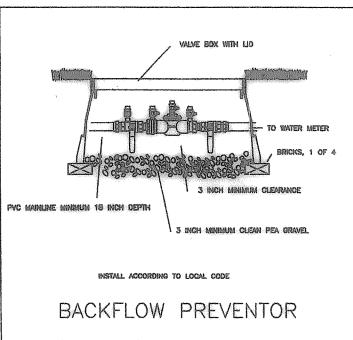


## INSTALLATION NOTES

- 1. COORDINATE IRRIGATION INSTALLATION WITH PLANTING PLAN AND SITE CONDITIONS TO PROVIDE COMPLETE COVERAGE WITH MINIMUM OVERSPRAY. THE IRRIGATION CONTRACTOR SHALL MAKE MINOR ADJUSTMENTS TO ENSURE PROPER COVERAGE AT NO ADDITIONAL COST TO THE OWNER.
- 2. CONFIRM STATIC WATER PRESSURE OF 60 PSI AT LEAST 7 DAYS BEFORE BEGINNING WORK. IF STATIC WATER PRESSURE IS LESS THAN STATED ABOVE, DO NOT PROCEED UNTIL DIRECTED SO BY THE LANDSCAPE ARCH.
- 3. THE IRRIGATION CONTRACTOR WILL SECURE ALL REQUIRED PERMITS AND PAY ALL ASSOCIATED FEES UNLESS OTHERWISE NOTED. ALL LOCAL CODES SHALL PREVAIL OVER ANY DISCREPANCIES HEREIN.
- 4. LATERAL PIPE SHALL BE INSTALLED AT A MINIMUM DEPTH OF 12 INCHES. MAINLINE PIPE AND WIRES SHALL BE INSTALLED AT A MINIMUM DEPTH OF 18 INCHES.
- 5. UNSLEEVED PIPES MAY BE SHOWN UNDER PAVEMENT FOR GRAPHIC CLARITY ONLY. INSTALL THESE PIPES IN ADJACENT LANDSCAPED AREAS.
- 6. COMPLETE ELECTRIC SERVICE TO THE CONTROLLER SHALL BE PROVIDED BY THE IRRIGATION CONTRACTOR. COORDINATE WITH THE LOCAL ELECTRIC UTILITY PROVIDER
- 7. 24 VOLT VALVE WIRE SHALL BE A MINIMUM OF #14 GAUGE, U.F. APPROVED FOR DIRECT BURIAL, SINGLE CONDUCTOR "IRRIGATION WIRE". WIRE SPLICES SHALL BE ENCASED IN A WATERPROOF COMPOUND OR GEL. ALL FIELD SPLICES SHALL BE LOCATED IN A ROUND VALVE BOX OF SUFFICIENT SIZE TO ALLOW INSPECTION.
- 8. VALVE BOXES SHALL BE INSTALLED FLUSH WITH GRADE, SUPPORTED BY BRICKS IF NEEDED, WITH 3 INCHES OF CLEAN PEA GRAVEL LOCATED BELOW THE VALVE. USE 10" ROUND VALVE BOXES FOR ELECTRIC VALVES AND QUICK COUPLING VALVES UNLESS NOTED OTHERWISE. D.C.A. SHALL BE BOXED ACCORDING TO LOCAL CODES.
- 9. USE LASCO O-RING SWING JOINT ASSEMBLIES TO CONNECT ALL ROTARY HEADS AND QUICK COUPLERS.
- 10. ALL SPRAY HEADS SHALL BE CONNECTED WITH A 12" MINIMUM LENGTH OF 1/2" FLEX PVC. THE FLEX PVC SHALL BE SOLVENT WELDED TO SCHEDULE 40 PVC FITTINGS WITH WELD-ON #795 SOLVENT AND #P-70 PRIMER.
- 11. PROVIDE TWO QUICK COUPLER KEYS WITH SWIVEL HOSE ELLS.
- 12. CONTRACTOR IS TO CONTACT APPROPRIATE AUTHORITIES AND LOCATE ALL UTILITIES PRIOR TO CONSTRUCTION.


## LEGEND

- RAINBIRD #1804 POP UP SPRAY HEAD WITH 8' MPR NOZZLE UNLESS NOTED OTHERWISE.
- RAINBIRD #1804 POP UP SPRAY HEAD WITH MPR SERIES NOZZLE AS NOTED BELOW
- RAINBIRD PEB SERIES ELECTRIC REMOTE CONTROL VALVE
- RAINBIRD #3RC QUICK COUPLING VALVE
- FEBCO 850 1 1/2" D.C.A. INSTALLED PER CITY CODE
- 1 1/2" IRRIGATION WATER METER AND TAP
- RAINBIRD ESP-LX SERIES AUTOMATIC CONTROLLER WITH
- PENN A-19 FREEZE SENSOR AND MINI-CLICK RAIN SENSOR
- CLASS 200 PVC MAINLINE PIPE CLASS 200 ( EXCEPT 1/2 INCH #315 ) PVC LATERAL PIPE
- = = CLASS 200 SLEEVE PIPES


L.I.C. SHALL SELECT MPR SERIES SPRAY NOZZLES FOR "HEAD-TO-HEAD" COVERAGE, ADJUSTED FOR MINIMUM OVERSPRAY ONTO WALLS AND WALKS. NO OVERSPRAY INTO STREETS IS PERMITTED.

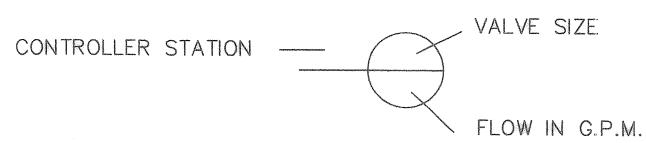

ALL IRRIGATION METERS SHALL HAVE DOUBLE CHECK VALVES AND BACKFLOW PREVENTORS.

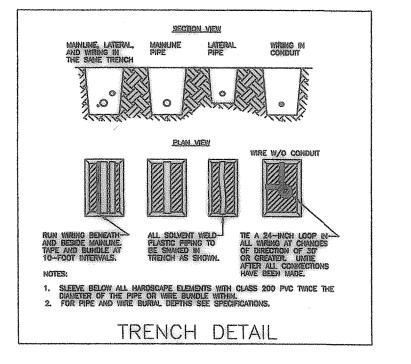

IF CITY NEEDS TO WORK IN R.O.W. IRRIGATION SYSTEM TO BE REMOVED AND REPLACED BY OWNER OR H.O.A. AT NO COST TO CITY.

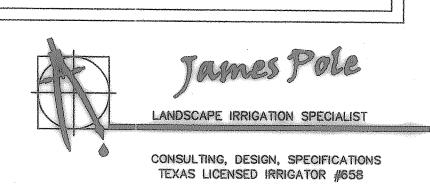

2615 WOODHAVEN DENTON, TEXAS 76209

PHONE: 940.243.2364

Ironwood

Landscape Architecture Land Planning


302 Brookside Drive Grapevine, Texas 76051

> <u>Grapevine Office</u> (Ph.) 817-329-7643 (Fax) 817-488-5833

CONTENENT

Project Number: Checked By: RGB Issue Date: 11-04-02 Scale: 1"=20'-0"



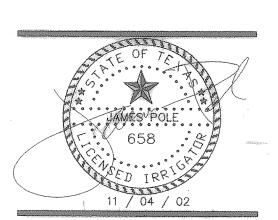

IRRIGATION PLAN

Sheet Number

IR-04