




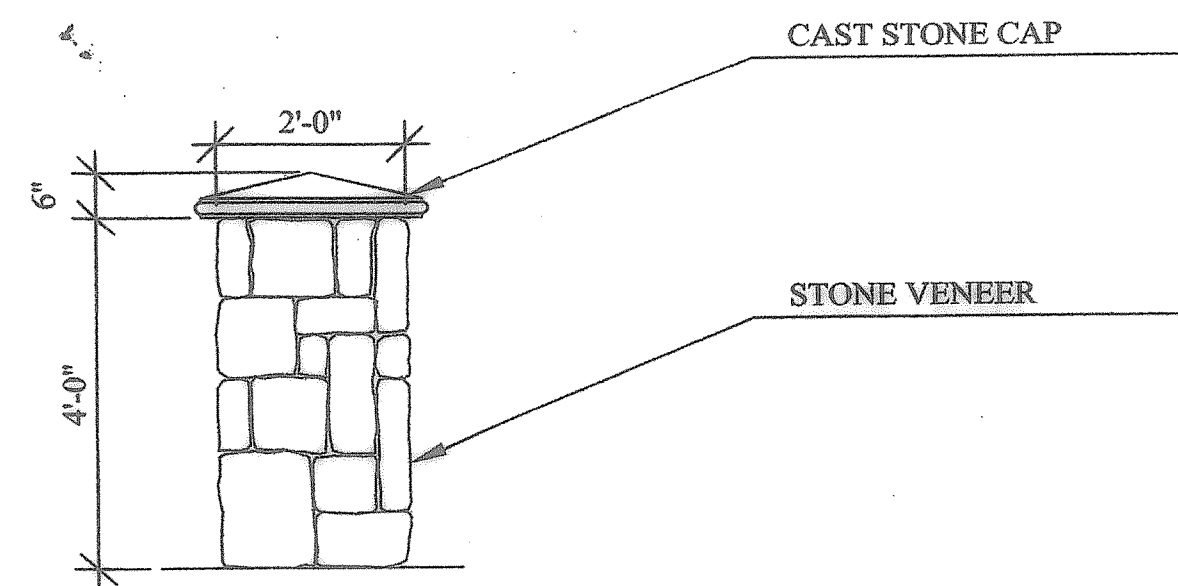


A ENHANCED COLUMN
SCALE: 1/2"=1'-0"

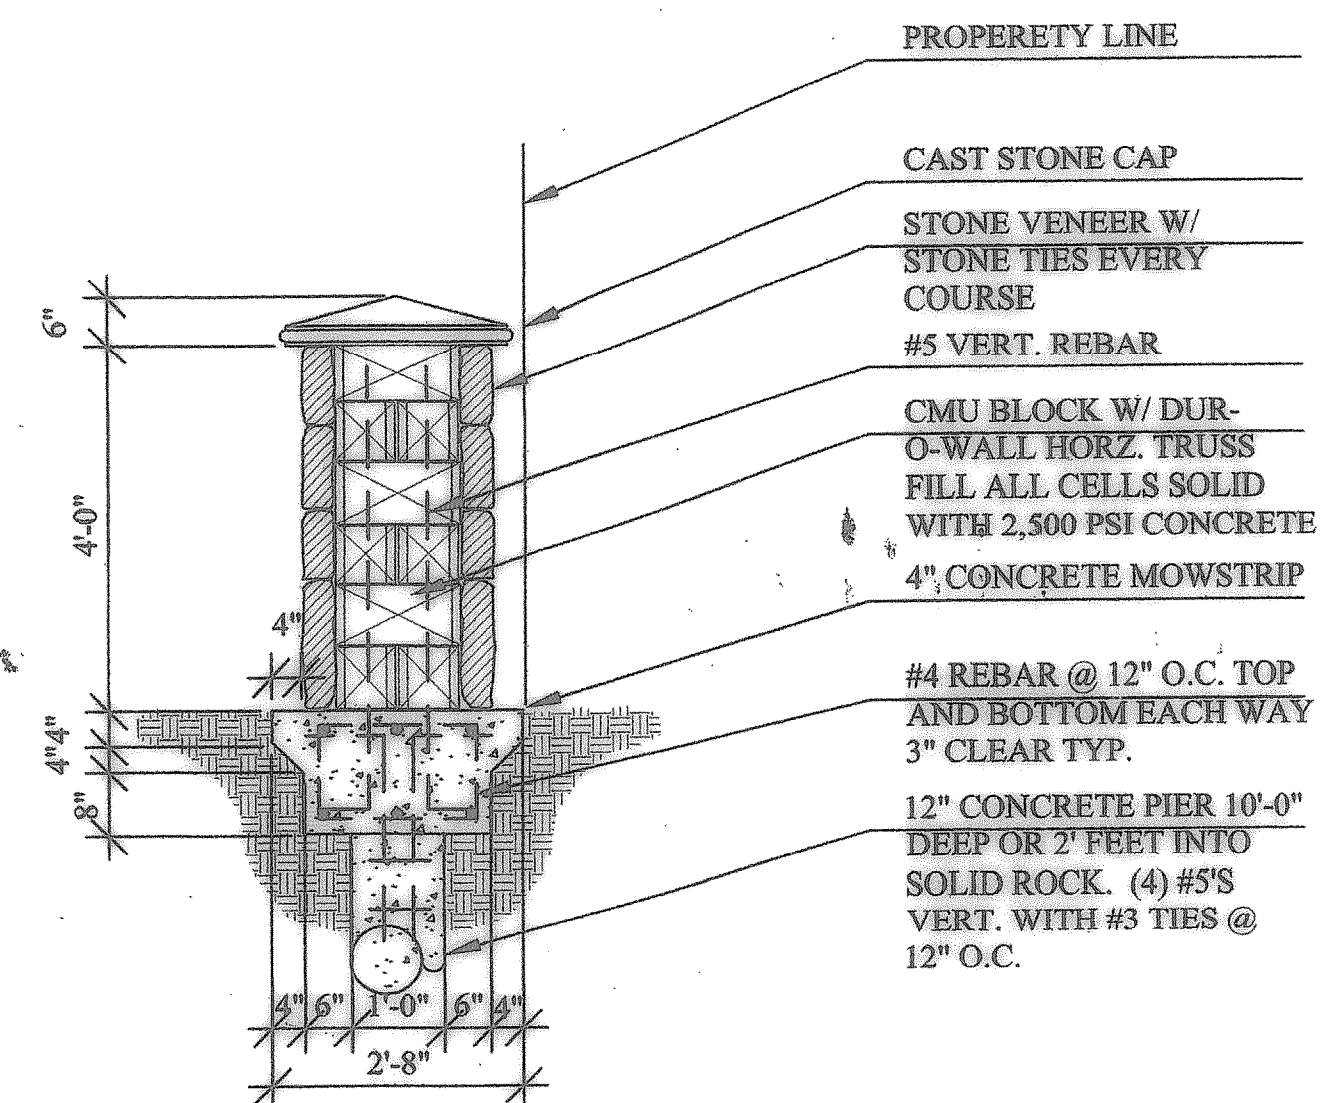

B ENHANCED COLUMN
SCALE: 1/2"=1'-0"

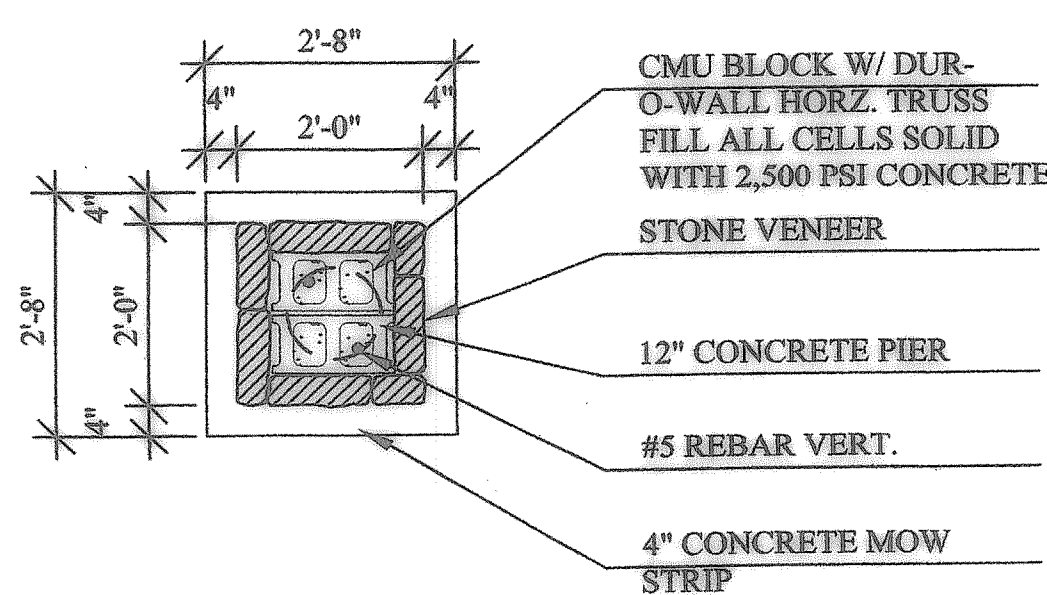

C ENHANCED COLUMN
SCALE: 1/2"=1'-0"

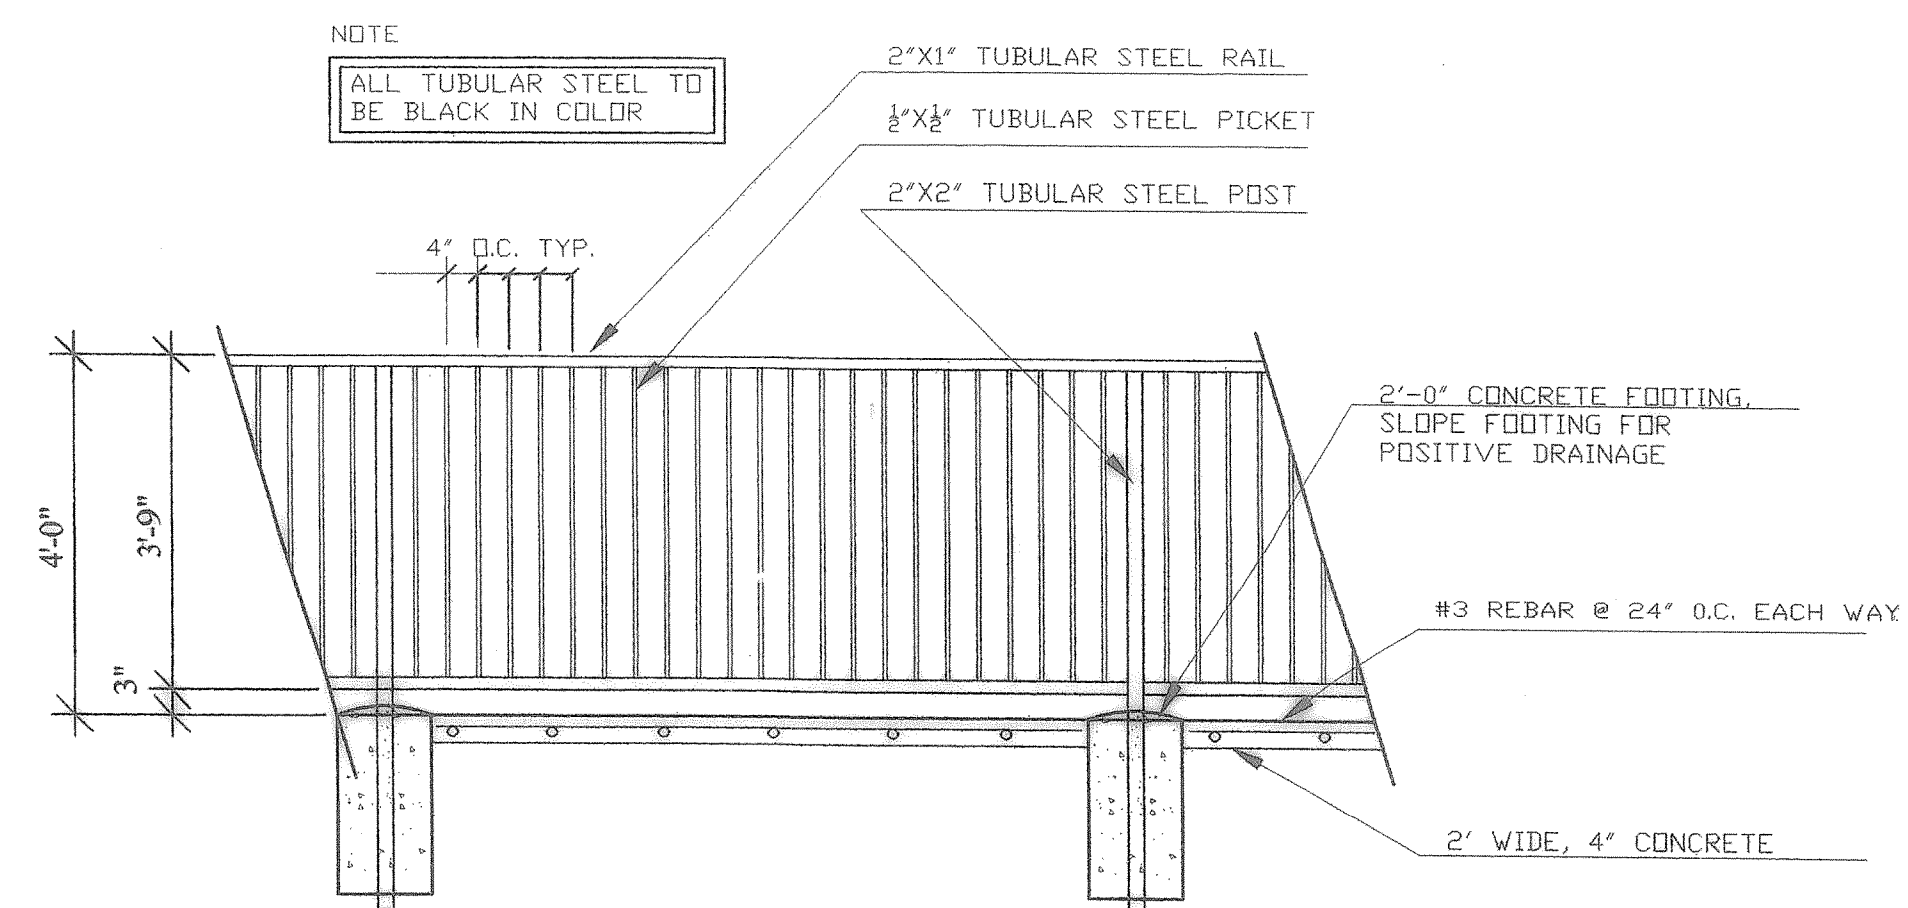

D TUBULAR STEEL FENCE
SCALE: 1/2"=1'-0"

**Ironwood
Design Group**

Landscape Architecture
Land Planning

302 Brookside Drive
Grapevine, Texas 76051

Grapevine Office
(Ph.) 817-329-7643
(Fax) 817-488-5833


These Drawings and Specifications are to be an instrument of service and shall remain the property of the Ironwood Design Group. They are not to be used on other projects or extensions to this project except by agreement in writing from the Ironwood Design Group. Ironwood Design Group is not responsible for construction means, methods, sequence or procedures, or for safety precautions and programs in connection with the project.

LOFLAND FARMS
PHASE 5A

GRAPEVINE, TEXAS

CONTINENTAL HOMES
621 W. COLLEGE ST.
ROCKWALL, TEXAS

Project Number:	
Drawn By:	R.G.B.
Checked By:	R.G.B.
Issue Date:	06/24/02
Scale:	
Revisions	

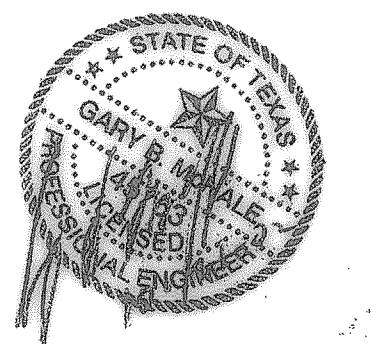

AS-BUILT

CON. PLAN

Sheet Number

LC-011