


Landscape Plans For: *Lofland Farms Phase 5A*

Rockwall, Texas


06/24/02

Revised April 20, 2003

Revised Oct. 15, 2003

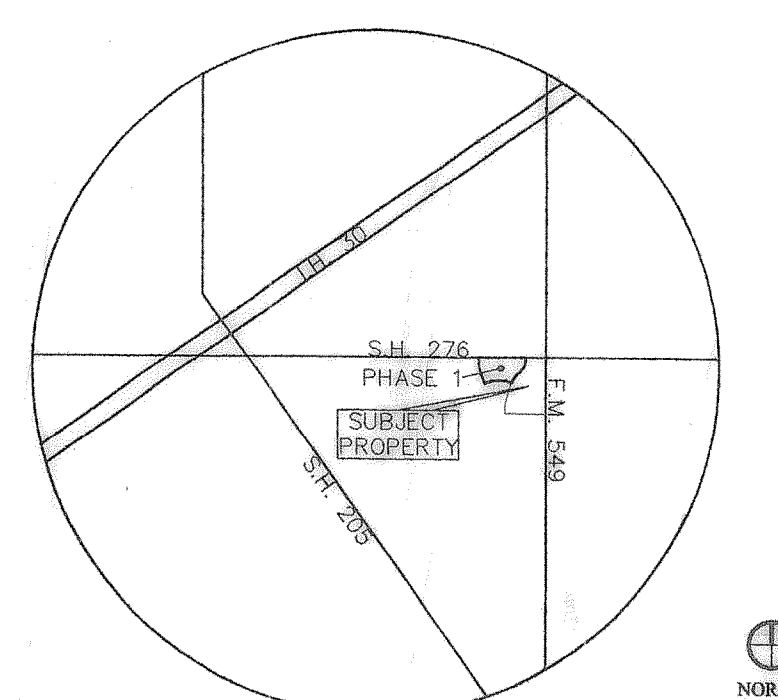

LOCATION MAP

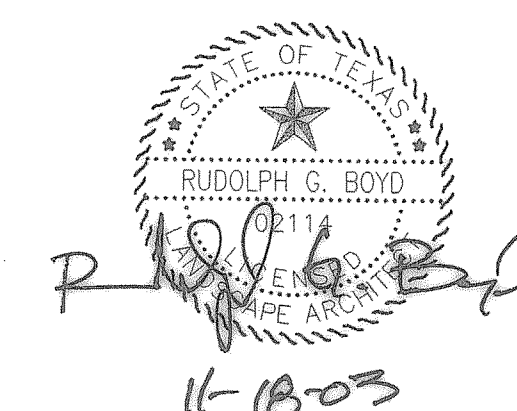

DEVELOPER


Continental Homes
621 W. College St.
Grapevine, Texas 76051
(817) 481-7750

CONSULTANTS

Landscape Architect:

Ironwood Design Group
302 Brookside Drive
Grapevine, Texas 76051
Ph. (817) 329-7643
Fx. (817) 488-5833

Engineers:

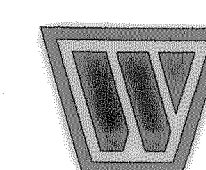

Winkelmann
& Associates, Inc.

CONSULTING CIVIL ENGINEERS ■ SURVEYORS
6750 HILLCREST PLAZA DRIVE, SUITE 100 (972) 490-7090
DALLAS, TEXAS 75230 (972) 490-7099 FAX

SHEET INDEX

CV-01	COVER SHEET
PL-01	PLANTING PLANS
PL-02	PLANTING PLANS
PL-03	PLANTING PLANS
PL-04	PLANTING PLANS
PL-05	PLANTING DETAILS
LC-01	CONSTRUCTION DETAILS
LC-02	CONSTRUCTION DETAILS
IR-01	IRRIGATION PLAN
IR-02	IRRIGATION PLAN
IR-03	IRRIGATION PLAN
IR-04	IRRIGATION PLAN AND DETAILS
	AS-BUILT