


Project Number:	
Drawn By:	RGB
Checked By:	B.R.
Issue Date:	06-24-02
Scale:	1"=20'-0"
Revisions	
10-20-03	



MATCHLINE: SEE PL-02 DETAIL A

A **STABLEGLEN DRIVE & STATE HIGHWAY 276 PLANTING PLAN**
SCALE: 1"=20'-0"

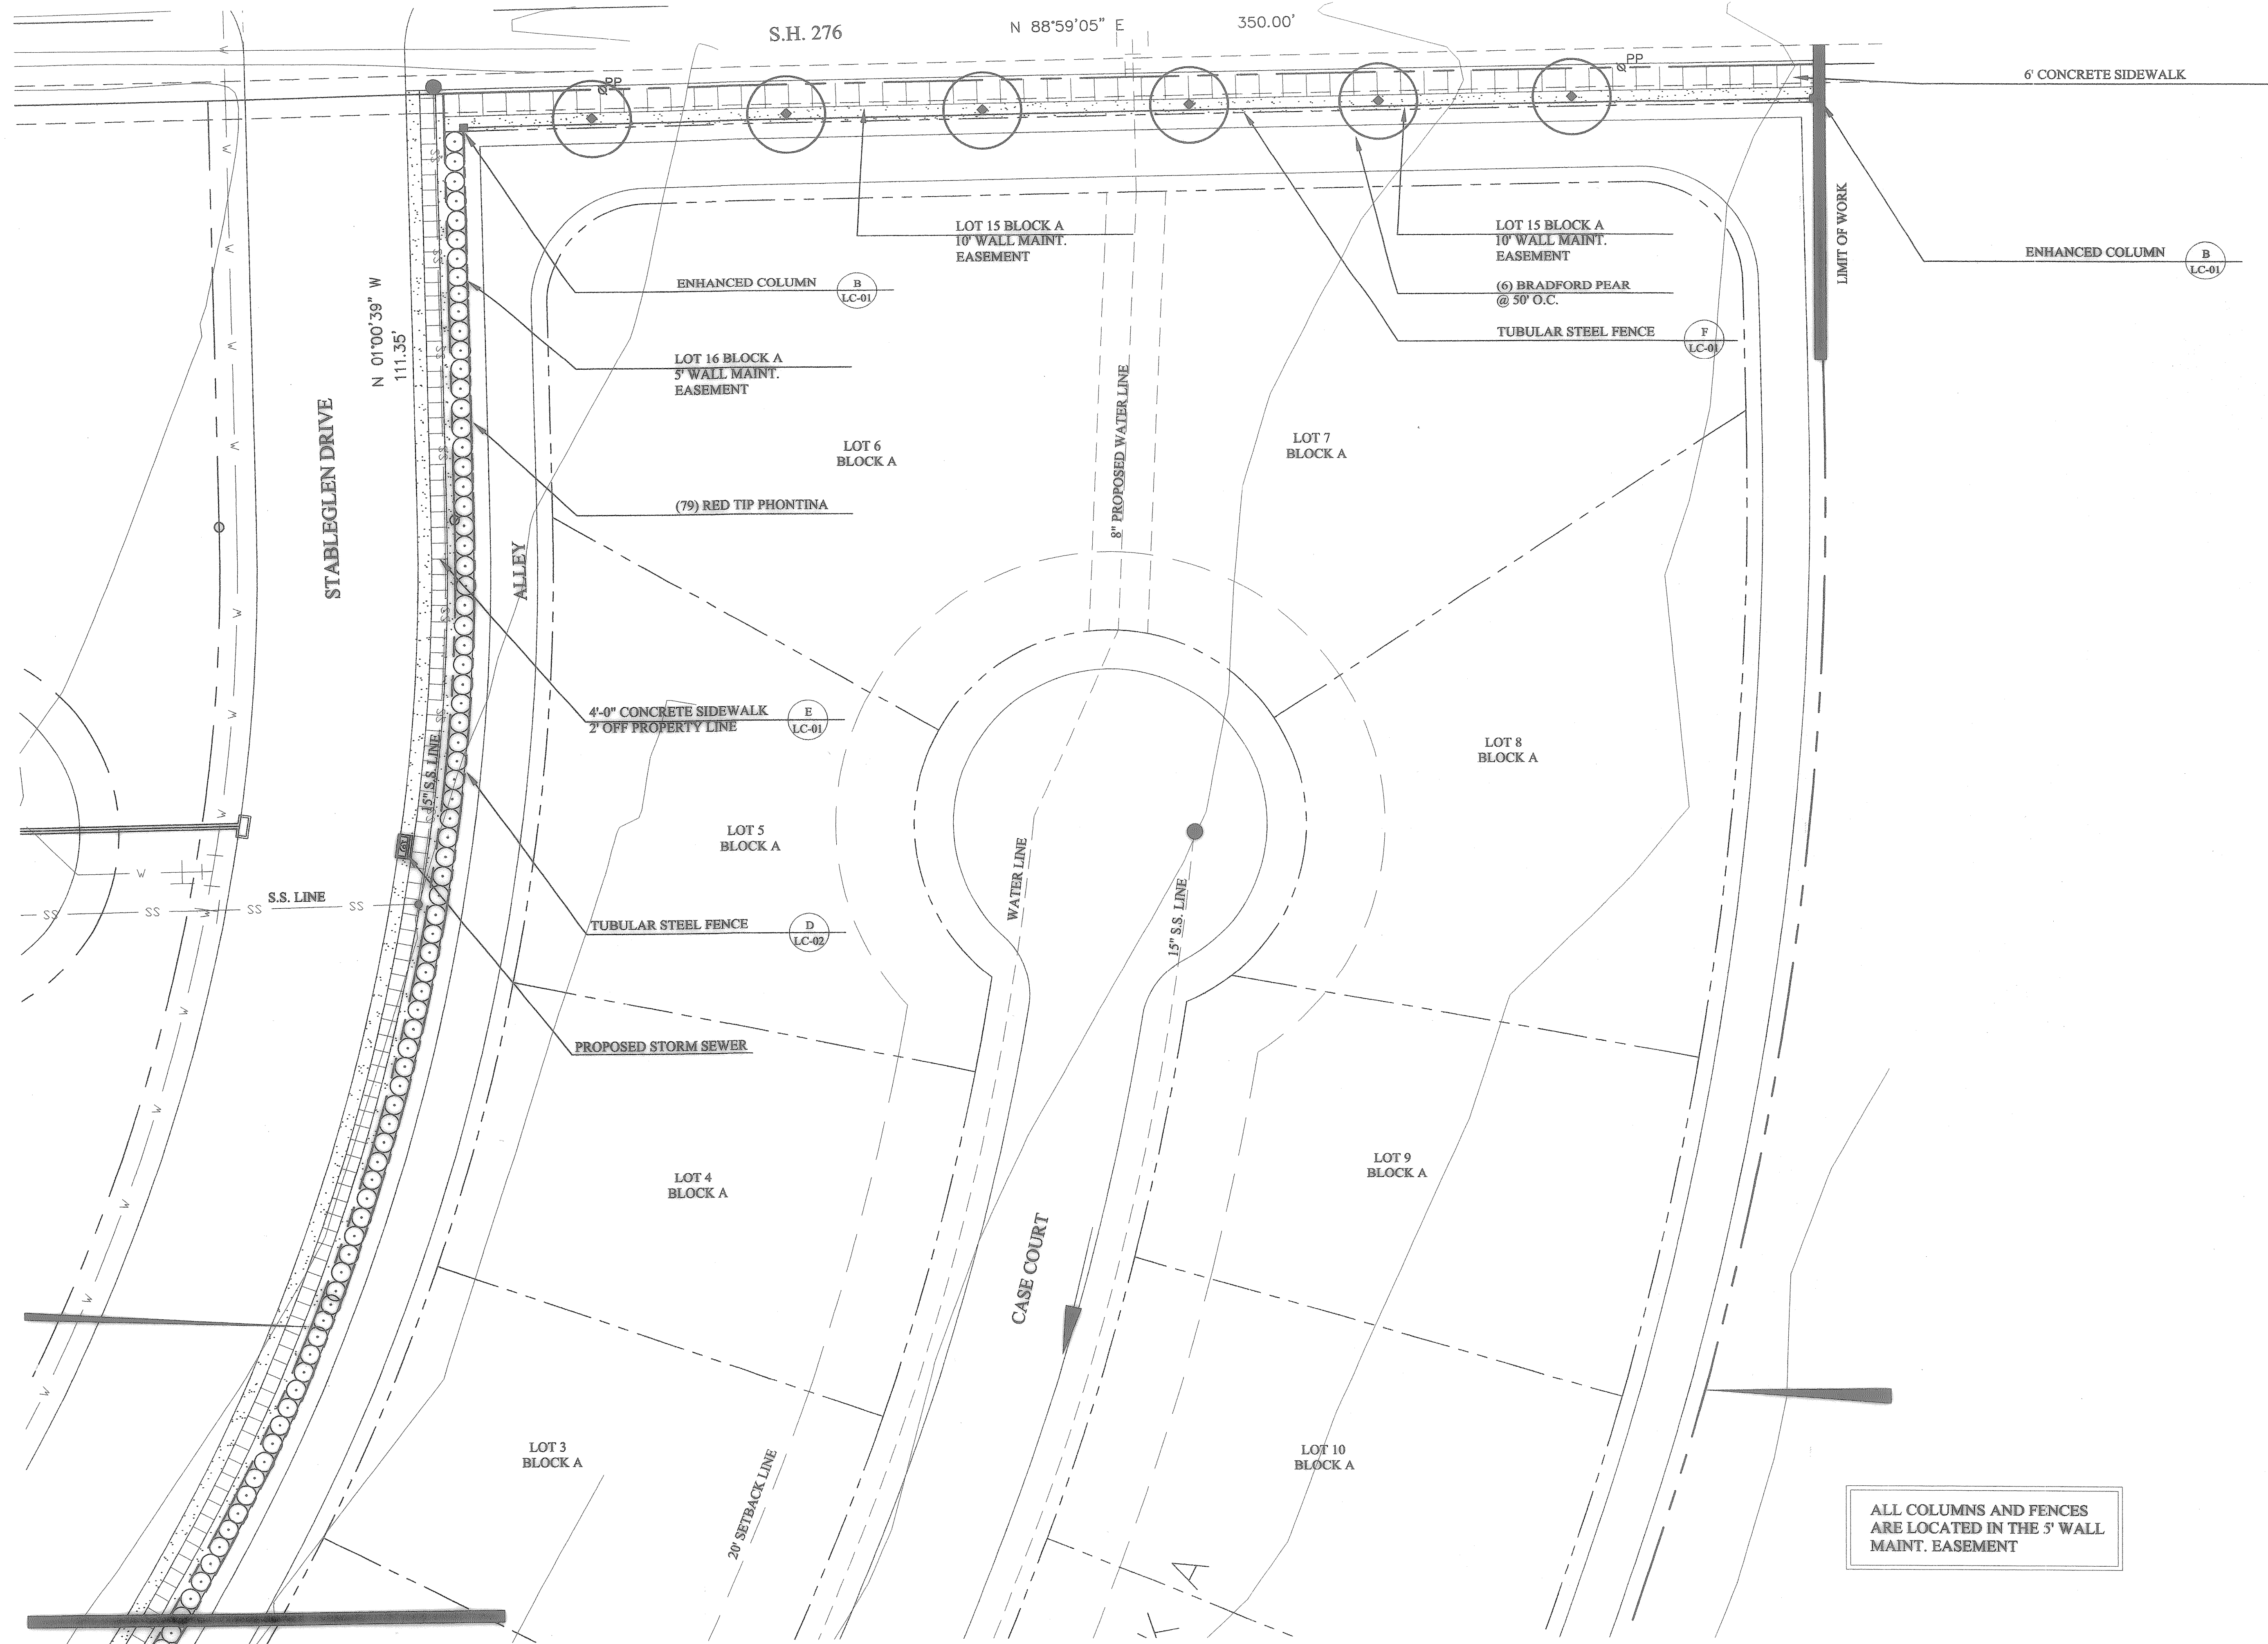

ALL COLUMNS AND FENCES
ARE LOCATED IN THE 5' WALL
MAINT. EASEMENT