


## A

## SHRUBS & GROUNDCOVERS PLANTING DETAIL

NOT TO SCALE

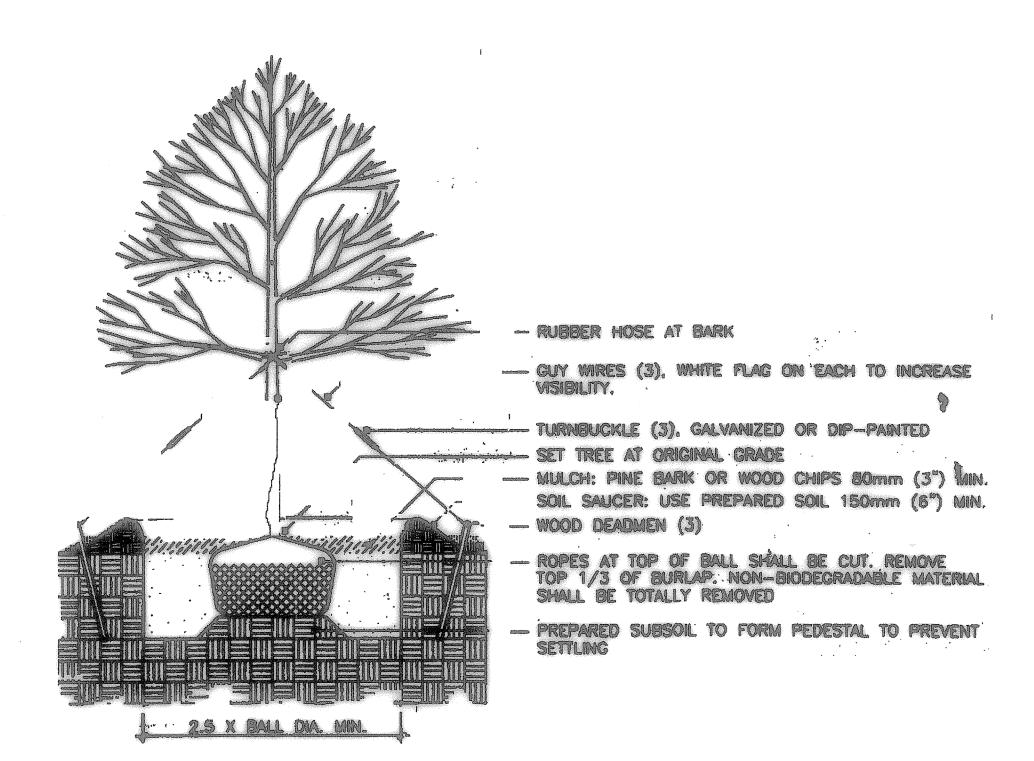

 $\widehat{\mathbb{R}}$ 

SHRUBS & GROUNDCOVERS PLANTING DETAIL

NOT TO SCALE

## PLANT LIST

| PLANT | PLANT<br>QUANTITY                       | COMMON NAME<br>BOTANICAL NAME                     | SIZE              |          |        |   |
|-------|---|---|-------------------|----------|--------|---|
|       | *************************************** | SHRUBS AND GROUNDCOVERS - INSTALL PER DETAILS     | NOTED IN COMMENTS | HEIGHT   | SPREAD |   |
|       | 390                                     | FRASER'S PHOTINIA<br>PHOTNIA X 'FRASERI'          | S<br>GAL.         | 36" MIN. |        | FULL, CONTAINER GROWN/ NON-ROOT BOUND HEALTH, PLANT @ 48" O.C.; |
|       | 7                                       | BRADFORD PEAR TREE<br>PYRUS CALLERYANA 'BRADFORD' | 3"<br>CAL.        | 12'      | 10'    | SINGLE STRAIGHT TRUNK, MATCHED PLANT @ 50' O.C.                 |
|       | 14,000 S.F.                             | BERMUDA GRASS HYDROMULCH<br>CYNODON DACTYLON      | MULCH<br>HYDRO-   |          |        | MIX AND APPLY AS PER MANUFACTURER'S SPEC.                       |

## Ironwood Design Group

Landscape Architecture
Land Planning

302 Brookside Drive Grapevine, Texas 76051

> Grapevine Office (Ph.) 817-329-7643 (Fax) 817-488-5833

These Drawings and Specifications are to be an instrument of service and shall remain the property of the Ironwood Design Group. They are not to be used on other projects or extensions to this project except by agreement in writing from the Ironwood Design Group. Ironwood Design Group is not responsible for construction means, methods, sequences or procedures, or for safety precautions and

PHASE 5A

Project Number:

Drawn By: R.G.B.


Checked By: B.R.

Issue Date: 06/24/02

Scale: NO SCALE

Revisions

**AS-BUILT** 

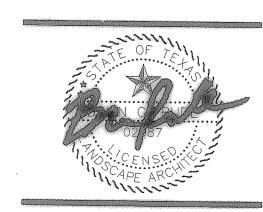

PLANTING DETAILS

Sheet Numbe

PL-05