

Grapevine Office
(Ph.) 817-329-7643
(Fax) 817-488-5833

These Drawings and Specifications are to be an instrument of service and shall remain the property of the Ironwood Design Group. They are not to be used on other projects or extensions to this project except by agreement in writing from the Ironwood Design Group. Ironwood Design Group is not responsible for construction means, methods, sequences or procedures, or for safety precautions and programs in connection with the project.


WEST COLLEGE STREET
GRAPEVINE, TEXAS

Project Number:	
Drawn By:	RGB
Checked By:	B.R.
Issue Date:	06-24-02
Scale:	1"=20'-0"
Revisions	
10/15/03	



PLANTING PLAN

PL-02

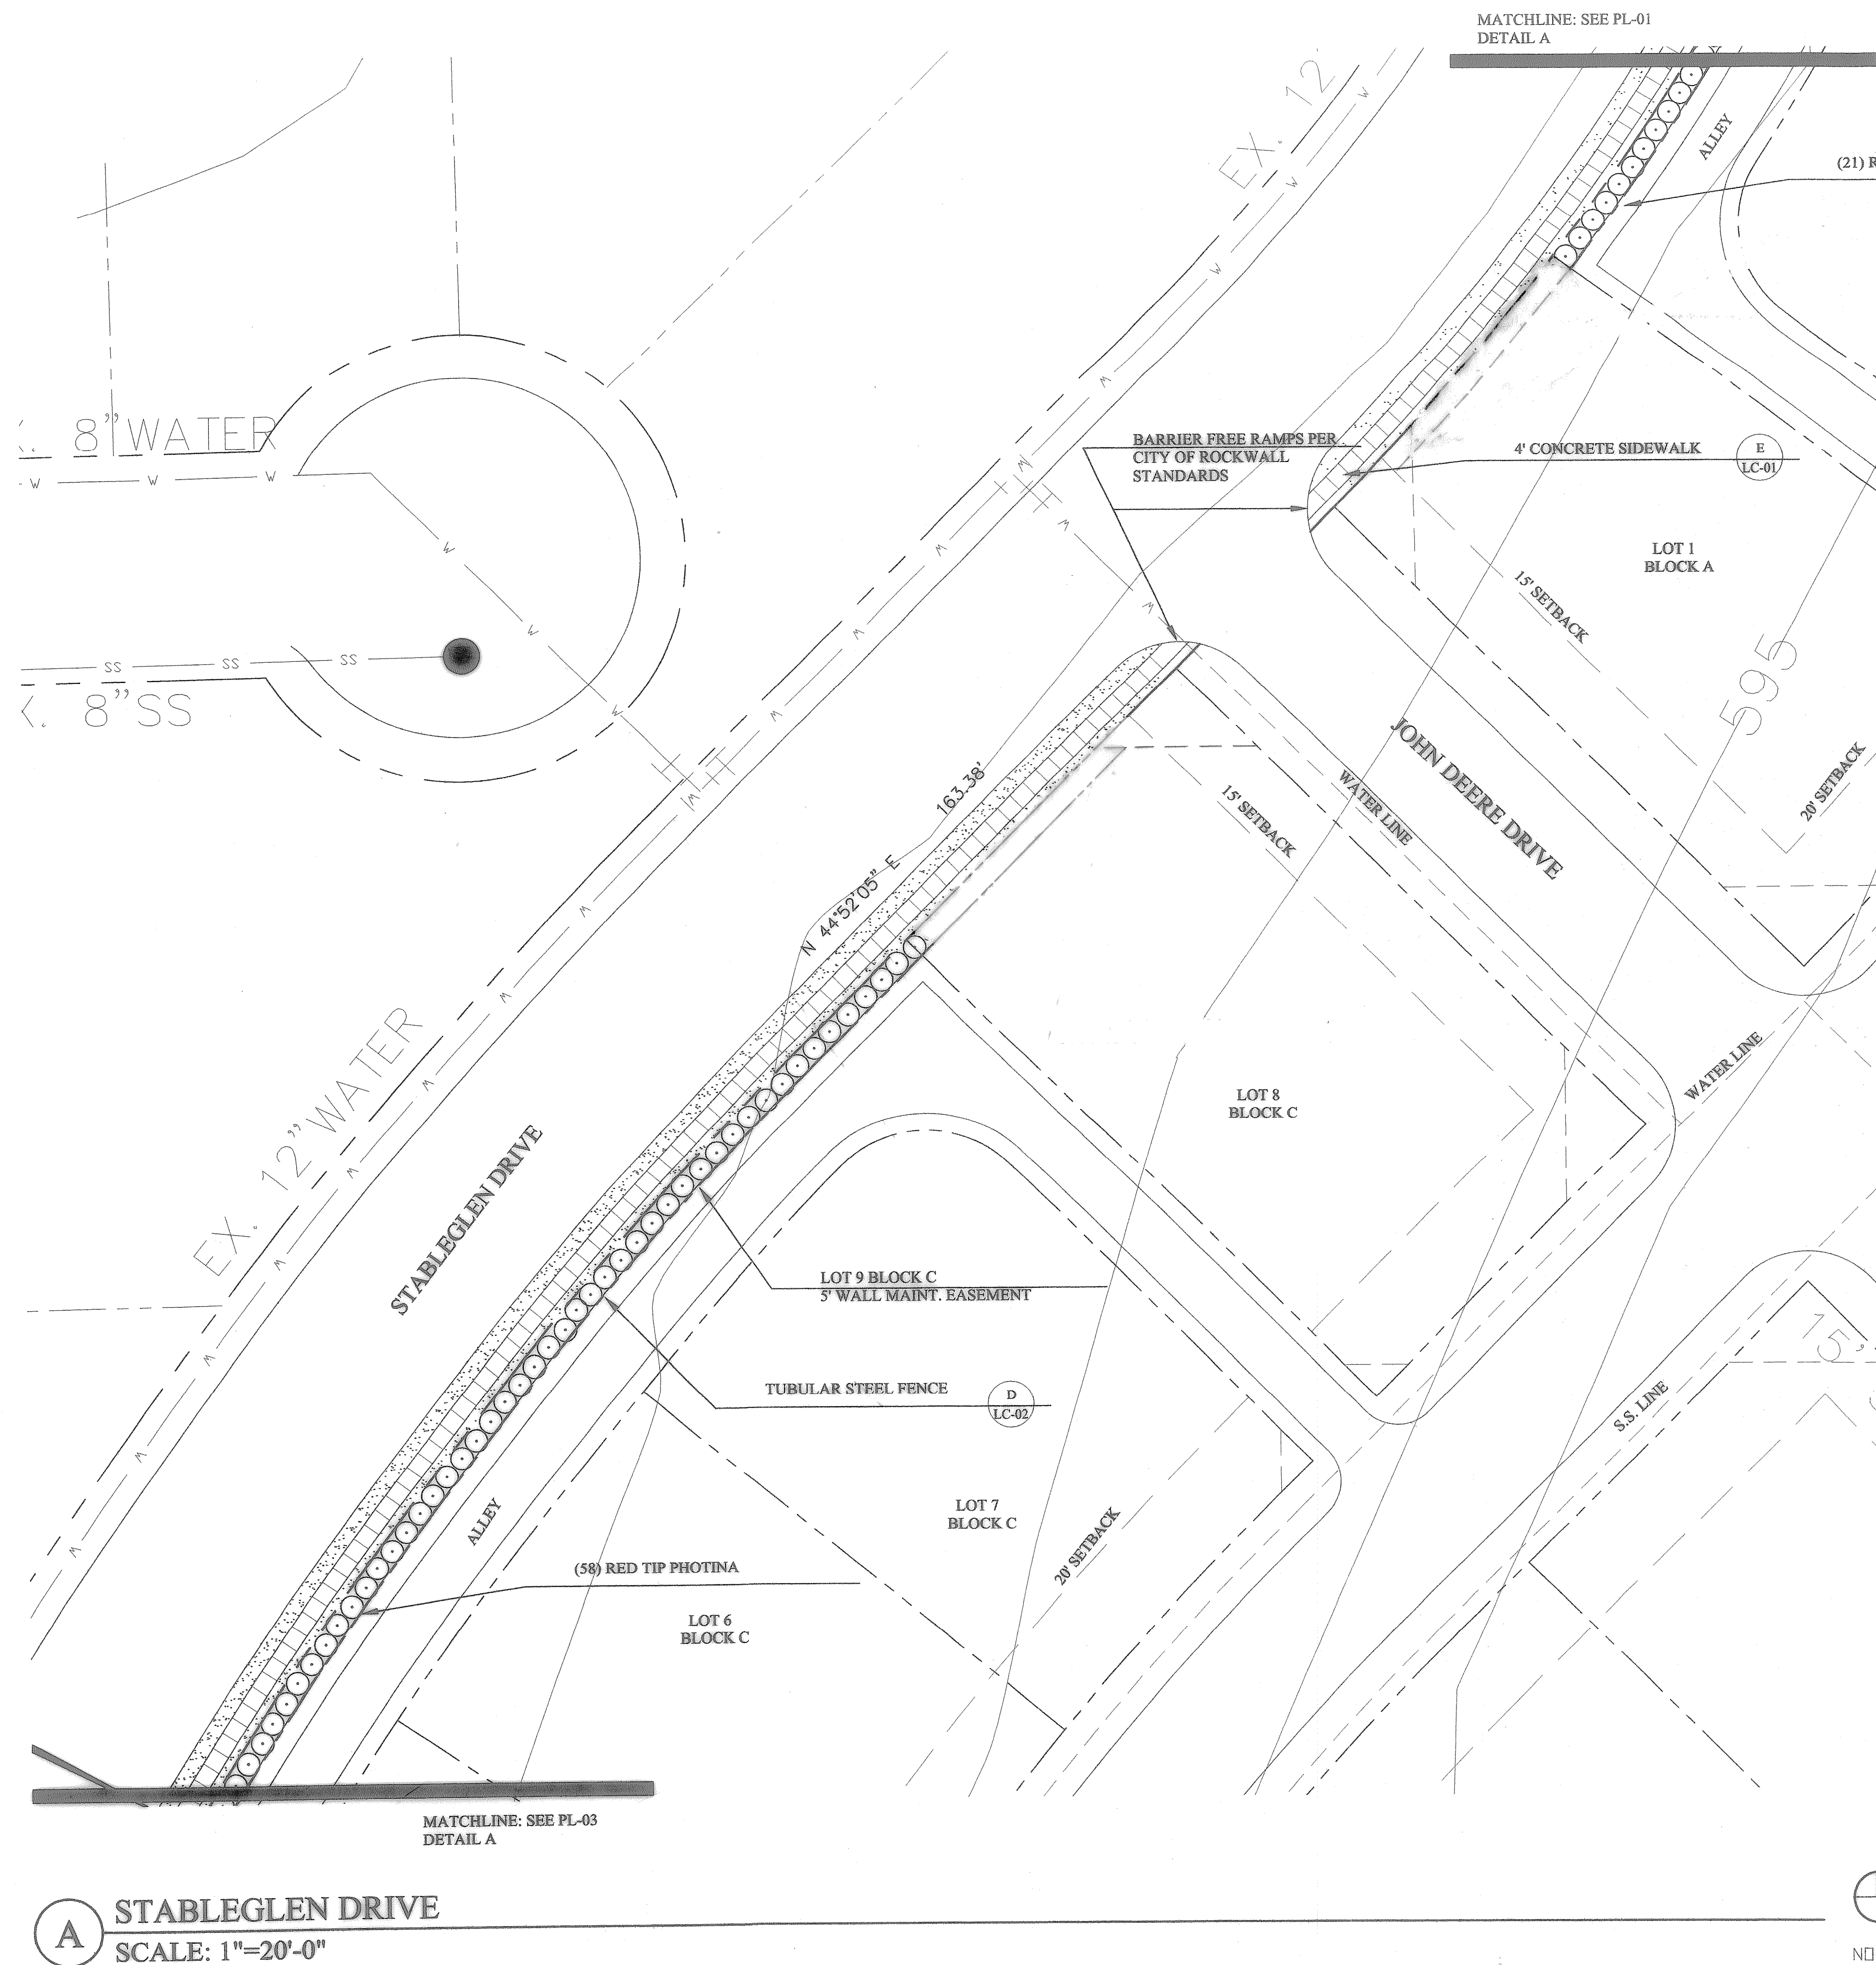

ALL COLUMNS AND FENCES
ARE LOCATED IN THE 5' WALL
MAINT. EASEMENT