
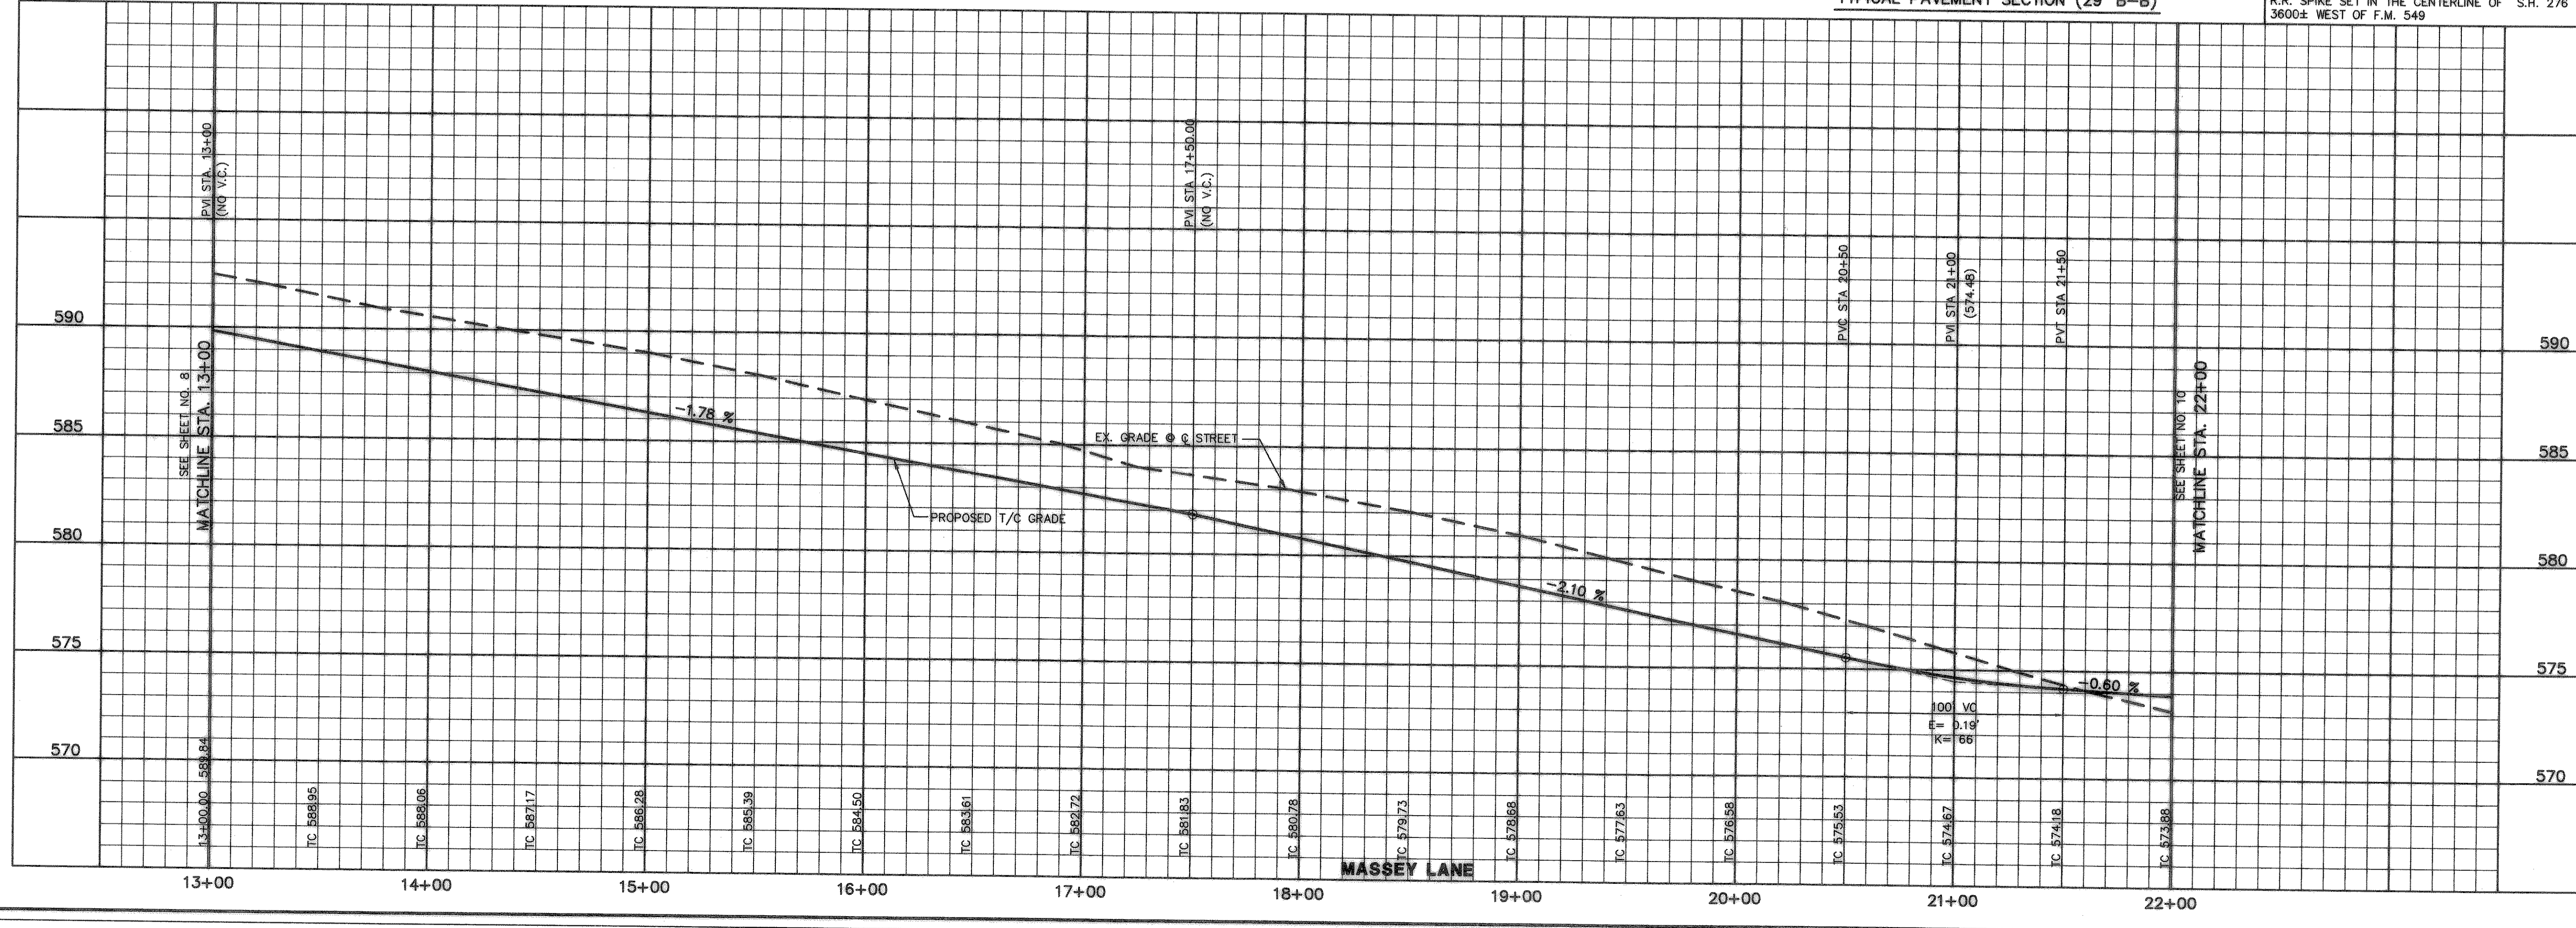


CURVE REPORT

CURVE	RADIUS	DELTA	TANGENT	LENGTH	CHORD	BEARING
C-23	36.00'	90°00'00"	36.00'	56.55'	50.91'	N43°12'49"E
C-24	36.00'	90°00'00"	36.00'	56.55'	50.91'	S46°47'11"E

LEGEND

TC	TOP OF CURB
TP	TOP OF PAVEMENT
CR	CURVE RETURN
FL	FLOW LINE
2	STREET STATION
1	HANDICAP RAMP @ STREET & STREET INTERSECTION
1	HANDICAP RAMP @ STREET & ALLEY INTERSECTION

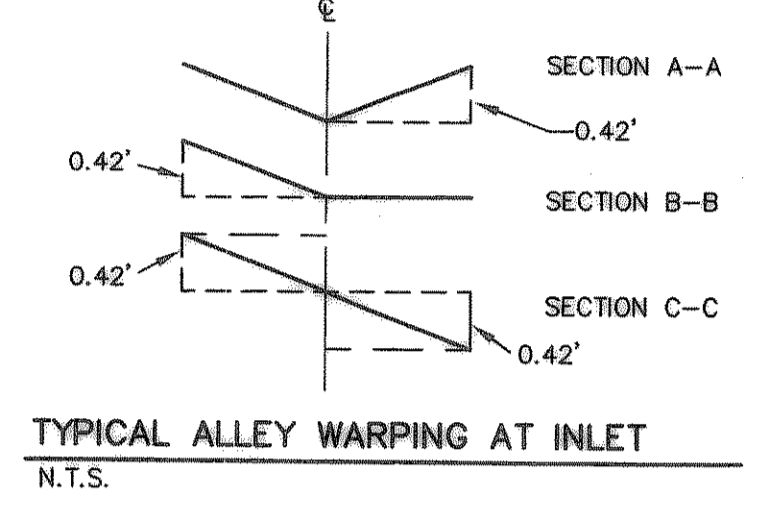

THESE CONSTRUCTION PLANS WERE PREPARED UNDER THE RESPONSIVE SUPERVISION OF M. NAM UDDIN KHAN, REGISTERED PROFESSIONAL ENGINEER NO. 87776

THE SEAL APPEARING ON THIS DOCUMENT WAS AUTHORIZED BY M.D. NAM UDDIN KHAN, # 87776

W.H. HANCOCK

LOPLAND FARMS, PHASE 5A
BAIRD SURVEY & CONSTRUCTION
ROCKWALL COUNTY, TEXAS

CONTINENTAL HOMES
621 WEST COLLEGE STREET
GRAPEVINE, TEXAS 76051

Winkelmann & Associates, Inc.
CONSULTING CIVIL ENGINEERS & SURVEYORS
6700 Hillcrest Plaza Drive, Suite 100
Rockwall, Texas 75087
(972) 980-7900
www.winkelmann.com

PAVING PLAN & PROFILE
MASSEY LANE
STA. 13+00 TO STA. 22+00
PAVING PLAN - ALLEY 3 STA. 8+50 TO 12+64.45
PAVING PLAN - ALLEY 4 STA. 0+00 TO 6+00

Scale: 1" = 40'
Date: 08-04-03
Designed By: RB
Drawn By: MS
Checked By: NK
File: 320045AP6.DWG View:
Project No.: 32004.01

SHEET
9
OF
35