

BENCHMARK: 5802 WEST OF F.H. 549
 ELEV. = 583.56
 BENCHMARK: CITY OF ROCKWALL P-19
 1905 WEST OF F.H. 549
 ELEV. = 600.69
 IN THE CORNER OF SILVERVIEW & DIAMOND WAYS, 500' ± SOUTH OF S.H. 276.



Scale: 1" = 40'
 Date: 09-04-03
 Designed By: RB
 Drawn By: NK
 Checked By: NK
 File: 320045AALDW6
 Project No.: 32004.01

ALLEY PAVING PROFILE
ALLEY 1 - STA. 0+00 TO STA. 16+76.78

THE SEAL APPEARING ON THIS DOCUMENT WAS AUTHORIZED BY MD. NAIM UDDIN KHAN, # 87776

THESE CONSTRUCTION PLANS WERE PREPARED UNDER THE CLOSE PERSONAL SUPERVISION OF MD. NAIM UDDIN KHAN, REGISTERED PROFESSIONAL ENGINEER NO. 87776

W.H. Baird & Associates, Inc.
 621 WEST COLLEGE STREET
 GRAPEVINE, TEXAS 76051

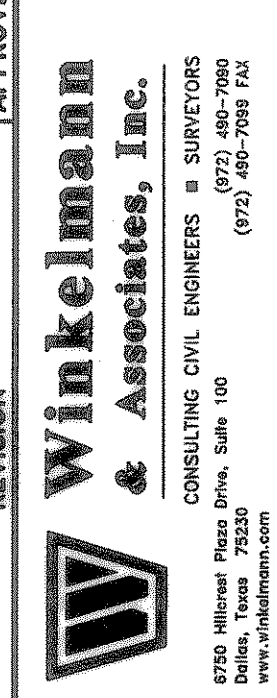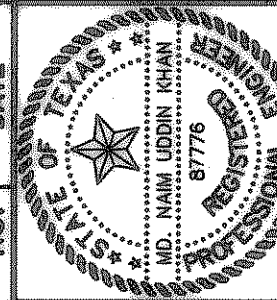

NO.	DATE	REVISION	APPROV.
1			