

BENCHMARK: ELEV. = 563.56
 ROCKWALL S-10
 56002 WEST OF F.H. 549

THE SEAL APPEARING ON THIS DOCUMENT WAS AUTHORIZED BY MD. NAIM UDDIN KHAN, # 87776


THESE CONSTRUCTION PLANS WERE PREPARED UNDER THE RESPONSIBLE SUPERVISION OF MD. NAIM UDDIN KHAN, REGISTERED PROFESSIONAL ENGINEER NO. 87776

NO.	DATE	REVISION	APPROV.
1	9/15/03		

Scale: 1" = 10'
 Designed By: MS
 Drawn By: MS
 Checked By: NK
 File: 320045A2.dwg View:
 Project No.: 32004.01

STORM SEWER PROFILES
LINE #1 & LINE #2

LOFLAND FARMS, PHASE 5A
 W.H. BAIRD CITY OF ROCKWALL, TEXAS
 CONTINENTAL HOMES
 621 WEST COLLEGE STREET
 GRAPEVINE, TEXAS 75051

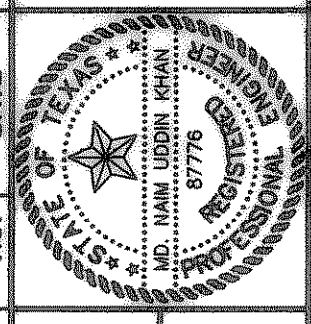

Winkelmann & Associates, Inc.
 CONSULTING CIVIL ENGINEERS & SURVEYORS
 6700 HILLCREST PLAZA, SUITE 100
 DALLAS, TEXAS 75205
 (972) 462-7000 FAX