

NO.	DATE	REVISION	APPROV.

THESE CONSTRUCTION PLANS WERE PREPARED UNDER THE RESPONSIBLE SUPERVISION OF M.D. NAIM UDDIN KHAN, REGISTERED PROFESSIONAL ENGINEER NO. 87776

MD. NAIM UDDIN KHAN 9/15/03

LOFLAND FARMS, PHASE 5A
SURVEY ABSTRACT NO. 25
ROCKWALL COUNTY, TEXAS
CONTINENTAL HOMES
621 WEST COLLEGE STREET
GRAPEVINE, TEXAS 76051

THE SEAL APPEARING ON THIS DOCUMENT WAS AUTHORIZED BY M.D. NAIM UDDIN KHAN, # 87776

WINKELMANN & ASSOCIATES, INC. 5/14/04

DATE

WINKELMANN & ASSOCIATES, INC.

DESIGNED BY: MS
DRAWN BY: MS
CHECKED BY: NK
FILE: 520045asp.dwg
VIEW: Project No.: 32004.01

DATE: 05-04-03


ELEV. = 600.69
CITY OF ROCKWALL R-19 BRASS MONUMENT AT THE N/W CORNER OF S.H. 276
NEW & DIMOND WAT. 500 ± SOUTH OF S.H. 276

ELEV. = 563.56
R.R. SPIKE SET IN THE CENTERLINE OF S.H. 276
3600E WEST OF F.M. 549

BENCHMARK: 563.56
R.R. SPIKE SET IN THE CENTERLINE OF S.H. 276
3600E WEST OF F.M. 549

STORM SEWER PROFILES
LINE '6', LINE '7', LINE '8' & LINE '9'

25 OF 35 SHEETS

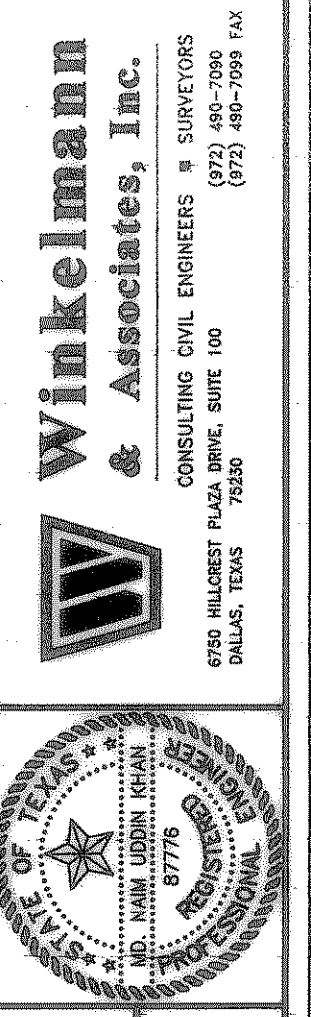

Winkelmann & Associates, Inc.
CONSULTING CIVIL ENGINEERS & SURVEYORS
6700 HILLCREST PLAZA, SUITE 100
DALLAS, TEXAS 75230
(972) 492-7000 FAX