


THE SEAL APPEARING ON THIS DOCUMENT WAS AUTHORIZED BY MD. NAIM UDDIN KHAN, # 87776

THESE CONSTRUCTION PLANS WERE PREPARED UNDER THE RESPONSIBLE SUPERVISION OF MD. NAIM UDDIN KHAN, REGISTERED PROFESSIONAL ENGINEER NO. 87776

Scale: H: 1"=20'
 Date: 6/30/04
 Designed By: RB
 Drawn By: MK
 Checked By: INK
 File: 32004BBA.DWG/View:
 Project No.: 32004.01

ALLEY PAVING PROFILES
ALLEY 8 - STA. 0+00 TO STA. 6+05.89
ALLEY 9 - STA. 0+00 TO STA. 6+48.61

LOFLAND FARMS, PHASE 5B
 W.H. BAIRD SURVEY, ABSTRACT NO. 25
 CITY OF ROCKWALL
 ROCKWALL COUNTY, TEXAS
 D.R. HORTON
 4306 MILLER ROAD, SUITE-A
 ROWLETT, TEXAS 75088

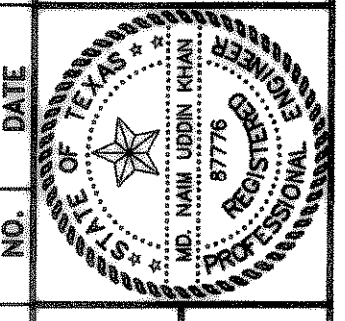

Winkelmann & Associates, Inc.
 CONSULTING CIVIL ENGINEERS & SURVEYORS
 6730 Wilcrest Plaza Dr., Suite 105
 Dallas, Texas 75230
 (972) 499-7399 FAX
 www.winkelmann.com

SHEET
 10
 OF
 28