

THESE CONSTRUCTION PLANS WERE PREPARED AND THE RESPONSIBLE SUPERVISION OF THE WORK WAS UNDER THE DIRECT SUPERVISION OF REGISTERED PROFESSIONAL ENGINEER NO. 87776


THE SEAL APPEARING ON THIS DOCUMENT WAS AUTHORIZED BY MD. NAIM UDDIN KHAN, # 87776

M. Naim Uddin Khan 6/20/04

Scale: 1" = 10' Date: 6/30/04
 Designed By: RB
 Drawn By: MK
 Checked By: MK
 File: 320045BA1.DWG View:
 Project No.: 32004.01

ALLEY PAVING PROFILE
ALLEY 10 - STA. 0+37.54 TO STA. 13+09.08

LOFLAND FARMS, PHASE 5B
 W.H. BAIRD SURVEY, ABSTRACT NO. 25
 CITY OF ROCKWALL
 ROCKWALL COUNTY, TEXAS
 D.R. HORTON
 4306 MILLER ROAD, SUITE-A
 ROWLETT, TEXAS 75088

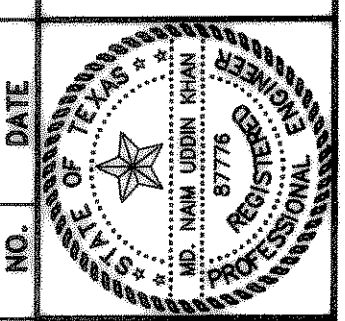

APPROV.
 REVISION
 DATE
 NO.

Winkelmann & Associates, Inc.
 CONSULTING CIVIL ENGINEERS & SURVEYORS
 8750 Hillcrest Park Drive, Suite 100
 Dallas, Texas 75238
 (972) 492-7058 FAX
 www.winkelmann.com