

STA. 3+91.00 (36.92' LT.)
 ALLEY "13"
 STA 1+00 CHANNEL 1
 TOP OF PROPOSED 2'X2'
 TYPE "Y" INLET = 577.00

N 5326.8128
 E 8908.8130
 PC STA. 1+47.85 CHANNEL 1

STA 0+36.27 (44.50' LT.)
 HAYMAKER DRIVE=
 STA 4+23.36 CULVERT 1
 CONST. SAFETY END
 TREATMENT TYPE 1
 FOR PIPE CULVERTS
 TxDOT SETP-PD

STA 0+36.27 (44.50' RT.)
 HAYMAKER DRIVE=
 STA 5+12.36 CULVERT 1
 CONST. SAFETY END
 TREATMENT TYPE 1
 FOR PIPE CULVERTS
 TxDOT SETP-PD

CURVE TABLE

CURVE	RADIUS	DELTA	TANGENT	LENGTH	CHORD	BEARING
C-1	20.00'	13°42'57"	2.41'	4.79'	4.78'	N08°38'58"W

CULVERT DESIGN CALCULATIONS

CULVERT LOCATION: LOLAND FARMS PHASE 5B, ROCKWALL, TEXAS
 LENGTH, L: 89.00 FT DESIGN STORM FREQ. 100-YR
 ROUGHNESS COEFF., n: 0.012 MAX. VEL. 12.0 ft/sec
 TAILWATER: 0.90' D.S. CHANNEL WIDTH: TRIANGULAR
 ENTRANCE DESCRIPTION: 5 DESIGN DISCHARGE: 2.25 cfs

RDWY. ELEV. 586.00 U.S. CULV. F.L. 582.44
 U.S. CULV. F.L. 582.38 D.S. CULV. F.L. 582.00
 DIFFERENCE: 3.64' DIFFERENCE: 0.44'
 ROAD FREEBOARD: 1.0 FT. CULV. SLOPE, S₀: DIFF. FL. LENGTH FT.
 ALLOW. HEADWATER: 2.64 FT. S₀ = 0.445 / 89.0 = 0.50%


DOWNSTREAM CHANNEL CALCULATIONS

Q₁₀₀ = 2.25 cfs
 n = 0.035
 SIDE SLOPE (LT. & RT.) = 3:1
 LONGITUDINAL SLOPE = 1.00%
 DEPTH OF FLOW = 0.62 ft
 AVERAGE VELOCITY = 1.95 fps

Trial Area of Opening T.A.c. (sq. ft.)	Channel Width "W" (feet)	T.A.c. W (feet)	AHW (feet)	Try Diameter "D" (inch)	POSSIBLE CULVERT SIZES										HEADWATER CALCULATION										The Greater Controlling Head Water (Inlet or Outlet) (feet)	SELECTED CONDUIT SIZE
					No. Openings	Pipe Dia. "D" (inch)	Total Culvert Area "Ac" (sf)	"Q" Each Opening (c.f.s.)	Entrance Type	Case No.	HW D (figure 26)	HW (feet)	Entrance Coeff. K _e	CASE III HW = H + TW - L X S ₀ (feet)					CASE IV HW = H + h ₀ - L X S ₀ (feet)							
														"H" (figure 28)	"TW" (feet)	L X S ₀ (feet)	"HW" (feet)	"H" (figure 28)	h ₀ (figure 30)	h ₀ = $\frac{d_c + D}{2}$ or h ₀ = TW (use larger) (feet)	"TW" (feet)	h ₀ (feet)	L X S ₀ (feet)	"HW" (feet)		
0.19	TRIANGULAR	-	2.64	18"	1	18"	1.77	2.25	5	I	0.58	0.87	0.20	17	18	19	20	21	22	23	24	25	26	27	28	29

NOTE:
 FIG. 26, 28 & 30 ARE THE NOMOGRAPHS OF BUREAU OF PUBLIC ROADS, JAN. 1963, PAGE NO. 6-26, 6-28, 6-30

- LEGEND**
- PP Power Pole
 - WV Water Valve
 - SN Sign
 - TSN Traffic Signs
 - LP Light Pole
 - W Water Line
 - OH Overhead Power Lines
 - 742- Proposed Contour Line
 - 742 Existing Contour Line

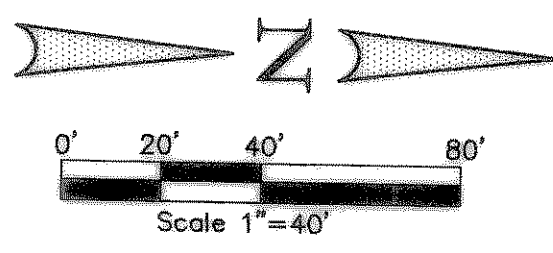


ASBUILT

Winkelmann & Associates, Inc. hereby states that this plan, to the best of our knowledge is "As Built." Modifications from the originally approved construction documents have been made as per information provided by the contractor. Winkelmann & Associates, Inc. does not certify as to the correctness or quality of construction as no field inspection was performed.

W. Naim Uddin Khan
 WINKELMANN & ASSOCIATES, INC. DATE: 6/20/05

BENCHMARK: ELEV. = 600.69
 CITY OF ROCKWALL R-19
 BRASS MONUMENT AT THE N/W CORNER OF SILVERVIEW & DIAMOND WAY. 500' ± SOUTH OF S.H. 276.

BENCHMARK: ELEV. = 583.56
 R.R. SPIKE SET IN THE CENTERLINE OF S.H. 276 3600± WEST OF F.M. 549

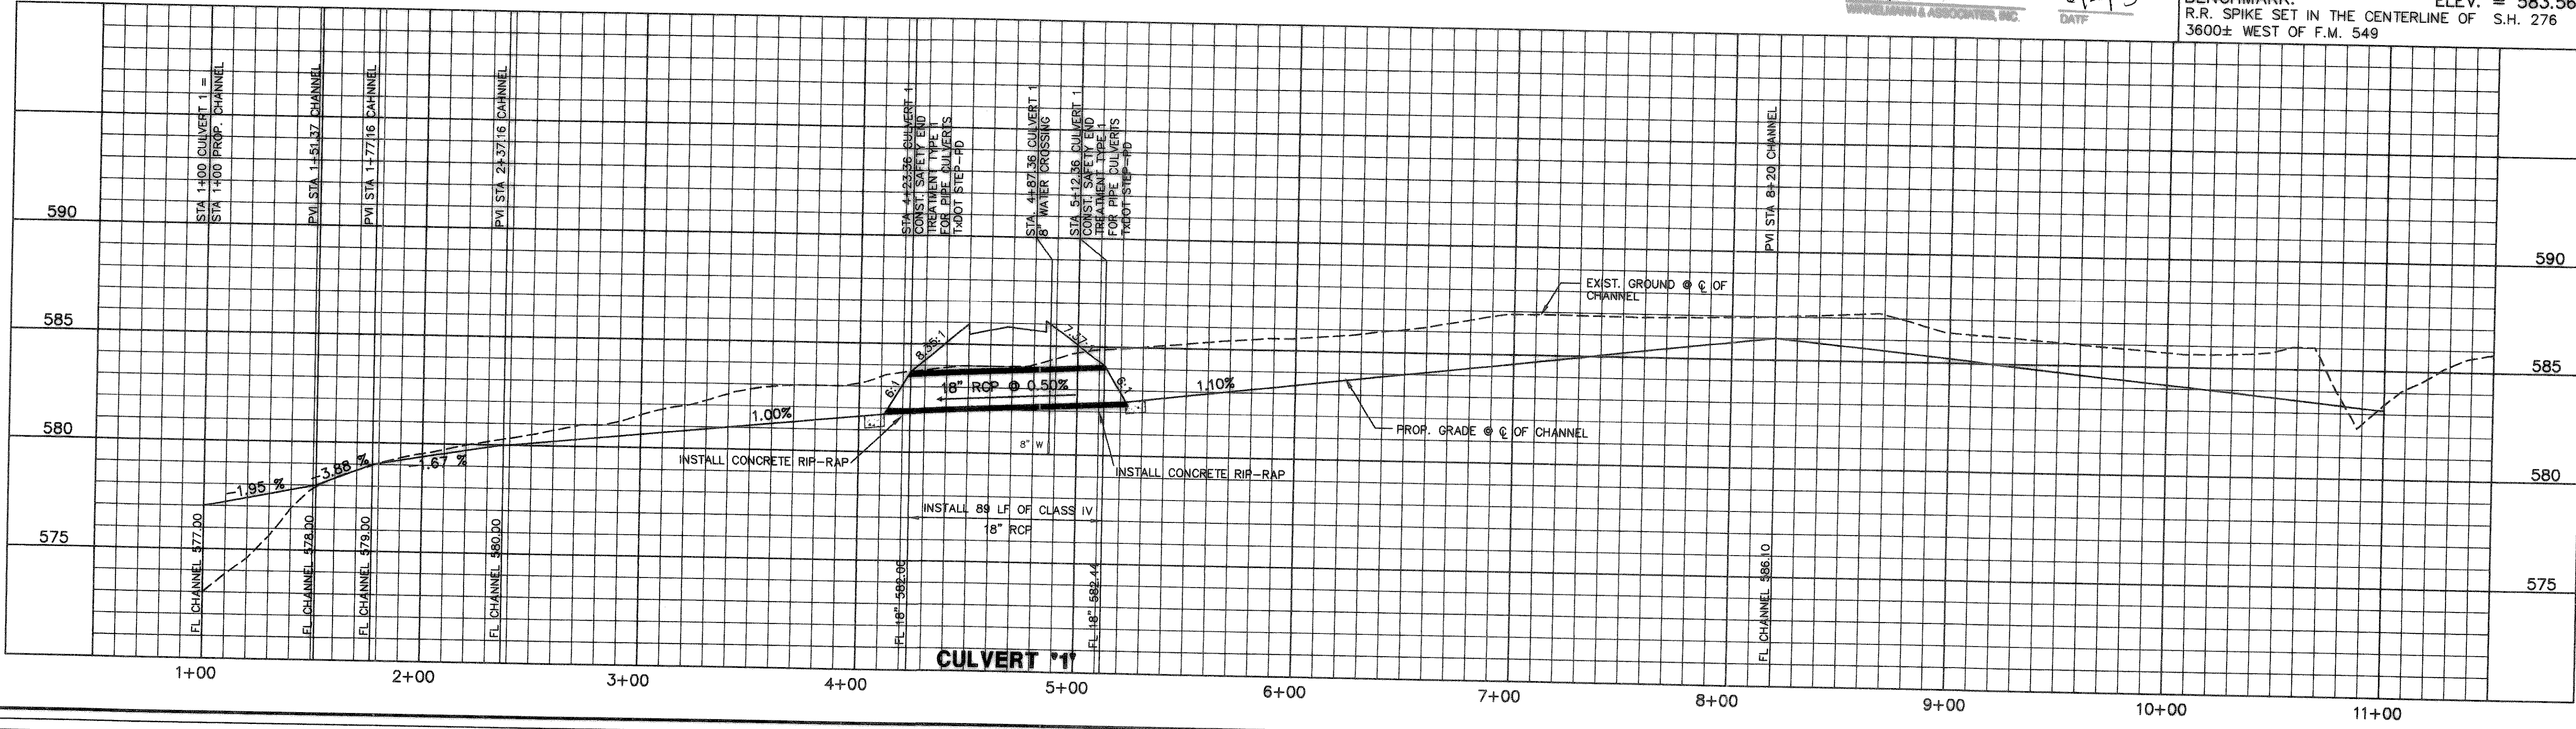

THESE CONSTRUCTION PLANS WERE PREPARED BY THE CONSULTING ENGINEER IN THE DIVISION OF PUBLIC WORKS, CITY OF ROCKWALL, TEXAS.

MD. NAIM UDDIN KHAN, REGISTERED PROFESSIONAL ENGINEER NO. 87776

LOLAND FARMS, PHASE 5B
 W.H. BAIRD SURVEY ABSTRACT NO. 25
 CITY OF ROCKWALL, TEXAS
 ROCKWALL COUNTY, TEXAS

D. R. HORTON
 4306 MILLER ROAD, SUITE A
 ROWLETT, TEXAS 75088

THE SEAL APPEARING ON THIS DOCUMENT WAS AUTHORIZED BY MD. NAIM UDDIN KHAN, P.E. #87776

CULVERT PLAN, PROFILE & CALCULATIONS

Scale: 1" = 40' Date: 05/30/04
 Designed By: NK
 Drawn By: NK
 Checked By: NK
 File: 320045B.CUL.dwg View:
 Project No.: 32004.00

APPROV. REVISION NO. DATE

Winkelmann & Associates, Inc.
 CONSULTING CIVIL ENGINEERS & SURVEYORS
 6725 HILLCREST PLACE, SUITE 100
 DALLAS, TEXAS 75230
 (972) 800-7000 FAX