

BENCHMARK: ELEV. = 800.89
 BRASS MONUMENT AT THE N/W CORNER OF SILVERVIEW & DIAMOND WAYS 500' ± SOUTH OF SH 276.

BENCHMARK: ELEV. = 583.56
 R.R. SPIKE SET IN THE CENTERLINE OF S.H. 276 3500± WEST OF P.M. 549

THESE CONSTRUCTION PLANS WERE PREPARED UNDER THE RESPONSIBLE SUPERVISION OF M.D. NAM UDIN KHAN, REGISTERED PROFESSIONAL ENGINEER NO. 87776

W.H. BAIRD SURVEY ABSTRACT NO. 25
 ROCKWALL COUNTY, TEXAS

LOTLAND FARMS, PHASE 5A
 W.H. BAIRD SURVEY ABSTRACT NO. 25
 ROCKWALL COUNTY, TEXAS



Scale: 1" = 4'-0"
 Date: 04-01-03

Designed By: RB
 Drawn By: MK
 Checked By: MK
 File: 320045A.SSP.DWG
 Project No.: 32004.01

SANITARY SEWER PROFILE
8" FORCE MAIN
LINE E - STA. 1+11.31 TO STA. 12+86.83

CONTINENTAL HOMES
 621 WEST COLLEGE STREET
 GRAPEVINE, TEXAS 76051

WINKELMANN & ASSOCIATES, INC.
 CONSULTING CIVIL ENGINEERS & SURVEYORS
 6750 Hillcrest Plaza Drive, Suite 100
 Dallas, Texas 75230
 (972) 462-7000
 (972) 462-7099 FAX

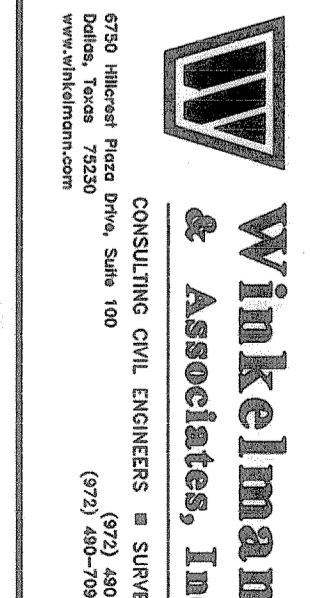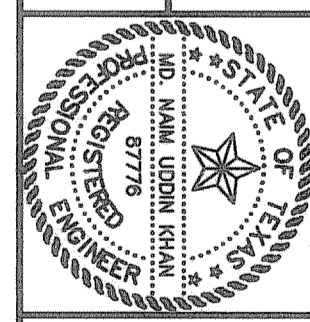

NO.	DATE	REVISION	APPROV.