


GENERAL NOTE:  
1. ALL TRAFFIC CONTROL DEVICES TO BE PER TxDOT STANDARDS.  
CONTRACTOR TO USE FLAGMEN, ARROW BOARDS, ETC... AS REQUIRED  
BY TxDOT FOR OVERLAY & RESTRIPIING.  
2. CONTRACTOR TO CONTACT TxDOT INSPECTOR 48 HRS. PRIOR TO CONSTRUCTION.

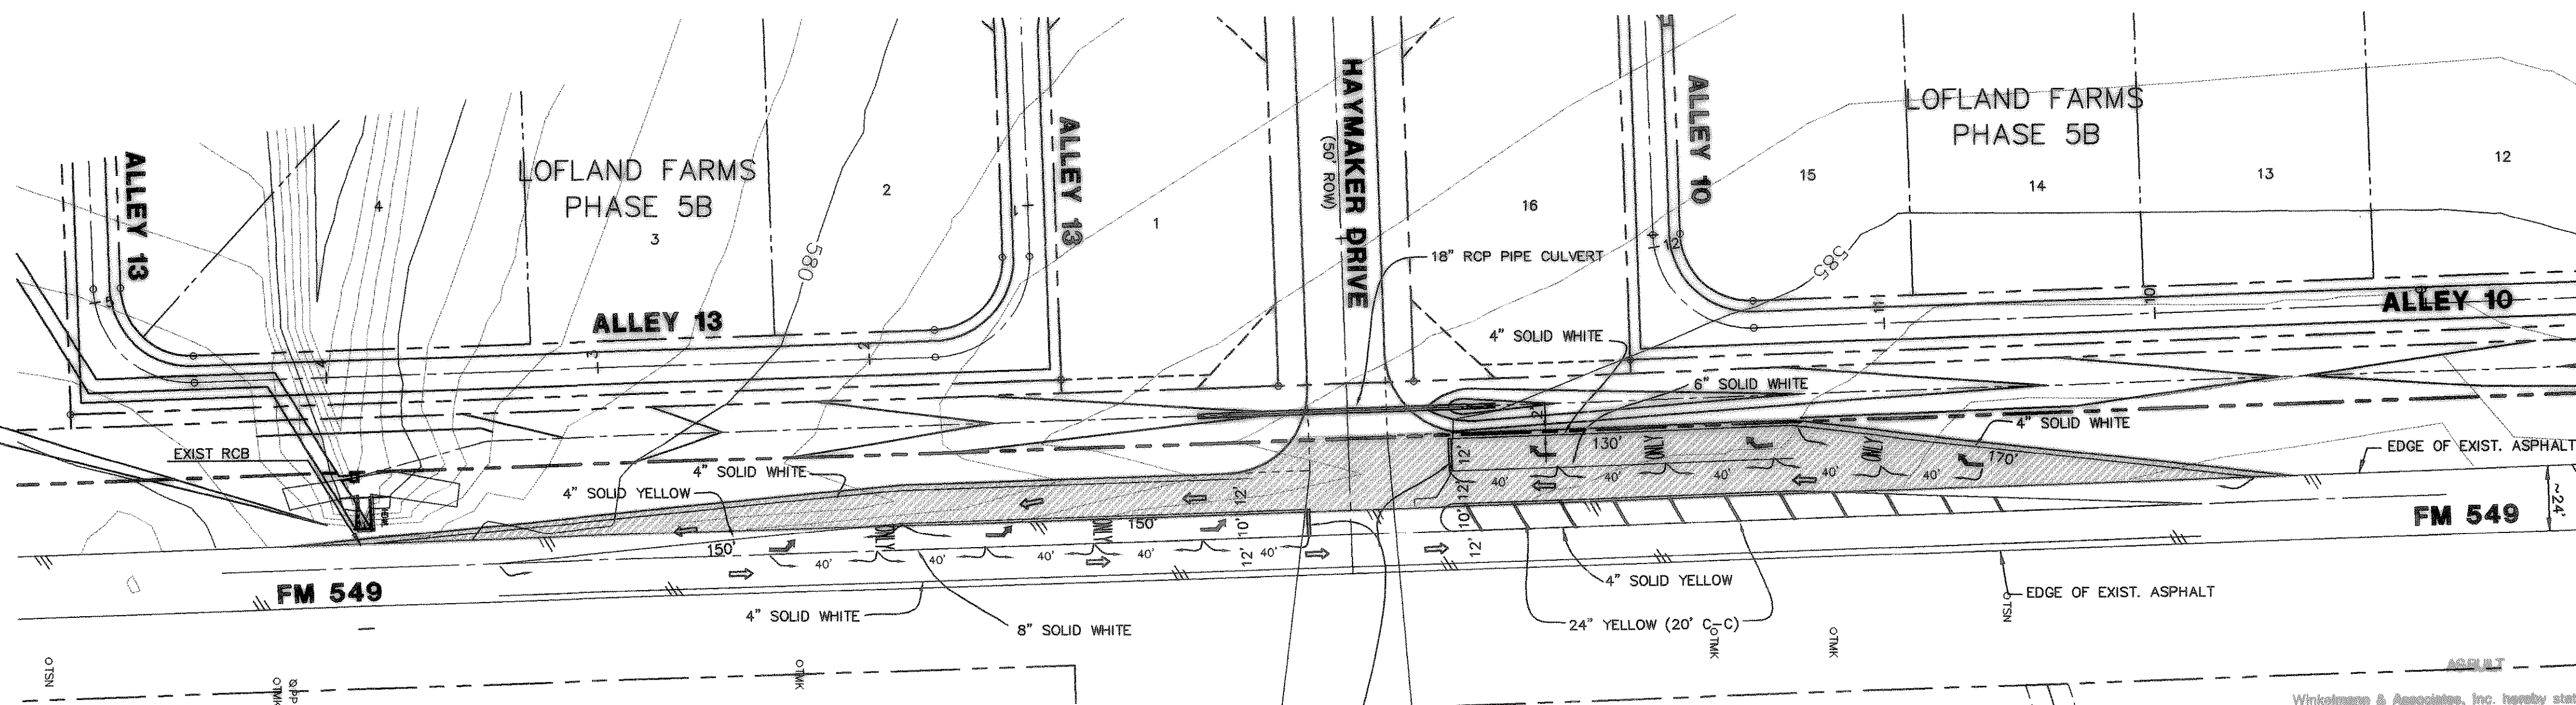

CONTRACTOR TO FIELD VERIFY SIZE  
OF EXIST. PIPE & FLOW LINE  
OF EXIST. HDWL.

P.I. STA.  
0+14.92 (14.50' LT.)  
HAYMAKER DRIVE  
TP 585.68


P.I. STA.  
0+26.94 (14.50' RT.)  
HAYMAKER DRIVE  
TP 585.40  
TP 585.90

INSTALL 24" STOP BAR  
AS PER TxDOT STANDARDS

WARNING!!!  
EXIST. UNDERGROUND ELECTRIC, TELEPHONE  
& WATER. CONTRACTOR TO VERIFY LOCATION AND  
DEPTH OF EXISTING UTILITIES PRIOR TO CONSTRUCTION.

Winkelmann & Associates, Inc. hereby states that this  
plan, to the best of our knowledge is "As Built."  
Modifications from the originally approved construction  
documents have been made as per information provided by  
the contractor. Winkelmann & Associates, Inc. does not  
certify as to the correctness or quality of construction as no  
field inspection was performed.

*W. Winkelmann*  
WINKELMANN & ASSOCIATES, INC. DATE: 6/20/05

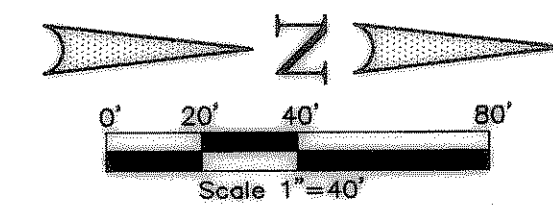

BENCHMARK: ELEV. = 600.69  
CITY OF ROCKWALL R-19  
BRASS MONUMENT AT THE N/W CORNER OF  
SILVERVIEW & DIAMOND WAY. 500' ± SOUTH OF  
S.H. 276.

BENCHMARK: ELEV. = 583.56  
R.R. SPIKE SET IN THE CENTERLINE OF S.H. 276  
3600± WEST OF F.M. 549

EXTENDED ASPH. AREA

THESE CONSTRUCTION PLANS WERE PREPARED  
UNDER THE RESPONSIBLE SUPERVISION OF  
MD. NAIM UDDIN KHAN, REGISTERED PROFESSIONAL  
ENGINEER NO. 87776.

THE SEAL APPEARING ON THIS  
DOCUMENT WAS AUTHORIZED BY  
MD. NAIM UDDIN KHAN, P.E. #87776

NO.	DATE	REVISION	APPROV.

Winkelmann & Associates, Inc.  
CONSULTING CIVIL ENGINEERS & SURVEYORS  
6700 West Loop South, Suite 100  
Dallas, Texas 75208  
(972) 422-2998 FAX  
www.winkelmann.com

LOFLAND FARMS, PHASE 5B  
SURVEY, ABSTRACT NO. 25  
OF ROCKWALL COUNTY, TEXAS  
D.R. HORTON  
4306 MILLER ROAD, SUITE-A  
ROWLETT, TEXAS 75088

PAVING PLAN  
LEFT TURN LANE - FM 549

Scale: 1"=40'  
Date: 07/09/04  
Designed By: MS  
Drawn By: MS  
Checked By: NK  
File: 320045PP&DWG View:  
Project No.: 32004-01

SHEET  
9A  
OF  
28