


| DRAINAGE DATA | | | | | | | | | |
|---------------|-------|--------------------|------|----------------|----------------|--------------------|-----------------|-----------------|---------------------|
| DA NO | Acres | T _c min | C | I _s | Q _s | Q _s acc | I ₂₅ | Q ₂₅ | Q ₂₅ acc |
| 1 | 1.98 | 10 | 0.70 | 6.20 | 8.59 | — | 8.30 | 11.50 | — |
| 2 | 6.19 | 10 | 0.70 | 6.20 | 26.86 | — | 8.30 | 35.96 | — |

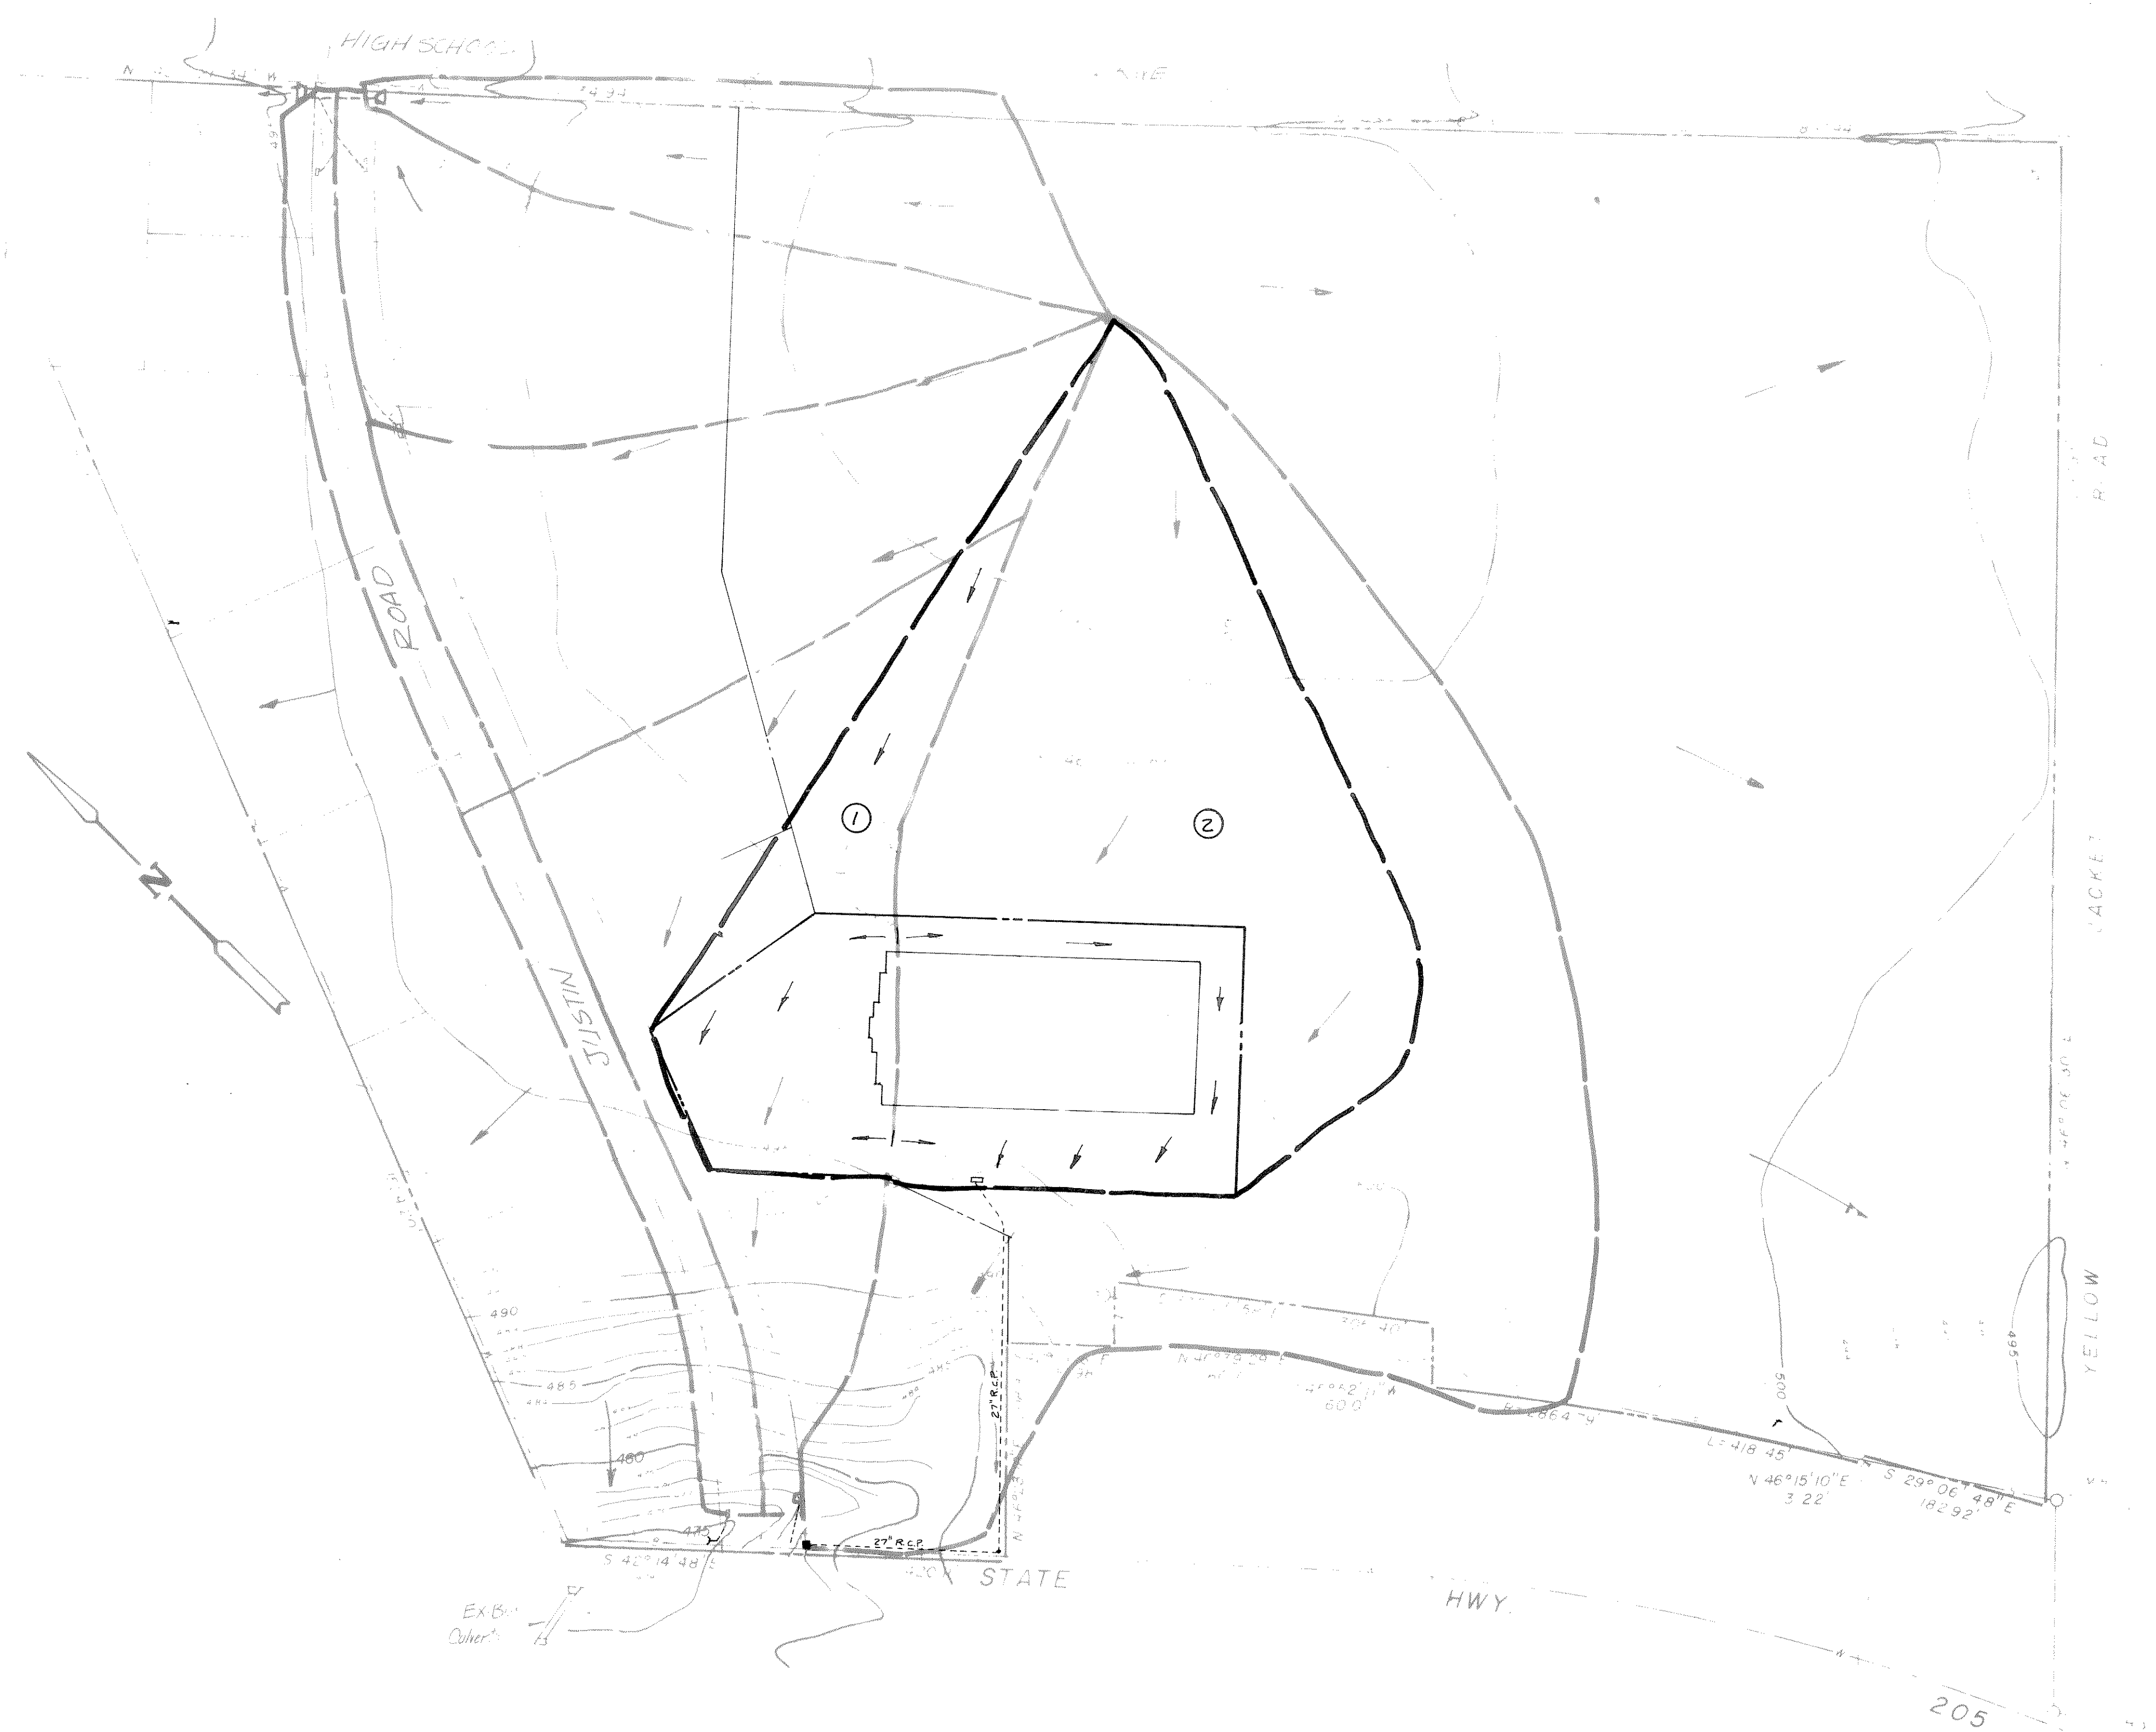

AS BUILT

C-6a

HAROLD L EVANS
CONSULTING ENGINEER
2331 GUS THOMASSON RD. SUITE 102
DALLAS, TEXAS 75228
PHONE (214) 328-8133

| | | |
|---------|---------|---------|
| SCALE | DATE | JOB NO. |
| 1"=100' | 3-20-87 | 8771 |

DRAINAGE AREA MAP
REPLAT PART OF LOT 1 BLOCK A
LOFLAND INDUSTRIAL PARK
CITY OF ROCKWALL
ROCKWALL COUNTY, TEXAS