


SANITARY SEWER PLAN
CITY OF ROCKWALL
REPLAT PART OF LOT 1, BLOCK A
LOFLAND INDUSTRIAL PARK
ROCKWALL COUNTY, TEXAS

HAROLD L. EVANS
 CONSULTING ENGINEER
 2331 GUS THOMASSON RD., SUITE 102
 DALLAS, TEXAS 75228
 PHONE (214) 328-8133
 DATE 3-20-87
 JOB NO. B771
 SCALE 1"=100'
 NUMBER S-11-87

AS BUILT

BEACH MARK
 CUT IN DRIVEWAY TO ROCKWALL
 MANHOLE TO BE RECONSTRUCTED
 HIKY AND TOPS
 DATE 4/14/20

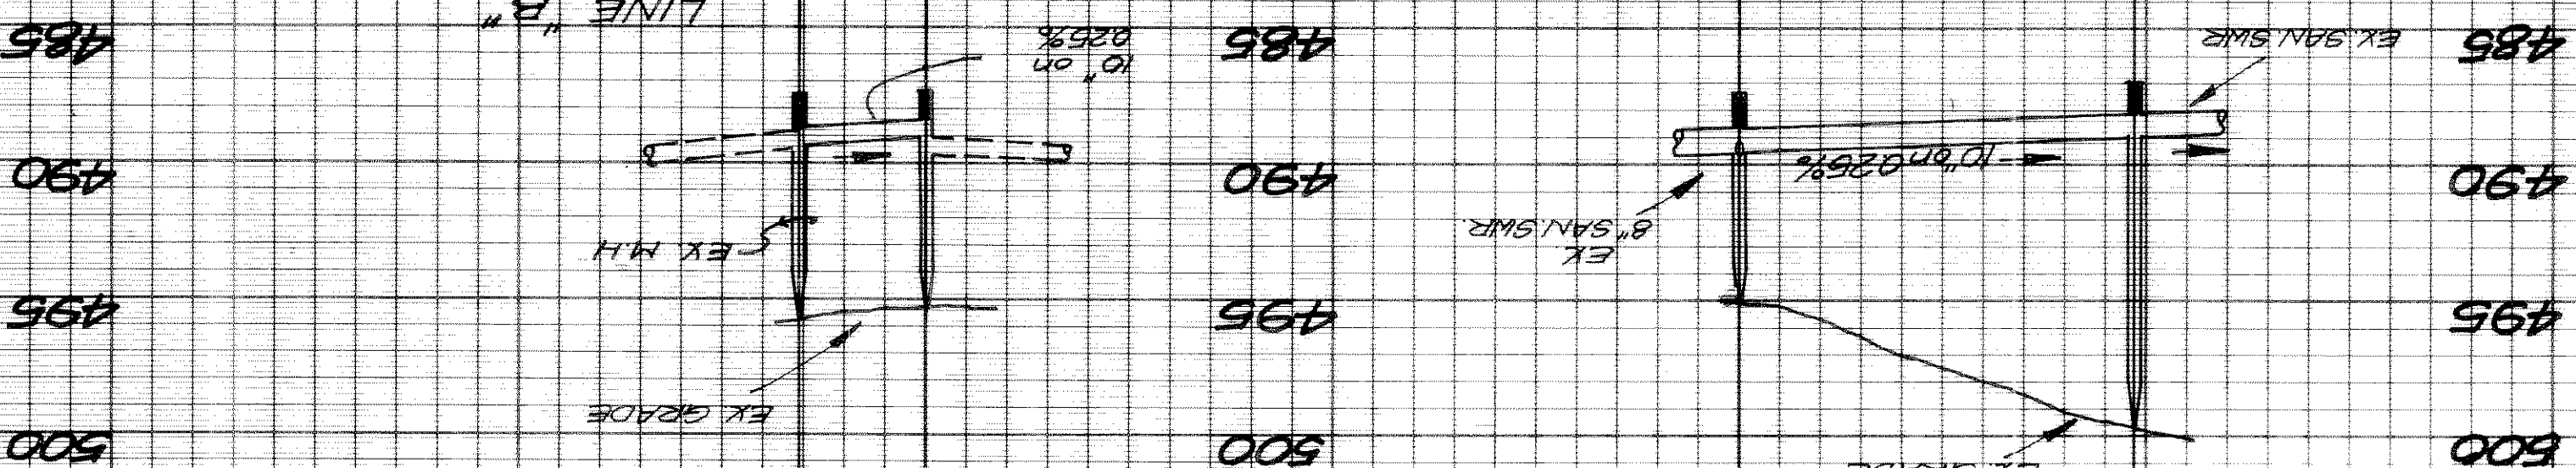

244422 LINE "B"
 CONSTRUCT 40" DIA. MANHOLE

0+00 LINE "A"
 CONSTRUCT 40" DIA. MANHOLE




0+00 LINE "B"
 CONSTRUCT 40" DIA. MANHOLE

0+00 LINE "A"
 CONSTRUCT 40" DIA. MANHOLE

0+00 LINE "B"
 CONSTRUCT 40" DIA. MANHOLE

0+00 LINE "A"
 CONSTRUCT 40" DIA. MANHOLE

0+00 LINE "B"
 CONSTRUCT 40" DIA. MANHOLE

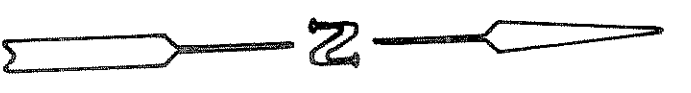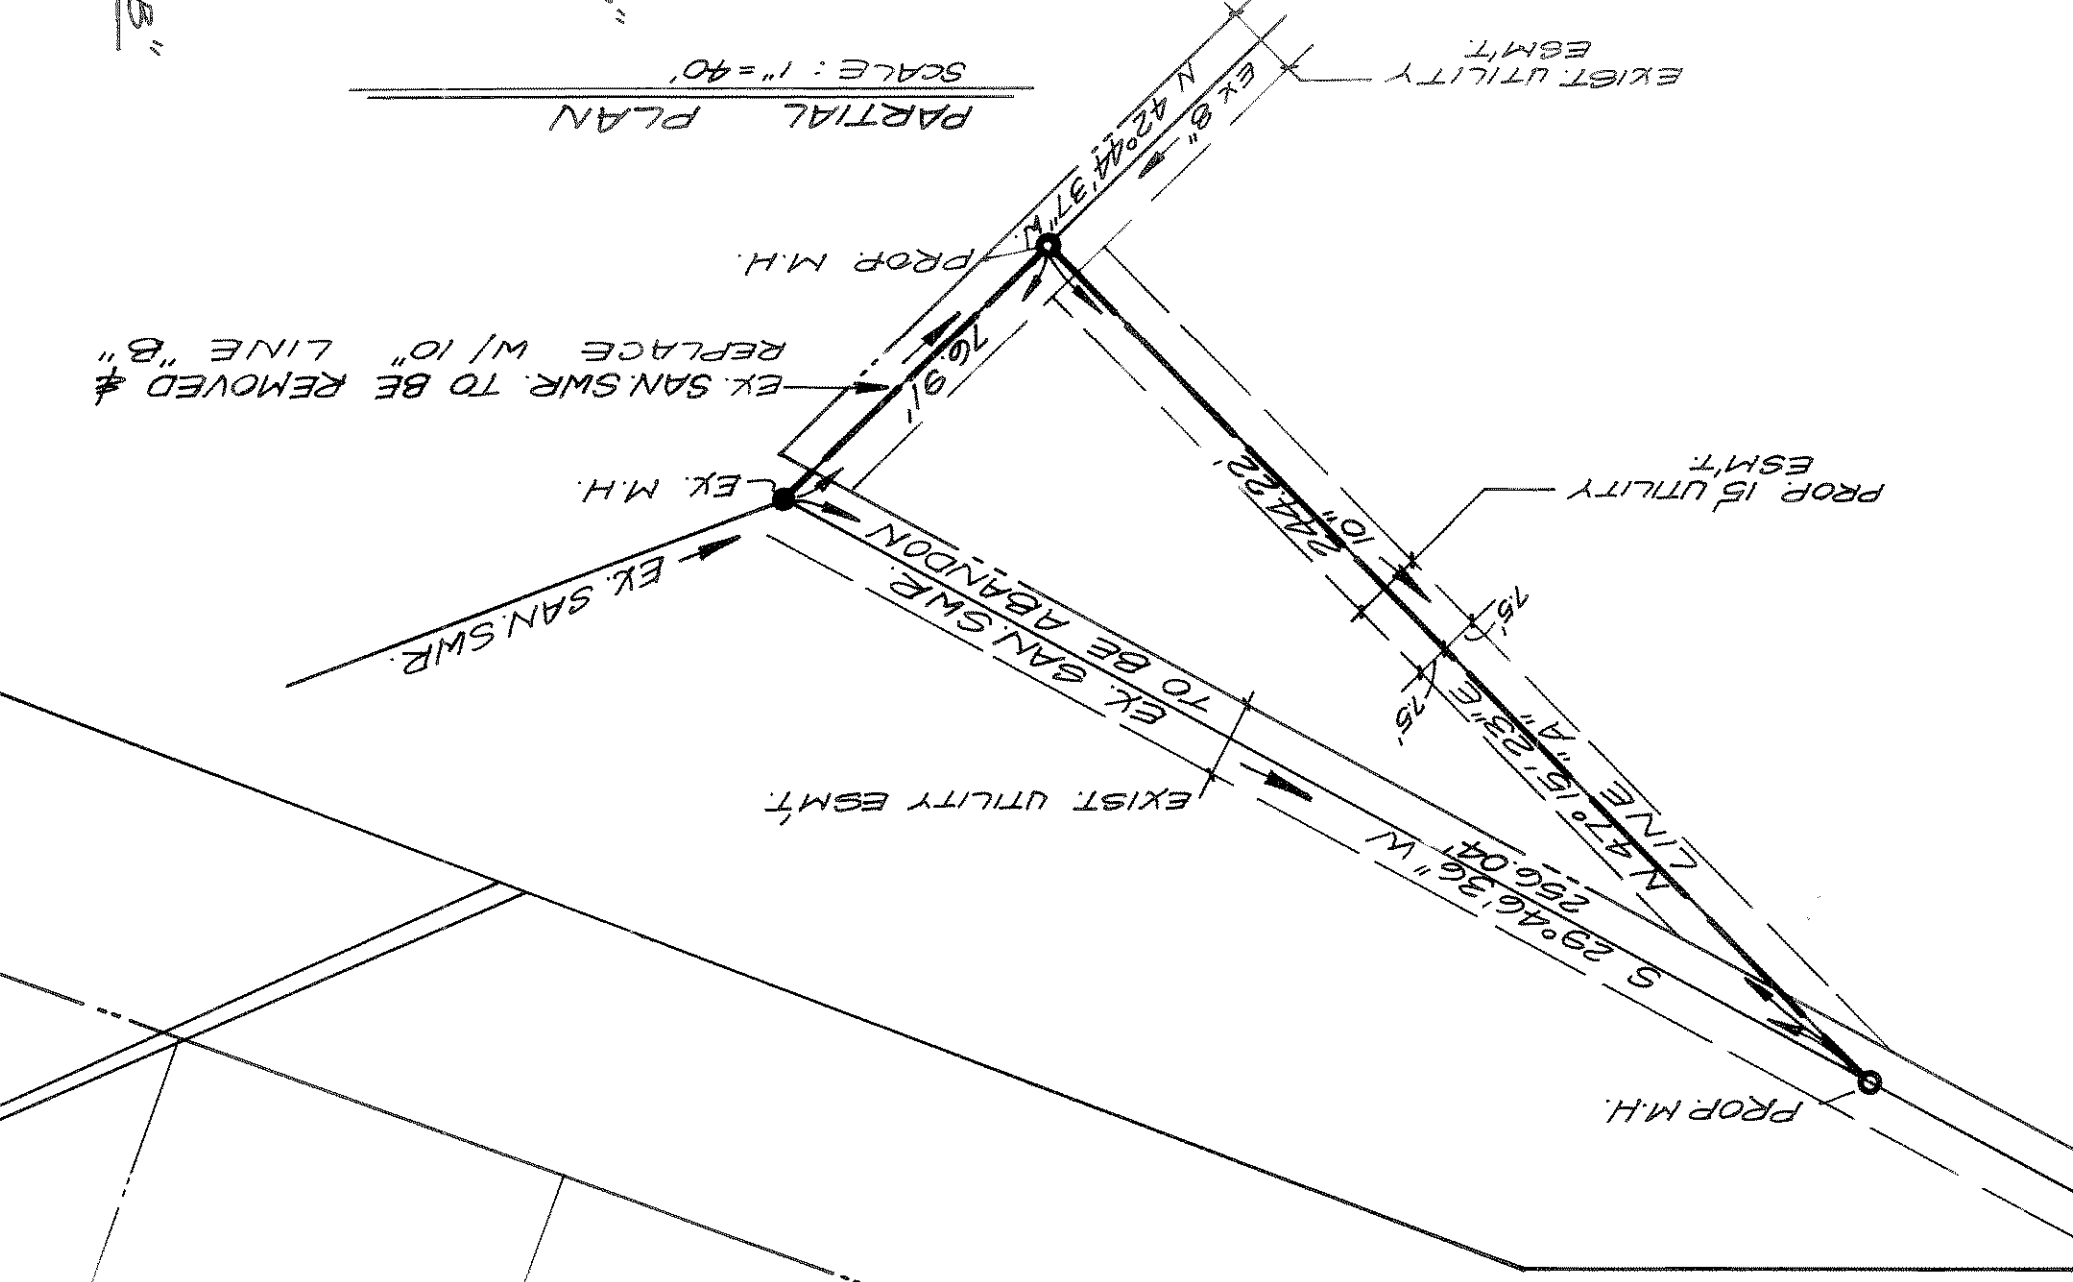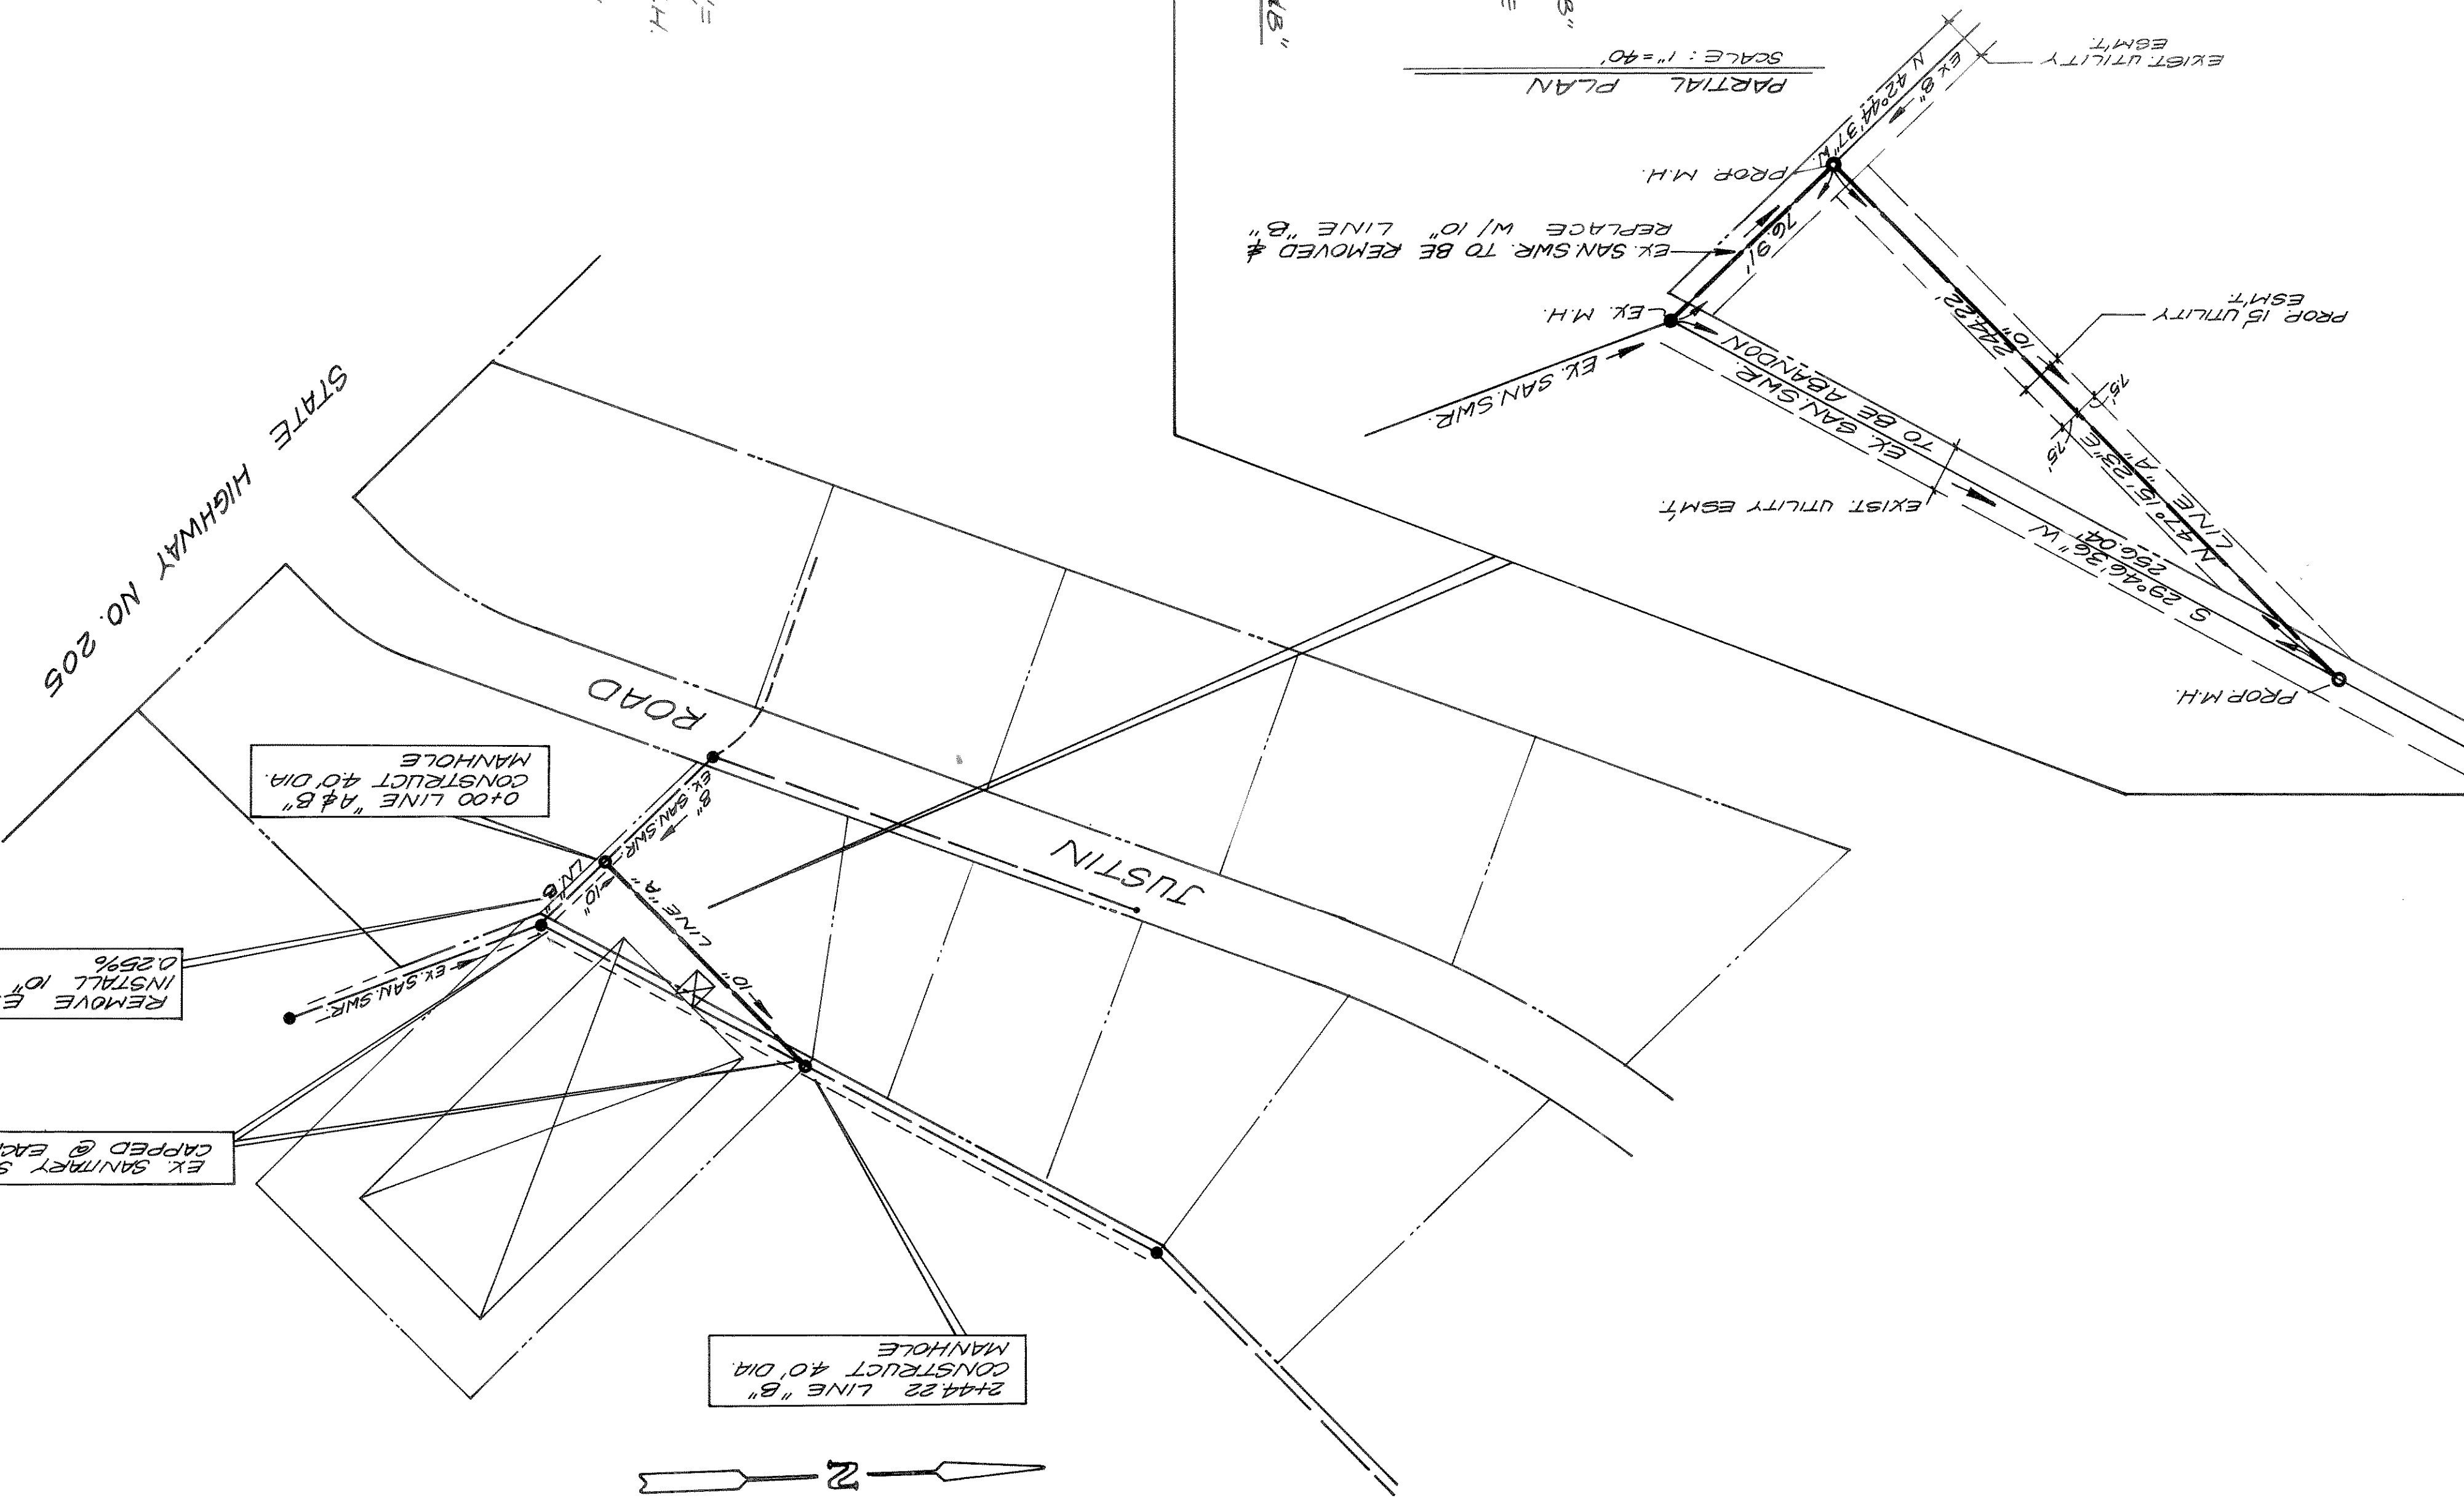

C-5