


3011 Armory Dr., Suite 300
Nashville, Tennessee 37204
Phone: (615) 885-9056

RECORD DRAWINGS

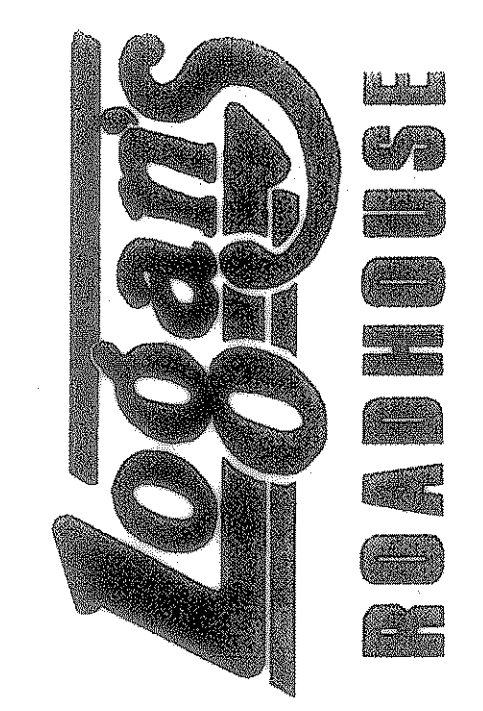









Location:
1-30 FRONTAGE ROAD
ROCKHALL, TEXAS

Job Number:
40-0563

Revisions:
#4: 04-04-08
#5: 10-15-08 (CITY COMMENTS)
#6: 07-10-09 (RECORD DWS)

C-4

Site Details
July 10, 2008
PROTO RH-65

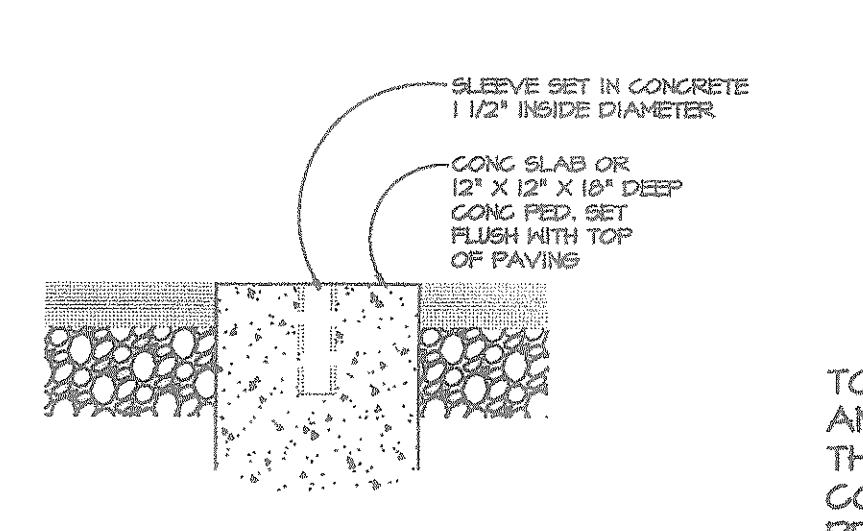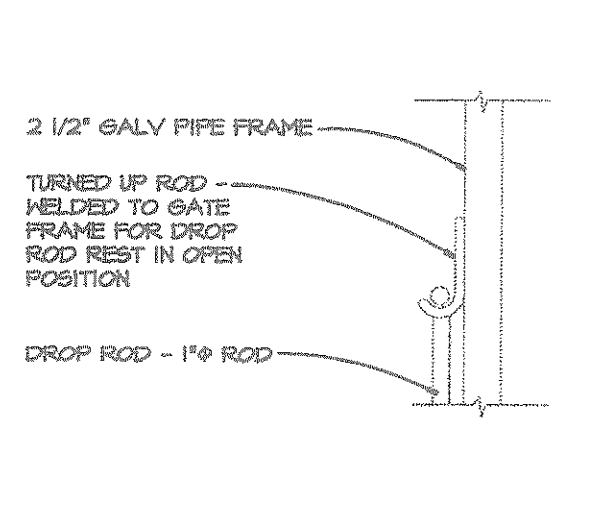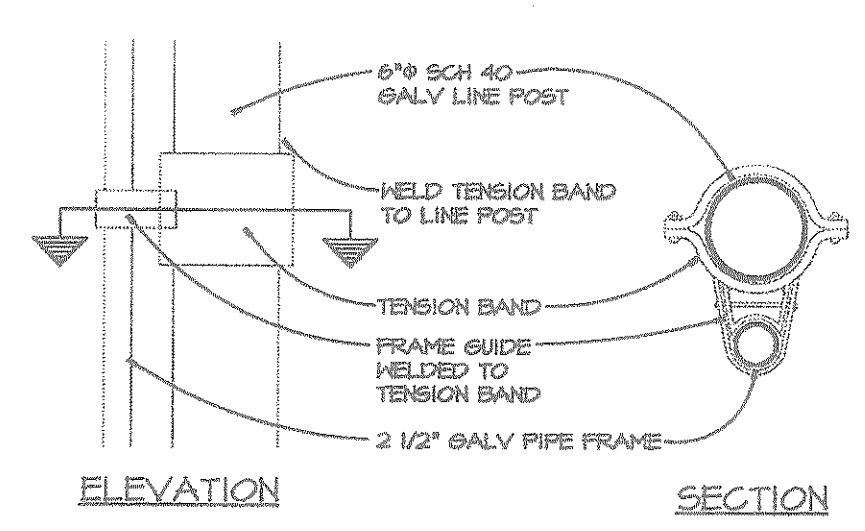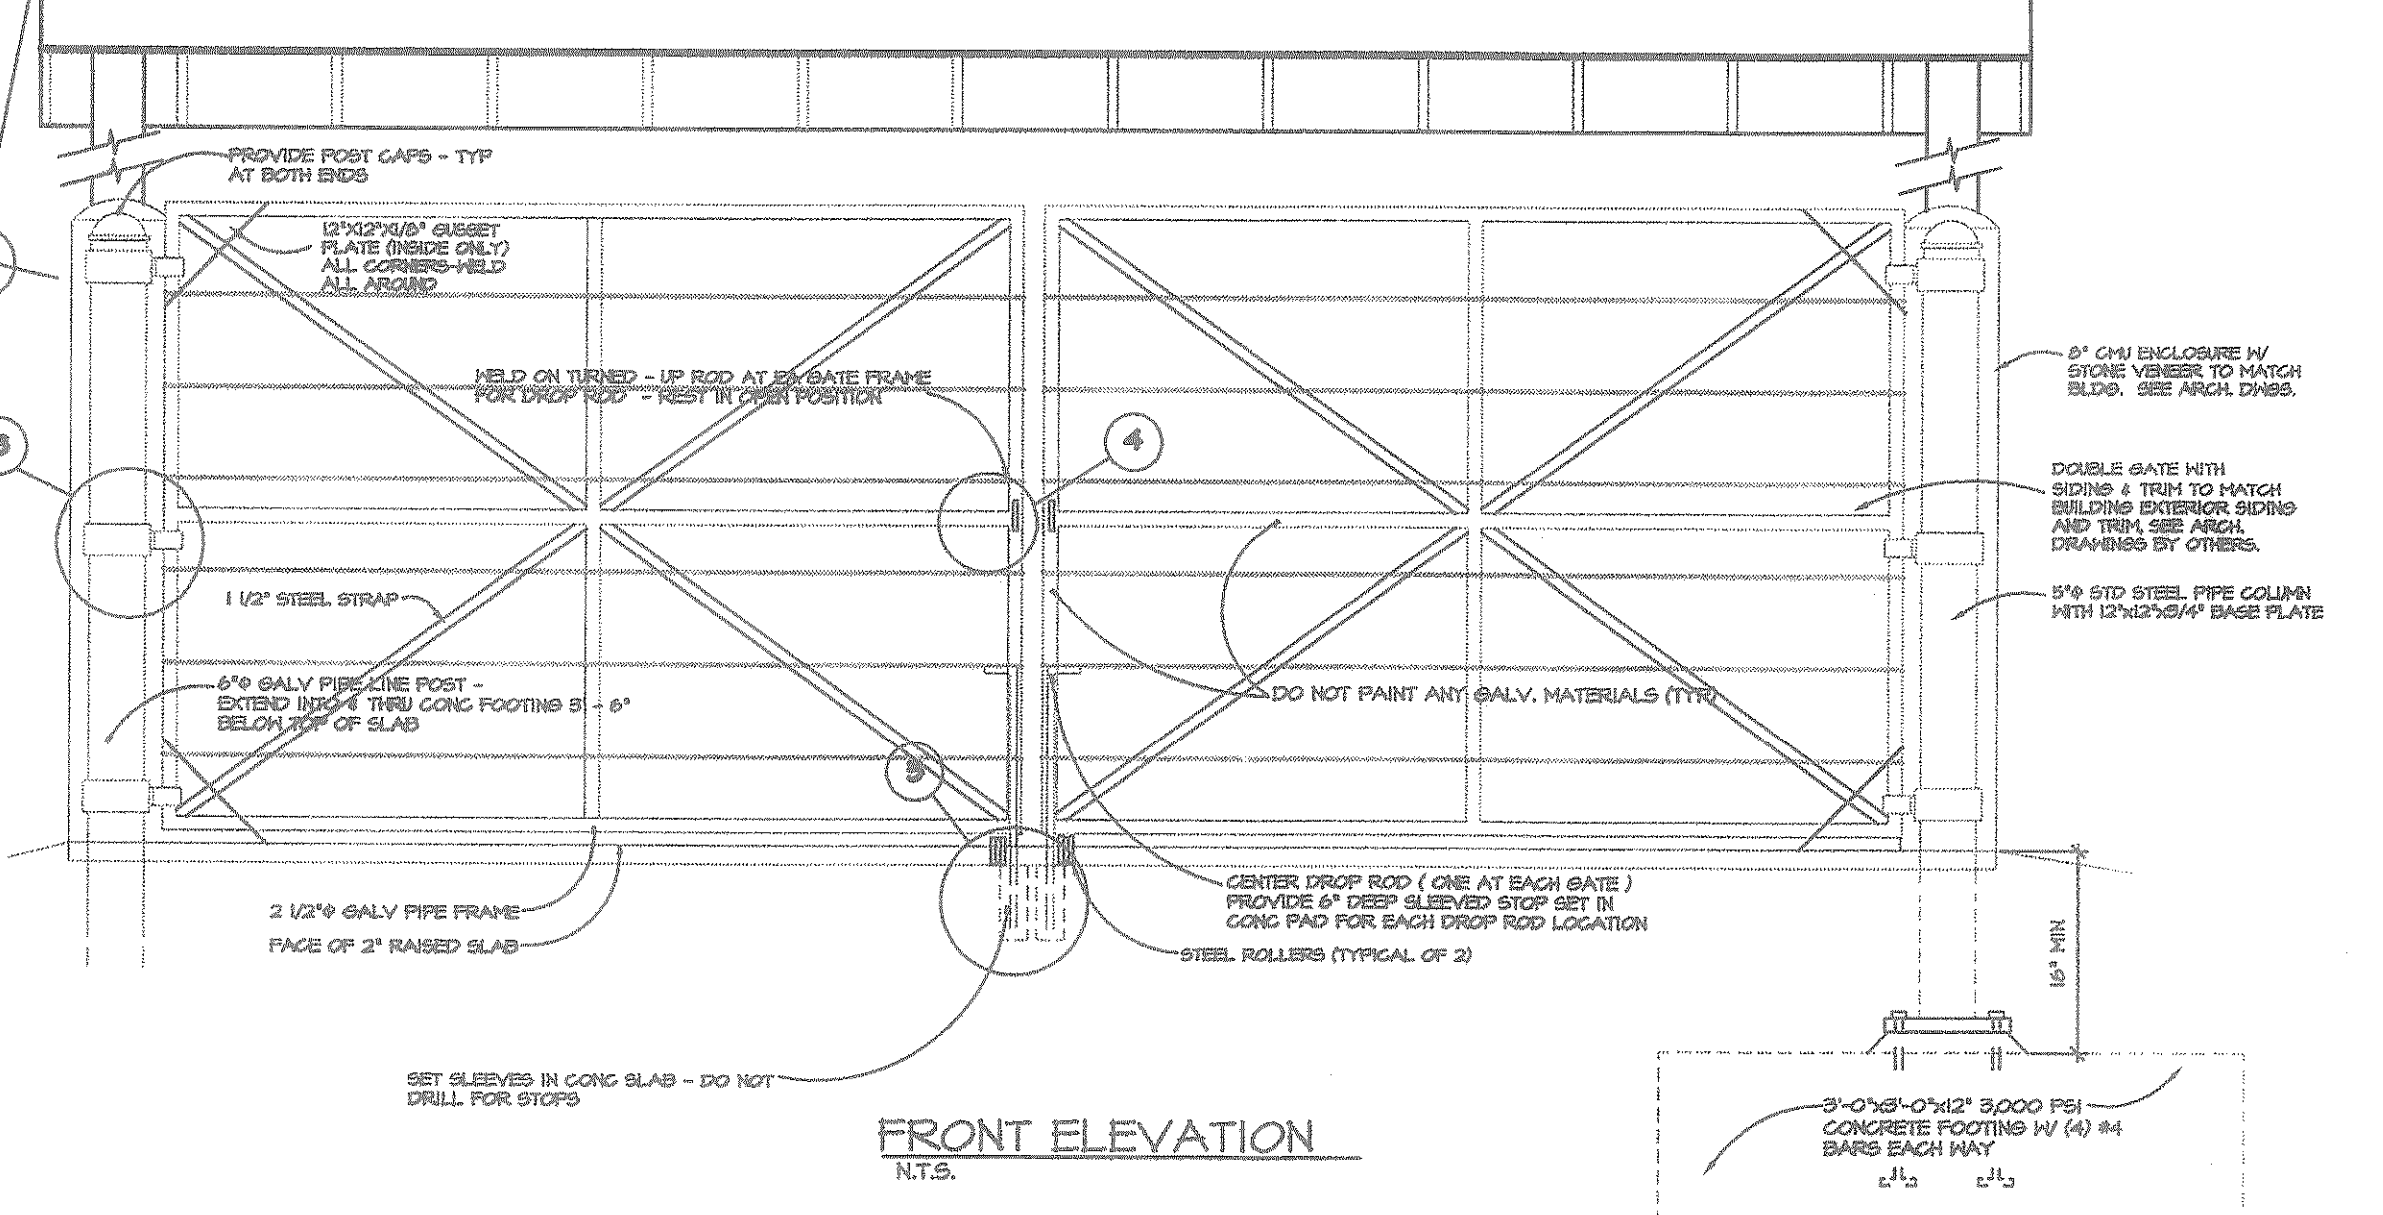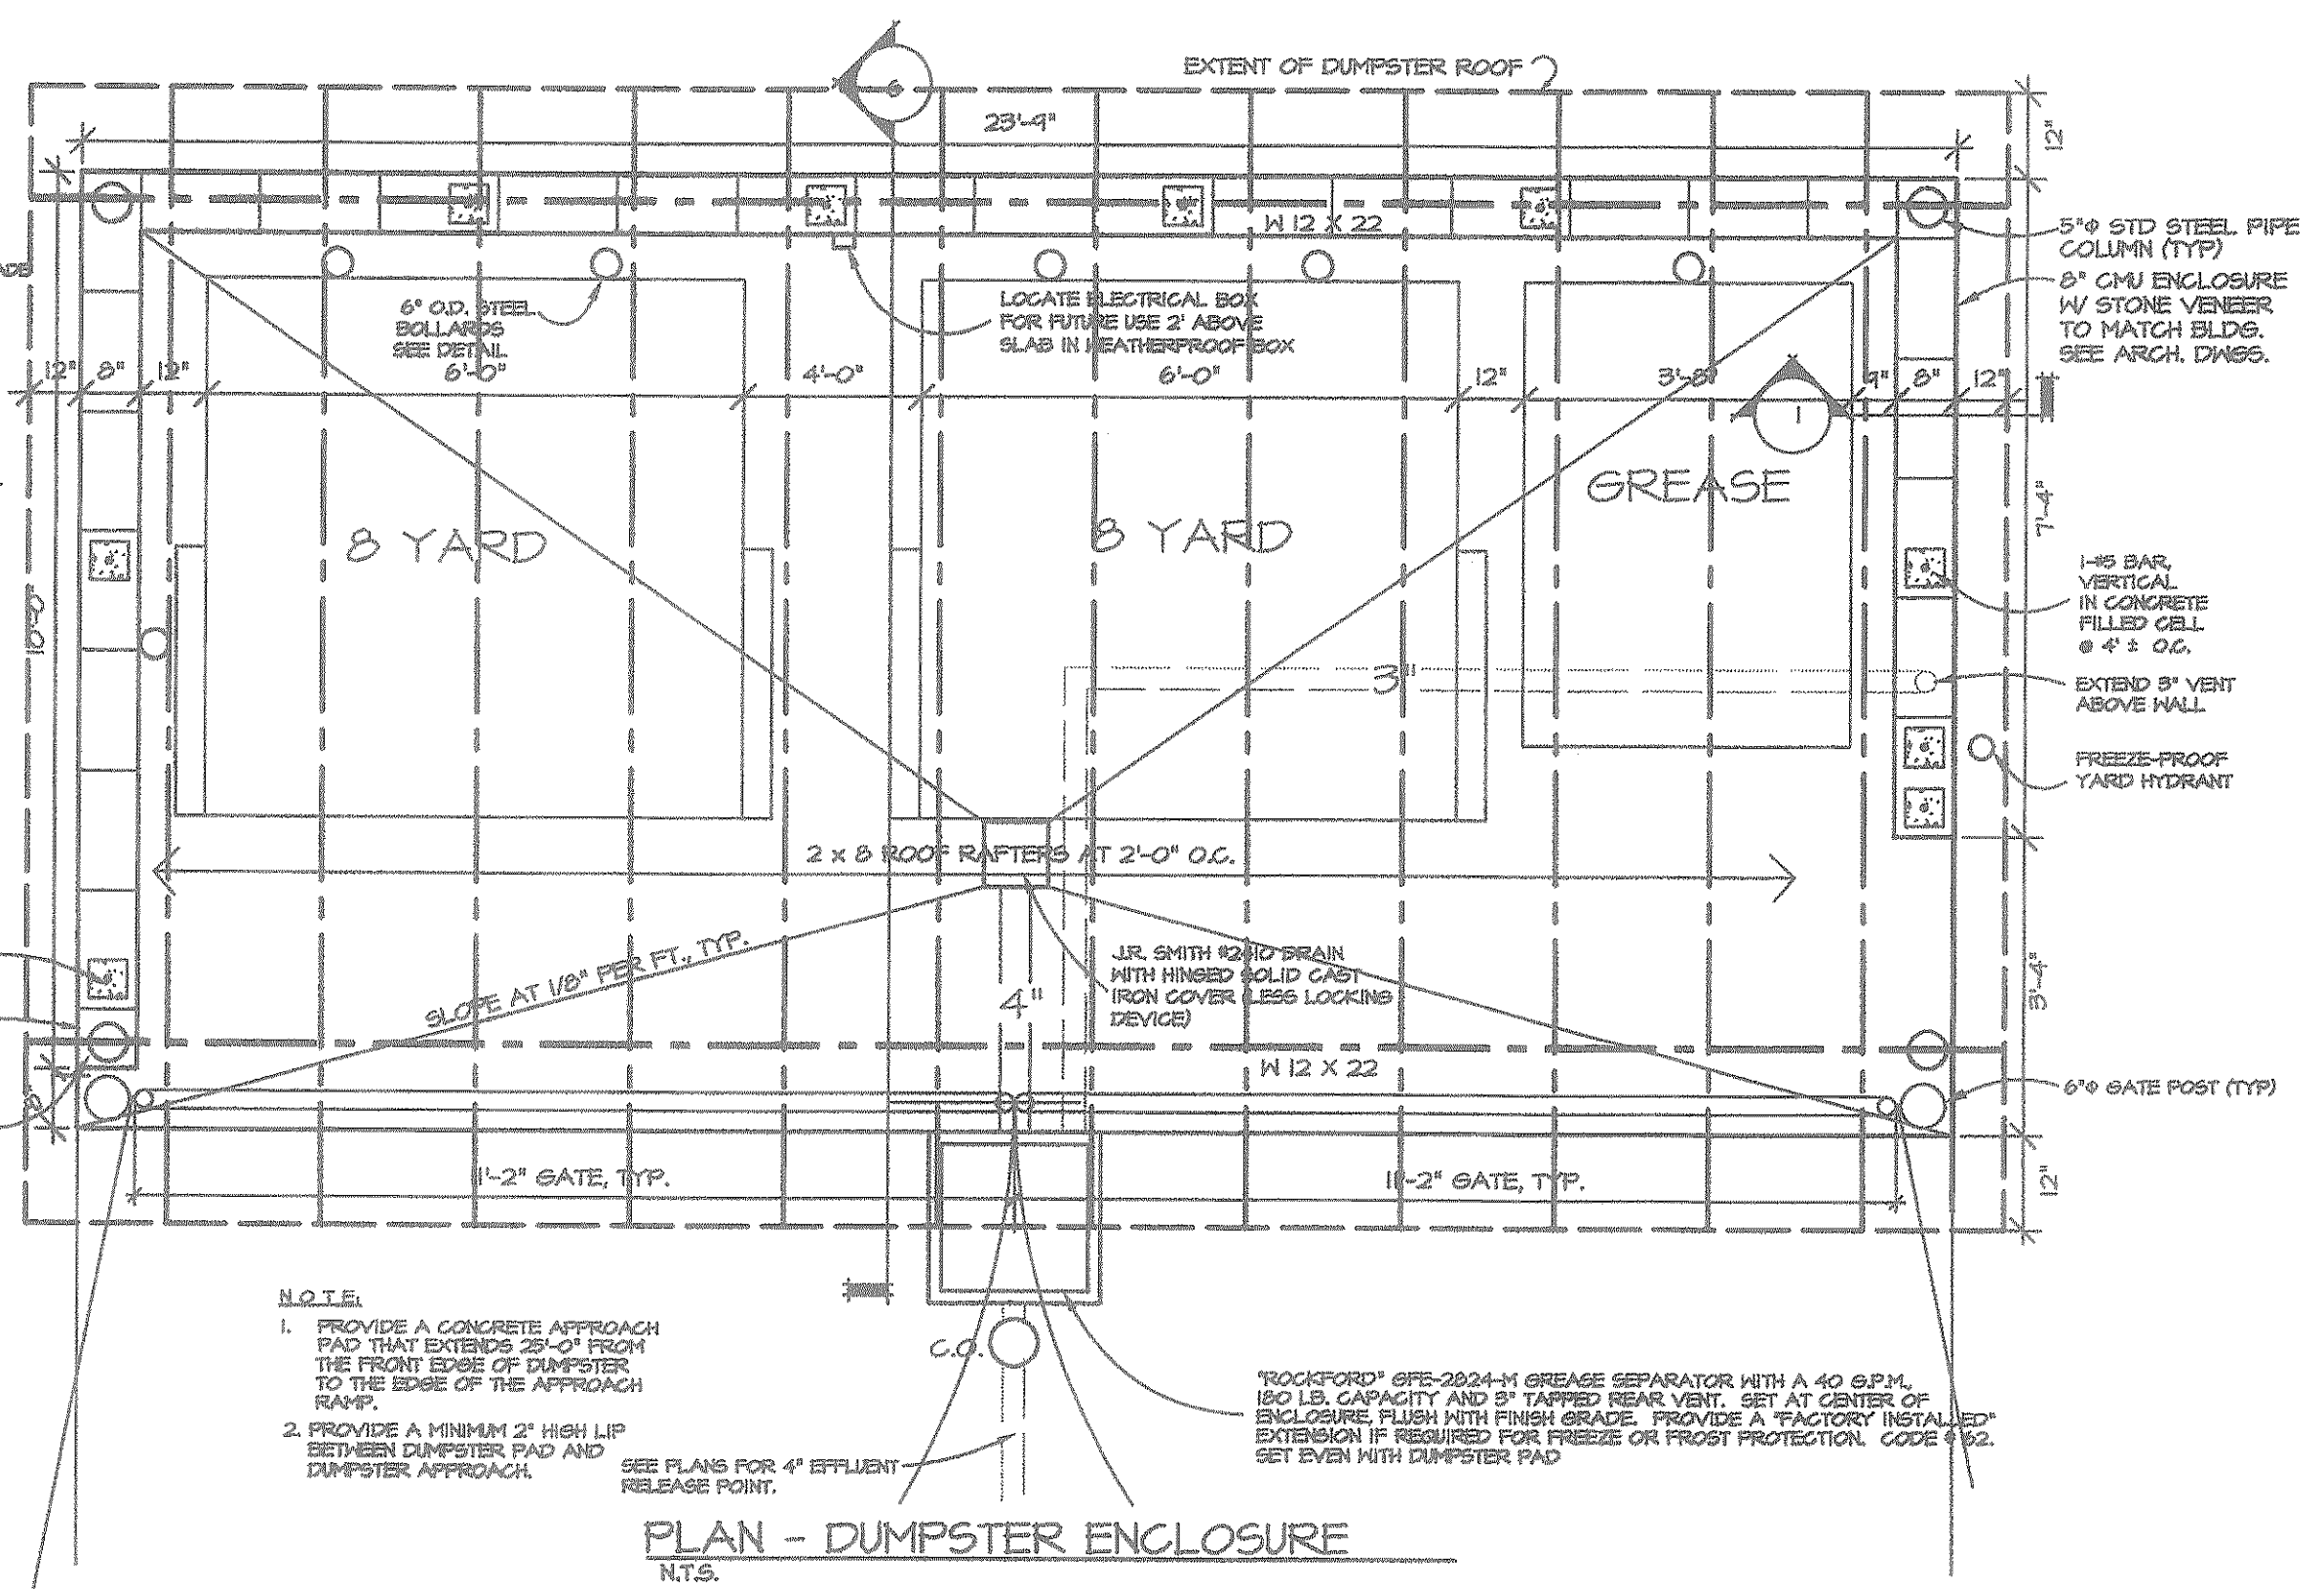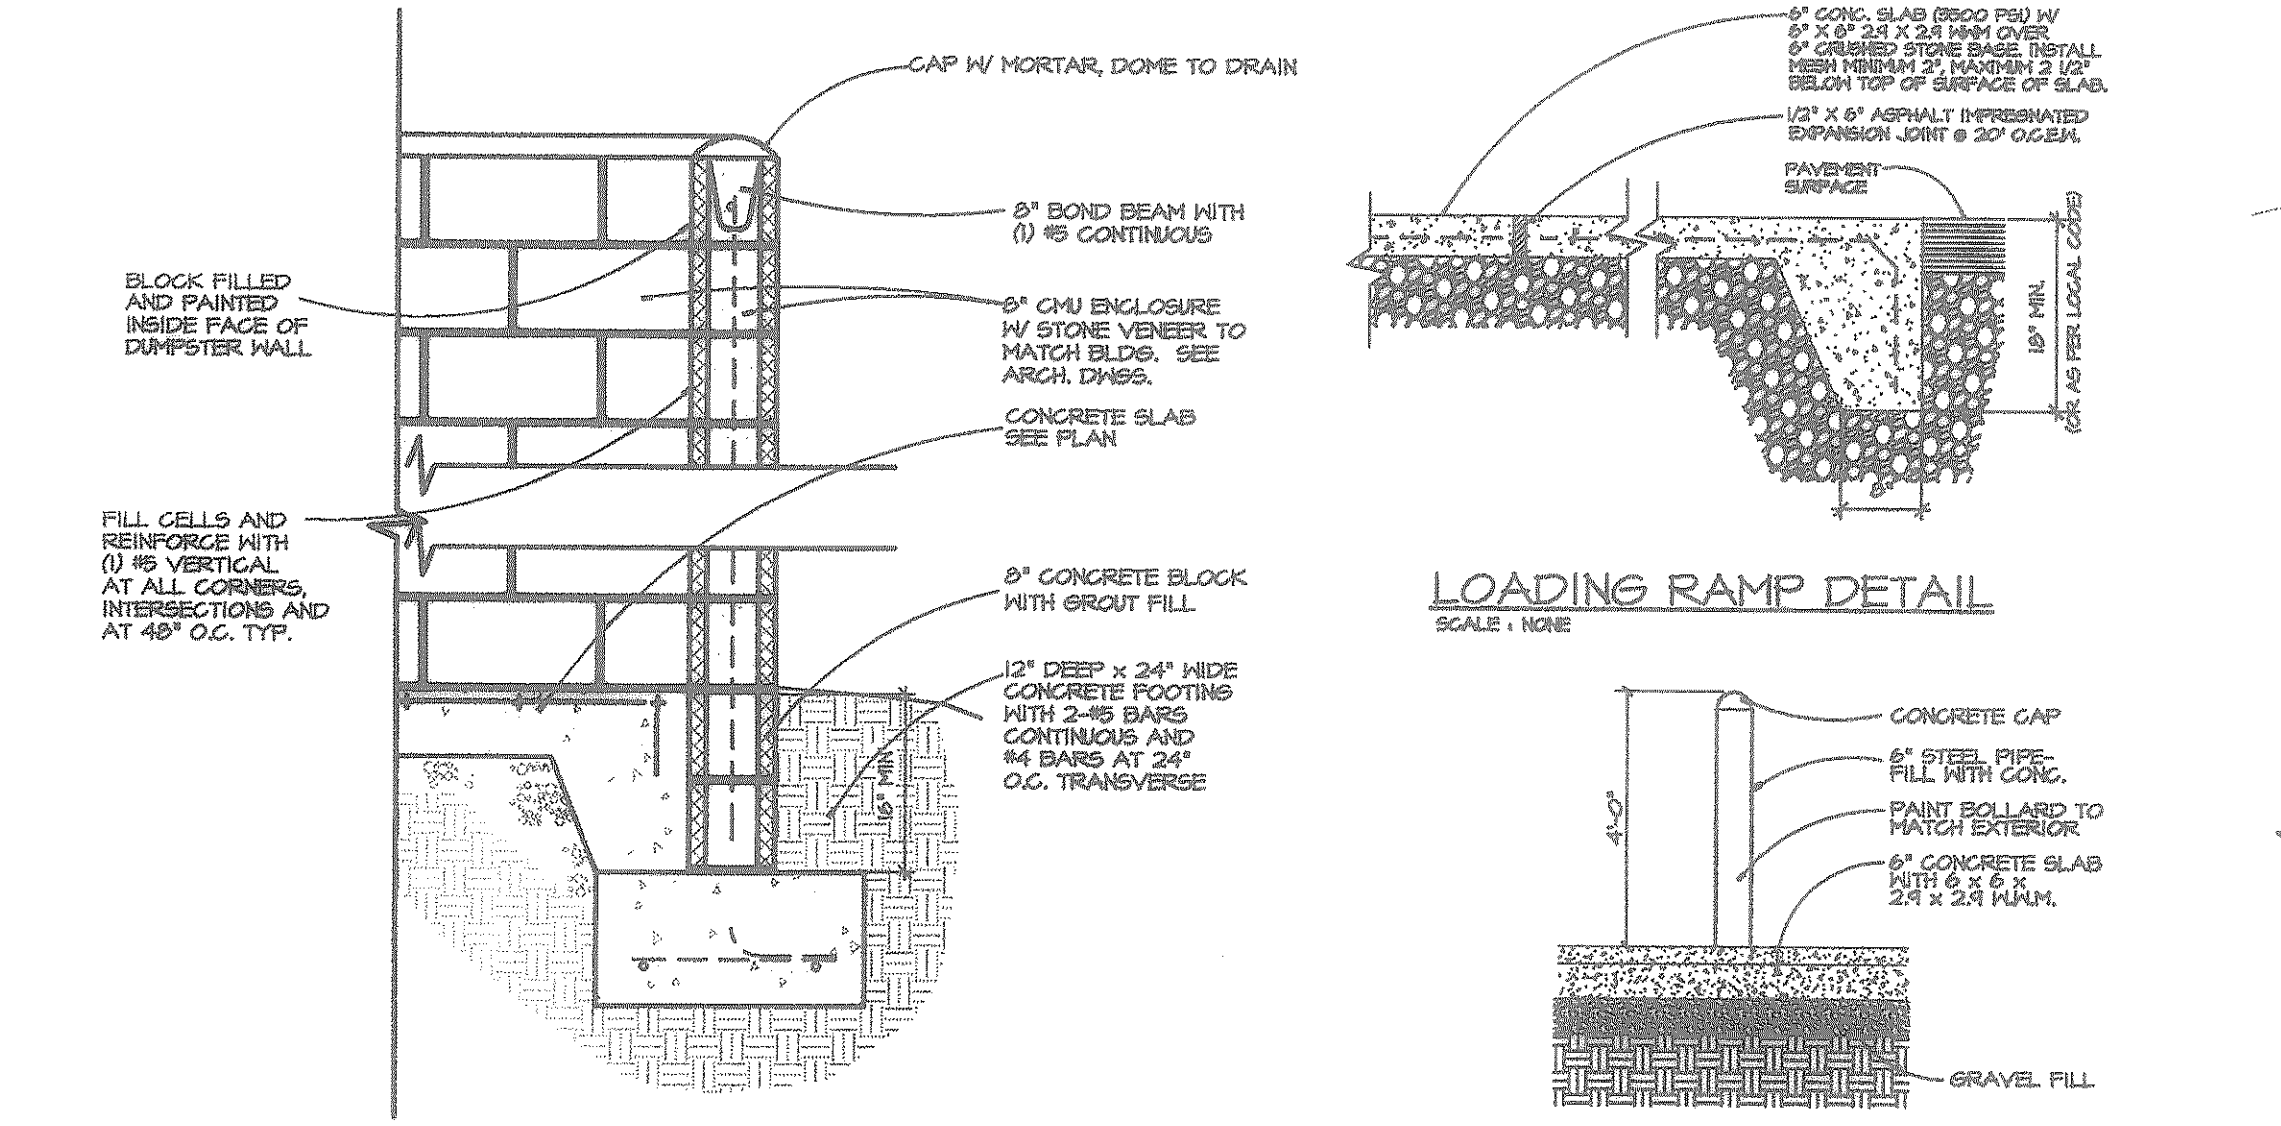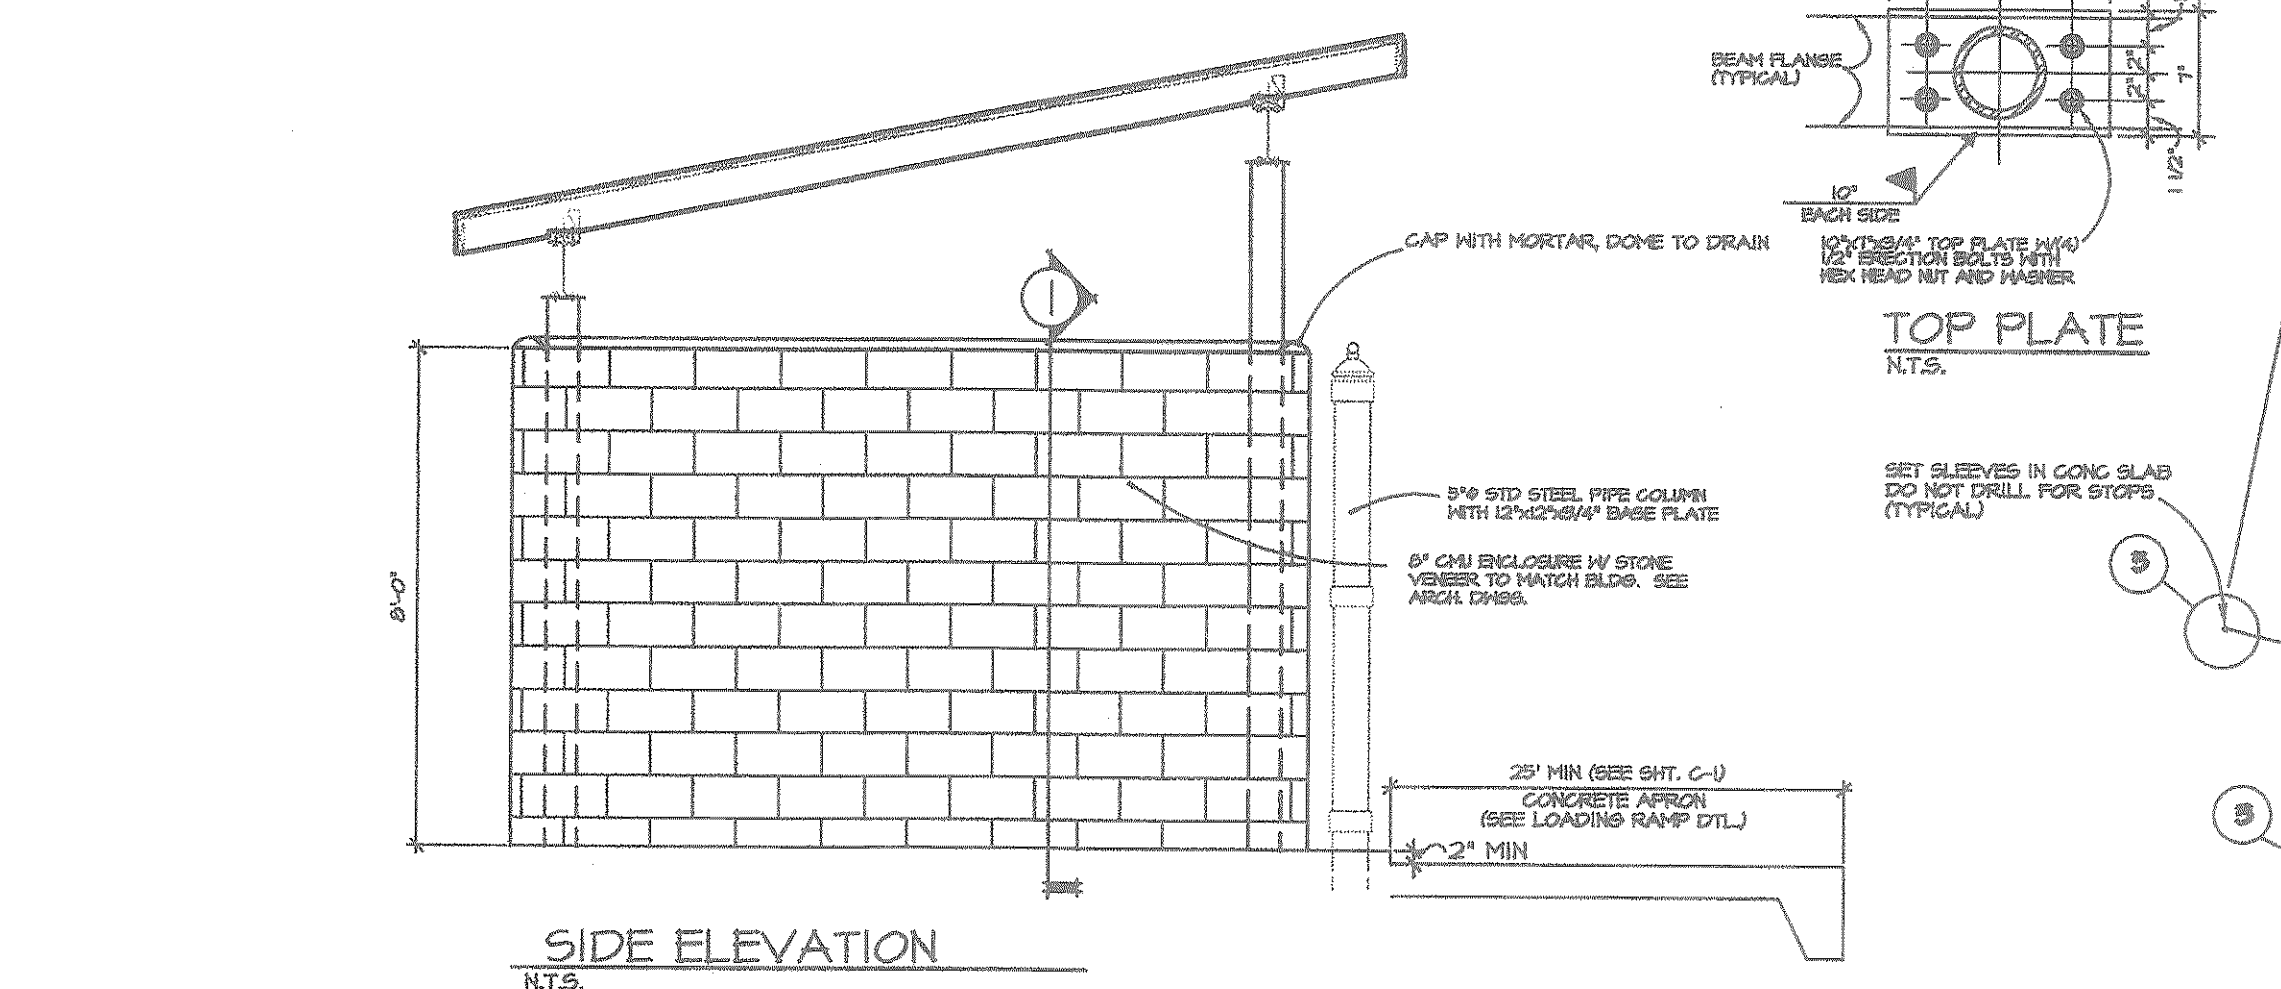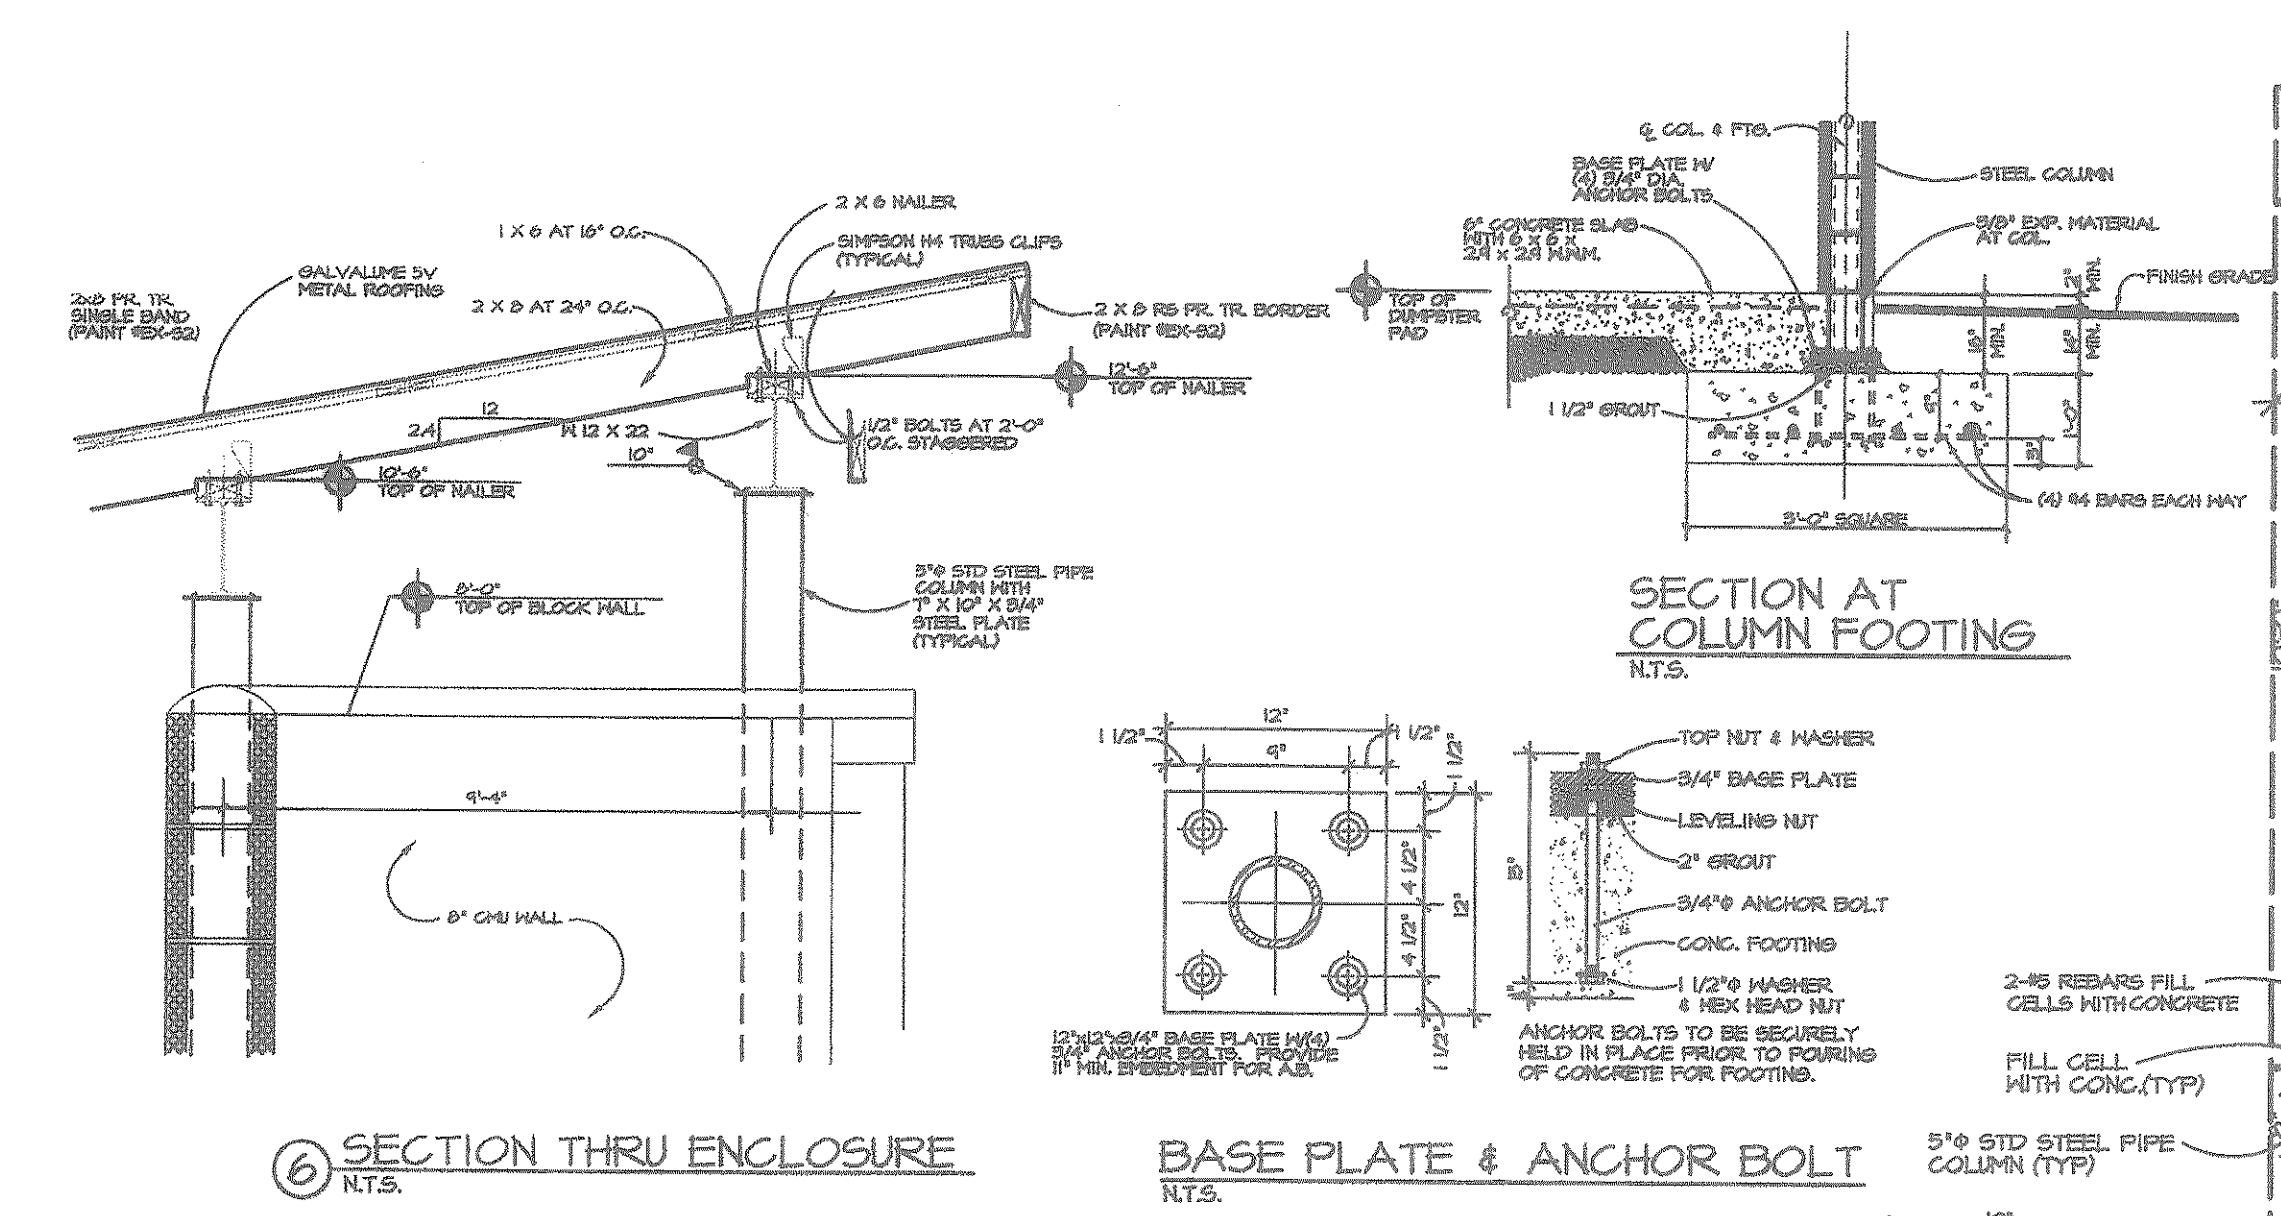

TO THE BEST OF OUR KNOWLEDGE, DESIGN AND ENGINEERING, INC. HEREBY STATES THAT THIS PLAN DEPICTS AS-BUILT CONSTRUCTION. THE INFORMATION PROVIDED IS BASED ON FIELD SURVEYING AT THE SITE ON JUNE 10, 2009.