
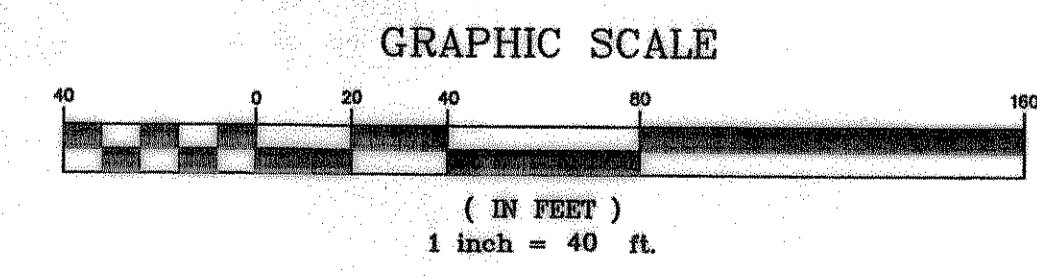


LEGEND

- EXPANSION JOINT
- TIED TONGUE & GROOVE JOINT
- - - SAW CUT

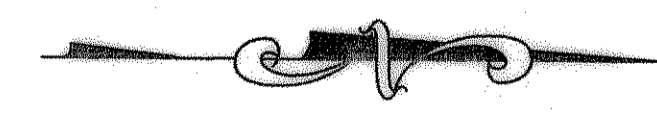


RECORD DRAWINGS:

THE INTENT OF THE OWNER AND ENGINEER WAS TO CONSTRUCT THESE FACILITIES ACCORDING TO THESE PLANS AS APPROVED BY THE CITY OF Rockwall. THE LINES AND GRADES WERE SET ON THE GROUND FOR CONSTRUCTION ACCORDING TO SAID PLANS. THE CITY OF Rockwall INSPECTED THE CONSTRUCTION. THE OWNER NOR ENGINEER DID NOT VERIFY LINES OR GRADES AFTER CONSTRUCTION. WE ARE NOT AWARE OF ANY CHANGES OR REVISIONS TO THESE PLANS DURING CONSTRUCTION EXCEPT AS NOTED

REVISED FOR CONSTRUCTION

CHANGED DETENTION POND & PARKING LAYOUT.
AUG. 30, 2000

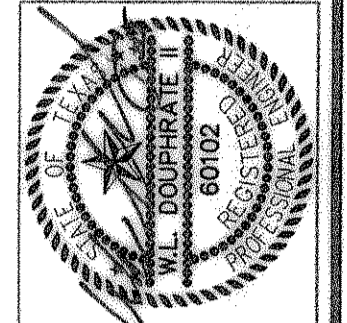

THE SEAL APPEARING ON THIS DRAWING IS THE PROPERTY OF W.L. DOUPHRATE, INC. NO. 80102 ON 8/14/00

DOUPHRATE & ASSOCIATES, INC.
ENGINEERING • PROJECT MANAGEMENT • SURVEYING
2235 RIDGE RD., # 200 ROCKWALL, TEXAS 75087
PHONE: (972)771-9004 FAX: (972)771-9005

EXPANSION & SAW JOINT PLAN
LOVE'S ADDITION NO. 1
CITY OF ROCKWALL
ROCKWALL COUNTY, TEXAS

- 1. REVISED AS PER ARCHITECT REVISIONS. 8/15/00
- 2. REVISED AS PER ARCHITECT COMMENTS. 8/23/00

REVISION	W.L.D. CHECKED
DRAWN	K.E.B.
DATE	3/10/00
PROJECT	0007PAVJT