


DEVELOPMENT PLANS
FOR
LYNDEN PARK ESTATES
PHASE IA
CITY OF ROCKWALL, TEXAS

INDEX


1	TITLE
2	PLAT
3	PLAT
4	DRAINAGE AREA MAP
4A	DRAINAGE AREA EXHIBIT
5	RALPH HALL PARKWAY
6	TUBBS ROAD
7	WRIGHT AVENUE & ALLEY C
8	HAMPSHIRE LANE & ALLEY D
9	SOUTHAMPTON DRIVE, ALLEY A & B
10	WEMBLEY WAY & ALLEY F
11	SOUTHWOOD DRIVE
12	SOUTHLAKE DRIVE
13	ALLEY PROFILES
14	ALLEY PROFILES
15	WATER AND SANITARY SEWER PLAN
16	SANITARY SEWER PROFILES
17	SANITARY SEWER PROFILES
18	STORM SEWER PLAN AND PROFILE LINE 'D-1'
19	STORM SEWER PLAN AND PROFILE LINE 'D-2' & 'D-6'
20	STORM SEWER PLAN AND PROFILE LINE 'D-3' & 'D-4'
21	STORM SEWER PLAN AND PROFILE LINE 'D-5'
22	GRADE TO DRAIN
23	GRADING PLAN
24	GRADING PLAN
1 OF 1	EROSION CONTROL PLAN

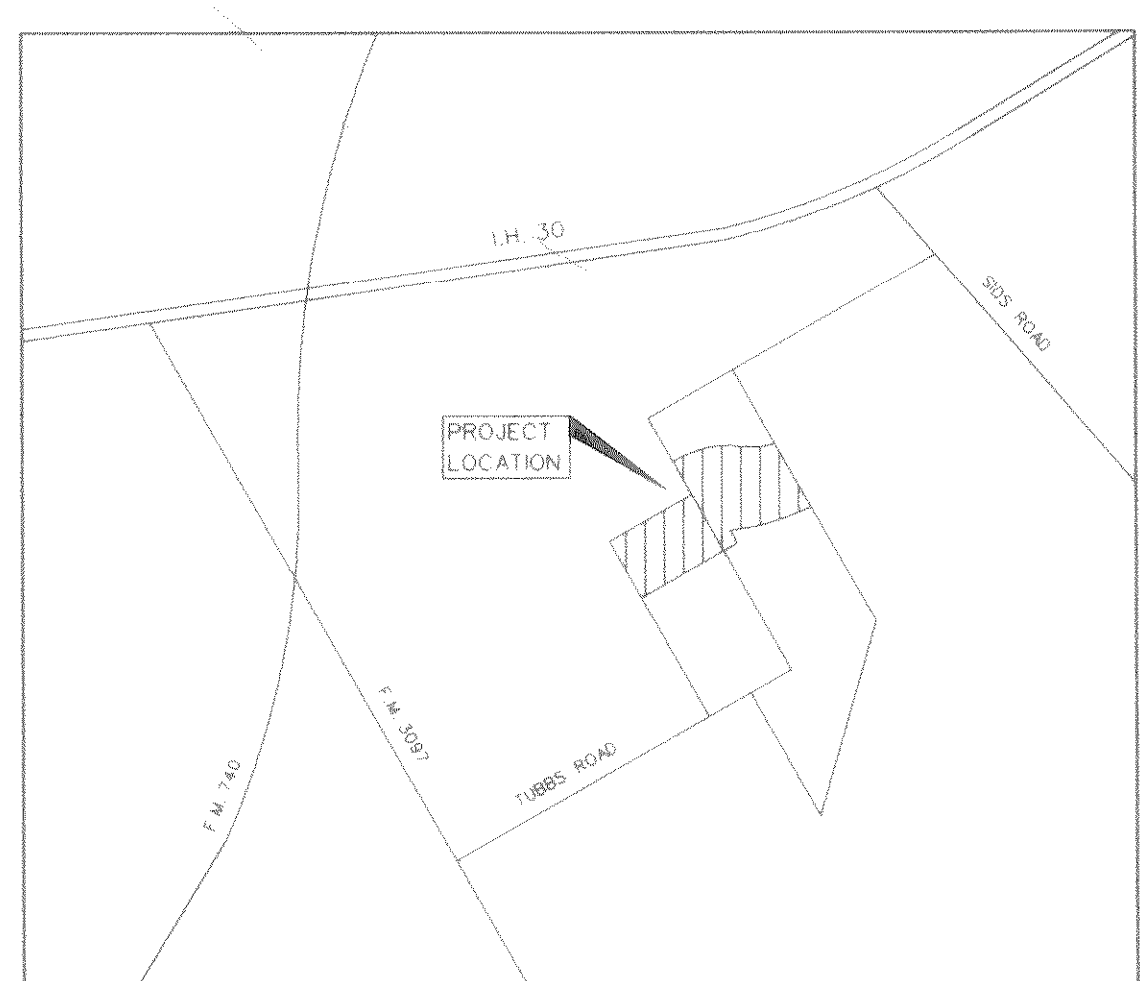

VICINITY MAP
NOT TO SCALE

PREPARED FOR
LYNDEN PARK ESTATES LIMITED PARTNERSHIP
P.O. BOX 92864 SOUTH LAKE, TEXAS 76092

CORWIN ENGINEERING, INC. — CONSULTING ENGINEERS
8131 LBJ FREEWAY, SUITE 333 DALLAS, TEXAS 75251

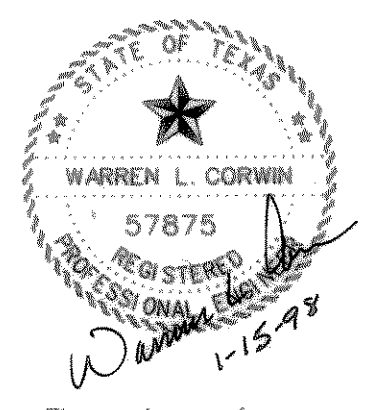

The seal appearing on this document was authorized by Warren L. Corwin, P.E. 57875, on January 15, 1998.

AS-BUILT JULY 1999
INFORMATION PROVIDED BY CONTRACTORS
(NOT FIELD VERIFIED)