


FILE: 9702ALLE.DGN
 VIEW:
 DATE:

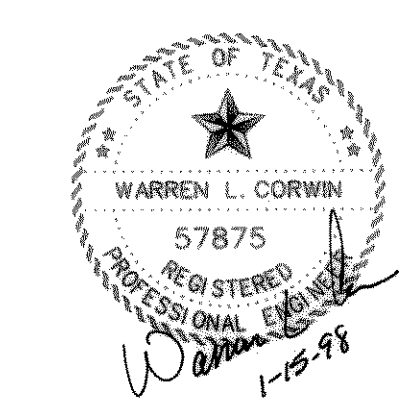

The seal appearing on
 this document was
 authorized by
 Warren L. Corwin,
 P.E. 57875, on
 January 15, 1998

AS-BUILT JULY 1999
 INFORMATION PROVIDED BY CONTRACTORS
 (NOT FIELD VERIFIED)

NO.	REVISIONS	BY	DATE

CORWIN ENGINEERING, INC.
 8131 LBJ FREEWAY, SUITE 333
 DALLAS, TEXAS 75251 (972) 480-0305

**DEVELOPMENT PLANS FOR
 LYNDEN PARK ESTATES PHASE IA
 ROCKWALL, TEXAS**

ALLEY PROFILES

DRAWN BY RDS	DESIGNED BY CEI	CHECKED BY CEI	SHEET NO. 13 OF 24
JOB NUMBER 9702	DATE JANUARY 1997	SCALE: 1"=4' V 1"=40' H	