




FILE: 9702ALLE.DGN
 VIEW:
 DATE:

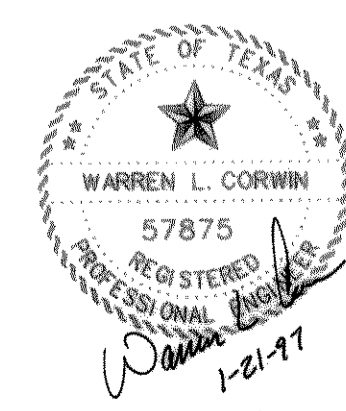

The seal appearing on this document was authorized by Warren L. Corwin, P.E. 57875, on January 21, 1997

AS-BUILT JULY 1999
 INFORMATION PROVIDED BY CONTRACTORS
 (NOT FIELD VERIFIED)

NO.	REVISIONS	BY	DATE

CORWIN ENGINEERING, INC.
 8131 LBJ FREEWAY, SUITE 333
 DALLAS, TEXAS 75251 (972) 480-0305

DEVELOPMENT PLANS FOR
LYNDEN PARK ESTATES PHASE IA
 ROCKWALL, TEXAS

ALLEY PROFILES

DRAWN BY RDS	DESIGNED BY CEI	CHECKED BY CEI	SHEET NO. 14 OF 24
JOB NUMBER 9702	DATE JANUARY 1997	SCALE: 1"=4' V 1"=40' H	