

FILE: 9702 SANDON
 REF FILE:
 VIEW:
 DATE:



1	REVISED S-1 & S-2	CF	6-18-97
NO.	REVISIONS	BY	DATE


BENCHMARK:
 "□" cut on top of curb, center of inlet on the Northwest side of Rockwall Pkwy. approx. 140' Northeast of Woodcreek Dr.
 ELEVATION = 527.25

CORWIN ENGINEERING, INC.
 8131 LBJ FREEWAY, SUITE 333
 DALLAS, TEXAS 75251 (972) 480-0305

DEVELOPMENT PLANS FOR
LYNDEN PARK ESTATES PHASE IA
 ROCKWALL, TEXAS

SANITARY SEWER PROFILES
 LINES S-1, S-2, & S-3

DRAWN BY PJB	DESIGNED BY CEI	CHECKED BY CEI	SHEET NO. 16 OF 24
JOB NUMBER 9702	DATE JANUARY 1997	SCALE: P=4" V 1"=40' H	

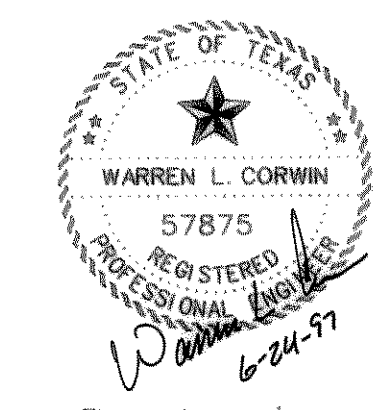

The seal appearing on this document was authorized by Warren L. Corwin, P.E. 57875, on June 24, 1997

AS-BUILT JULY 1999
 INFORMATION PROVIDED BY CONTRACTORS
 (NOT FIELD VERIFIED)