




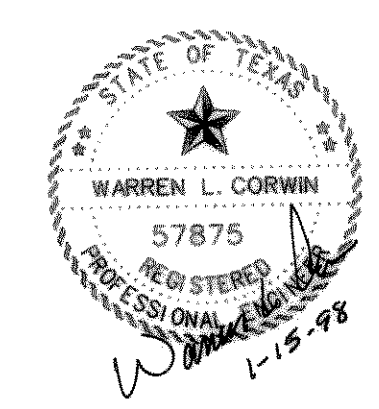
LEGEND

-  DRAINAGE AREA
-  DRAINAGE AREA LINE
-  FLOW AREA



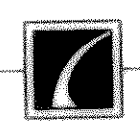
- NOTES:
1. ALL DRAINAGE CALCULATIONS SHOWN ARE APPROXIMATE AND ARE NOT INTENDED TO BE USED FOR DESIGN PURPOSES.
  2. DRAINAGE AREAS 1-3 SHALL BE PICKED UP BY FUTURE STORM SYSTEM CONSTRUCTED WITH THE NORTHWEST LANES OF RALPH HALL PARKWAY.
  3. DRAINAGE AREA CRITERIA  
 $C = 0.50$   
 $I = 9.80$

FILE: 9702WS.DGN  
 REF FILE: 9702AL.DGN  
 VIEW:  
 DATE:



The seal appearing on this document was authorized by Warren L. Corwin, P.E. 57875, on January 15, 1998

**AS-BUILT JULY 1999**  
 INFORMATION PROVIDED BY CONTRACTORS  
 (NOT FIELD VERIFIED)

			
CORWIN ENGINEERING, INC. 8131 LBJ FREEWAY, SUITE 333 DALLAS, TEXAS 75251 (972) 480-0305			
DEVELOPMENT PLANS FOR <b>LYNDEN PARK ESTATES PHASE 1A</b> ROCKWALL, TEXAS			
DRAINAGE AREA EXHIBIT			
DRAWN BY CMF	DESIGNED BY CEI	CHECKED BY CEI	SHEET NO. 4A OF 24
JOB NUMBER 9702	DATE JANUARY 1997	SCALE 1" = 100'	