


Notes!!
 1. 7"-5"-7" Thick, 4000 P.S.I. Reinforced Concrete Pavement, No. 3 Bars @ 24" O.C. Eachway.
 2. 6" Lime Stabilized Subgrade - Compacted To A Density Not Less Than 95% Std. Proctor.

NOTES:
 1. FILL COMPACTION BY SHEEPSFOOT ROLLER.
 2. MINIMUM CONCRETE SHALL BE 6 SACK (3500PSI) FOR MACHINE POURS AND 6.5 SACK FOR HAND POURS

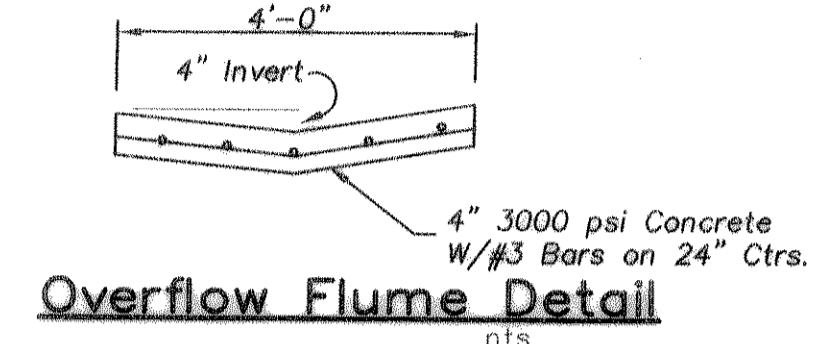


Overflow Flume Detail

Bench Mark 1
 A Standard U.S.C.&G.S. Disk Stamped 'M 929 1946'
 Approx. 1.9 miles southeast along State Hwy. 205 from Courthouse at Rockwall to bridge at Buffalo Creek, at the northwest corner of the concrete bridge in the top of the concrete guardrail base approx. 17 feet southwest of the centerline of the highway, and approx. 3 feet southeast of the northwest end of the guardrail base.
 Elevation = 524.65
 Bench Mark 2
 Top of Concrete ROW Marker, approx. 1.6 miles southeast along State Hwy. 205 and then approx. 0.6 miles east along FM 276 to intersection of paved road, at fence corner at southwest quadrant of intersection.
 Elevation = 543.10

Note!!
 Construct Barrier Free Ramps At All Intersection As Per City Standards.

CAUTION !!!
 EXISTING UTILITIES

EXISTING UTILITIES AND UNDERGROUND FACILITIES INDICATED ON THESE PLANS HAVE BEEN LOCATED FROM REFERENCE INFORMATION. IT SHALL BE THE RESPONSIBILITY OF THE CONTRACTOR TO VERIFY BOTH HORIZONTALLY AND VERTICALLY THE LOCATION OF ALL EXISTING UTILITIES AND UNDERGROUND FACILITIES PRIOR TO CONSTRUCTION, TO TAKE NECESSARY PRECAUTIONS IN ORDER TO PROTECT ALL FACILITIES ENCOUNTERED. THE CONTRACTOR SHALL PRESERVE AND PROTECT ALL EXISTING UTILITIES FROM DAMAGE DURING CONSTRUCTION.

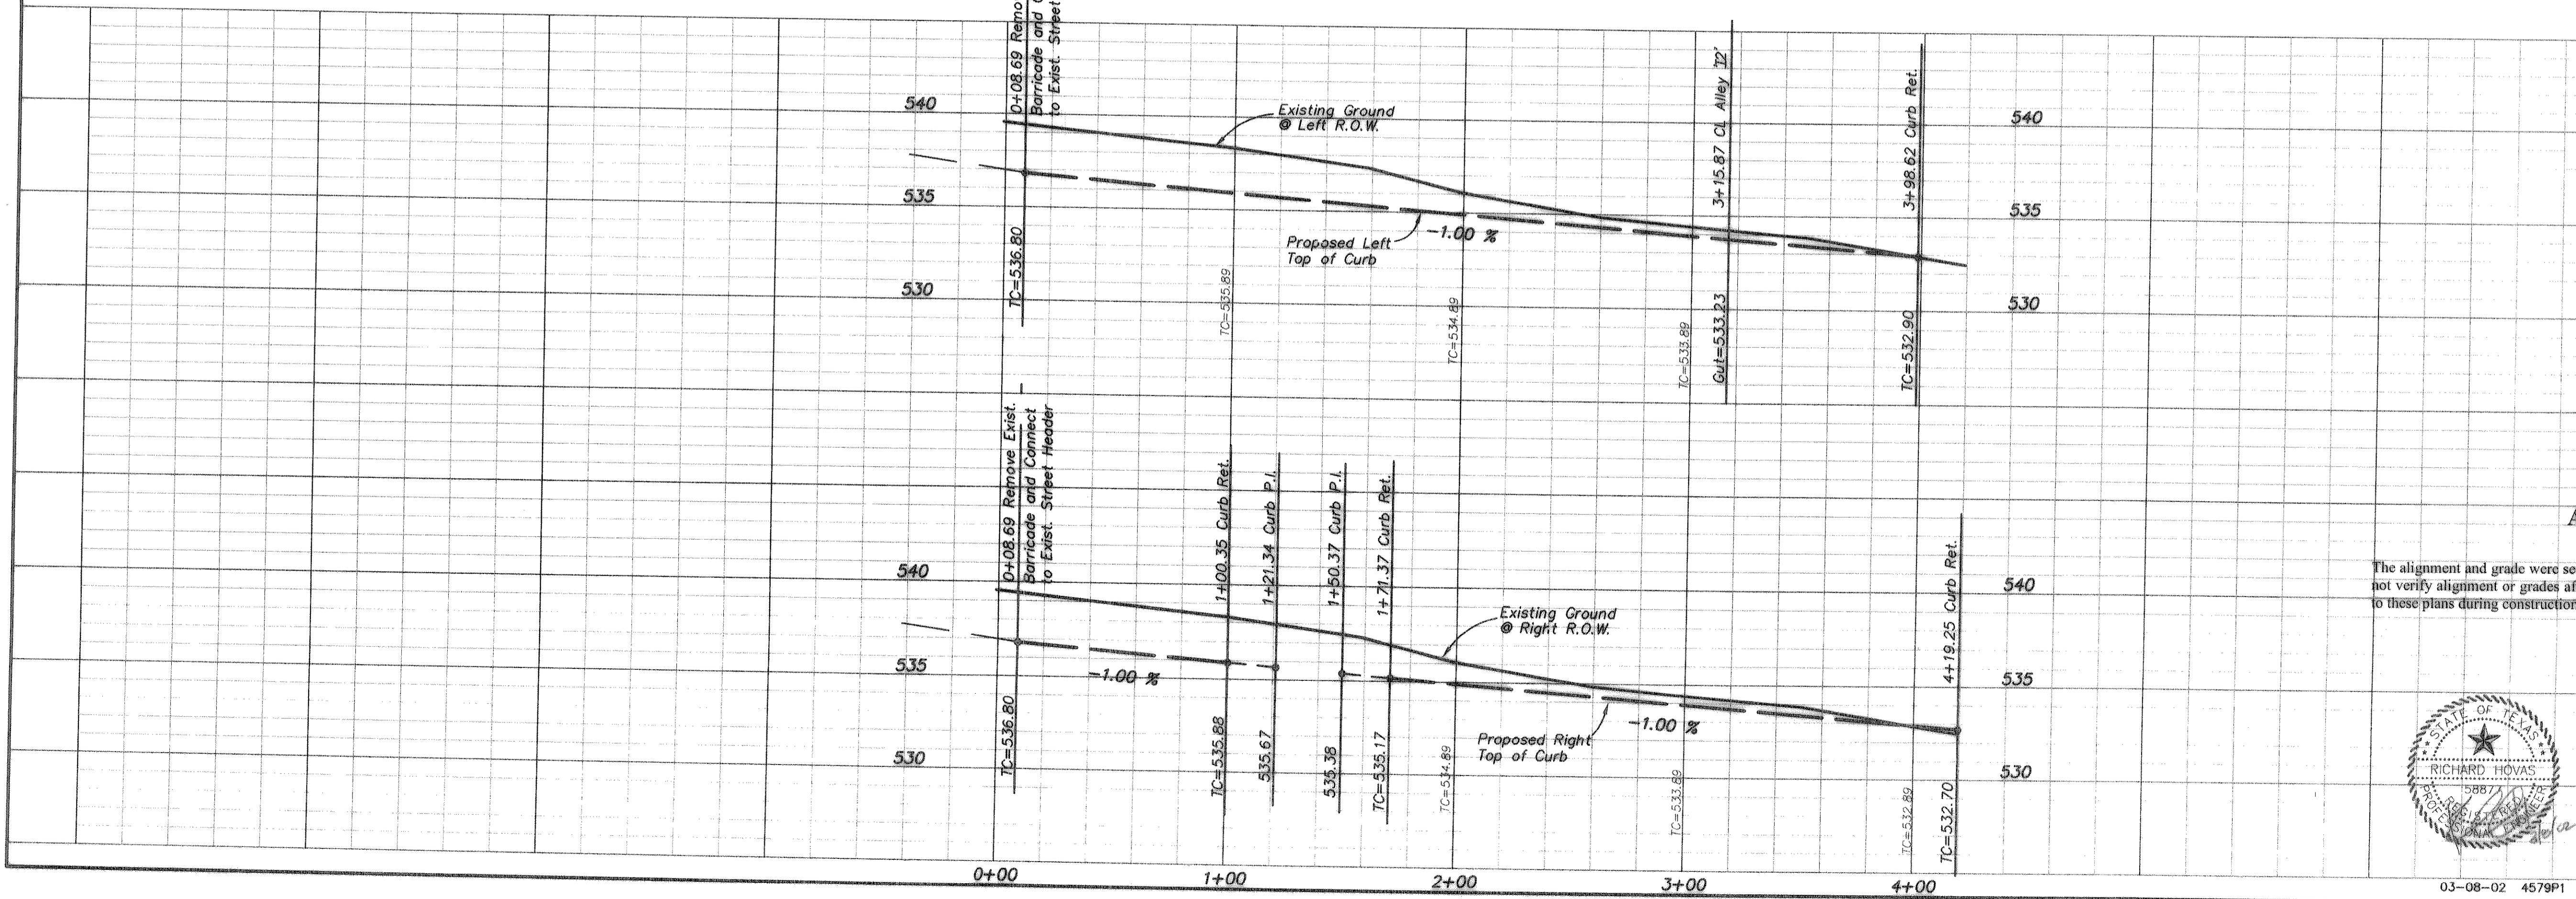

AS BUILT PLANS
 10/04/02

The alignment and grade were set on the ground for construction per the plans. The engineer did not verify alignment or grades after construction. We are not aware of any changes or revisions to these plans during construction except as noted.


Brookshore Drive & Alleys 'I' & 'J'

PAVING PLAN
 LYNDEN PARK ESTATES PHASE 3

City of Rockwall, Texas

TIPTON ENGINEERING, INC.

6330 Broadway Blvd. ~ Suite C ~ Garland, Texas 75043

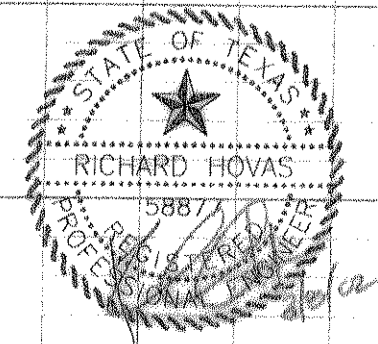

DESIGN	DRAWN	DATE	SCALE	NOTES	FILE	NO.
T.E. Inc.	T.E. Inc.	03/00	1"=40'H 1"=5'V		4579	3

03-08-02 4579P1