


AS BUILT PLANS
1/12/2005

The alignment and grade were set on the ground for construction per the plans. The engineer did not verify alignment or grades after construction. We are not aware of any changes or revisions to these plans during construction except as noted.

Bench Mark 1
A. Stensford U.S.C.&G.S. Disk Stamped 'M 929 1946'
Approx. 1.9 miles southeast along State Hwy. 205
from Courthouse at Rockwall to bridge at Buffalo
Creek, at the northwest corner of the concrete
bridge in the top of the concrete guardrail base
approx. 17 feet southwest of the centerline of the
highway, and approx. 3 feet southeast of the northwest
end of the guardrail base.
Elevation = 524.65
Bench Mark 2
Top of Concrete ROW Marker, approx. 1.6 miles
southwest along State Hwy. 205 and then approx.
0.6 miles east along FM 276 to intersection of
paved road, at fence corner at southwest quadrant
of intersection.
Elevation = 543.10

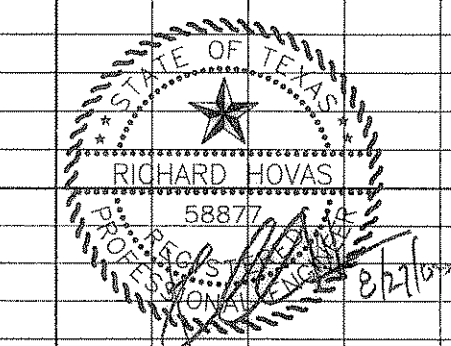

Alley Profiles	
Lynden Park Estates Phase 4	
City of Rockwall, Texas	
TIPTON ENGINEERING, INC.	
6330 Broadway Blvd. ~ Suite C ~ Garland, Texas 75043	
DESIGN	NO. 10
DRAWN	FILE 4580
DATE	SCALE 1"=40' Hor 1"=5' Vert
NOTES	8-2002
FILE	4580
NO.	10