



NORTH STAR REALTY LTD.
VOL. 912, PG. 213
26.023 ACRES

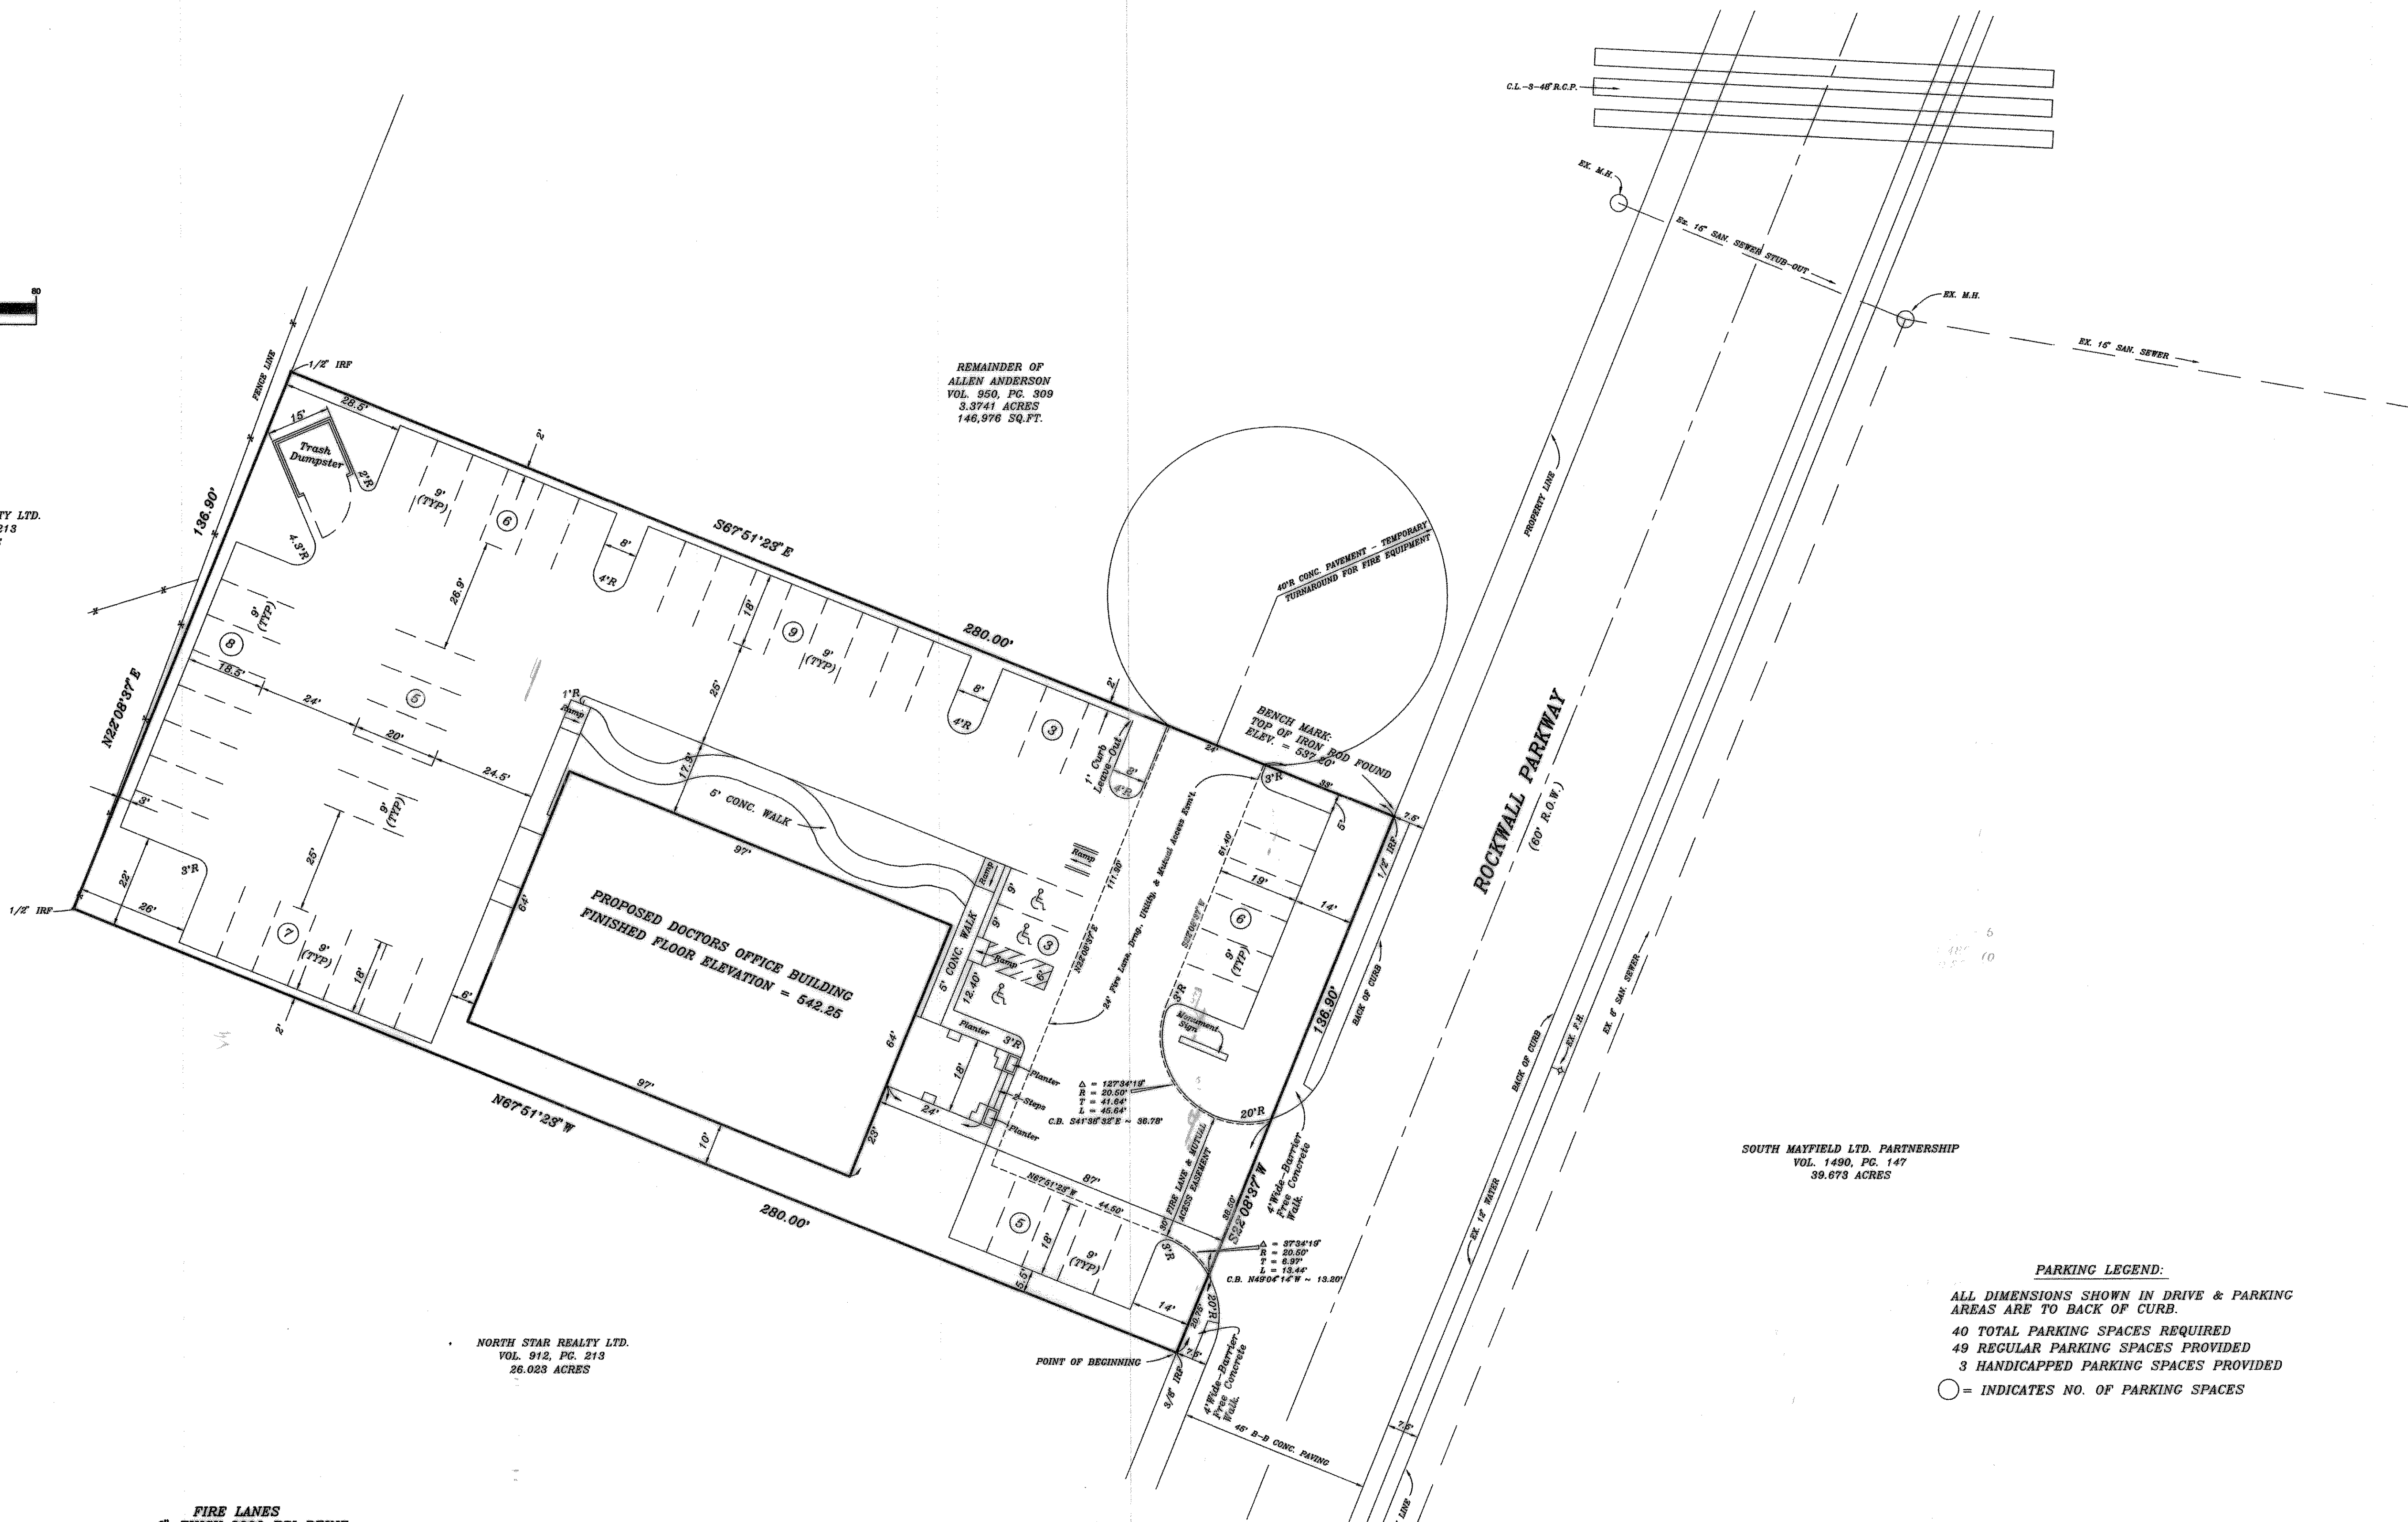


REMAINDER OF
ALLEN ANDERSON
VOL. 950, PG. 309
3.3741 ACRES
146,976 SQ. FT.

SOUTH MAYFIELD LTD. PARTNERSHIP
VOL. 1490, PG. 147
39.673 ACRES

PARKING LEGEND:
ALL DIMENSIONS SHOWN IN DRIVE & PARKING
AREAS ARE TO BACK OF CURB.
40 TOTAL PARKING SPACES REQUIRED
49 REGULAR PARKING SPACES PROVIDED
3 HANDICAPPED PARKING SPACES PROVIDED
○ = INDICATES NO. OF PARKING SPACES

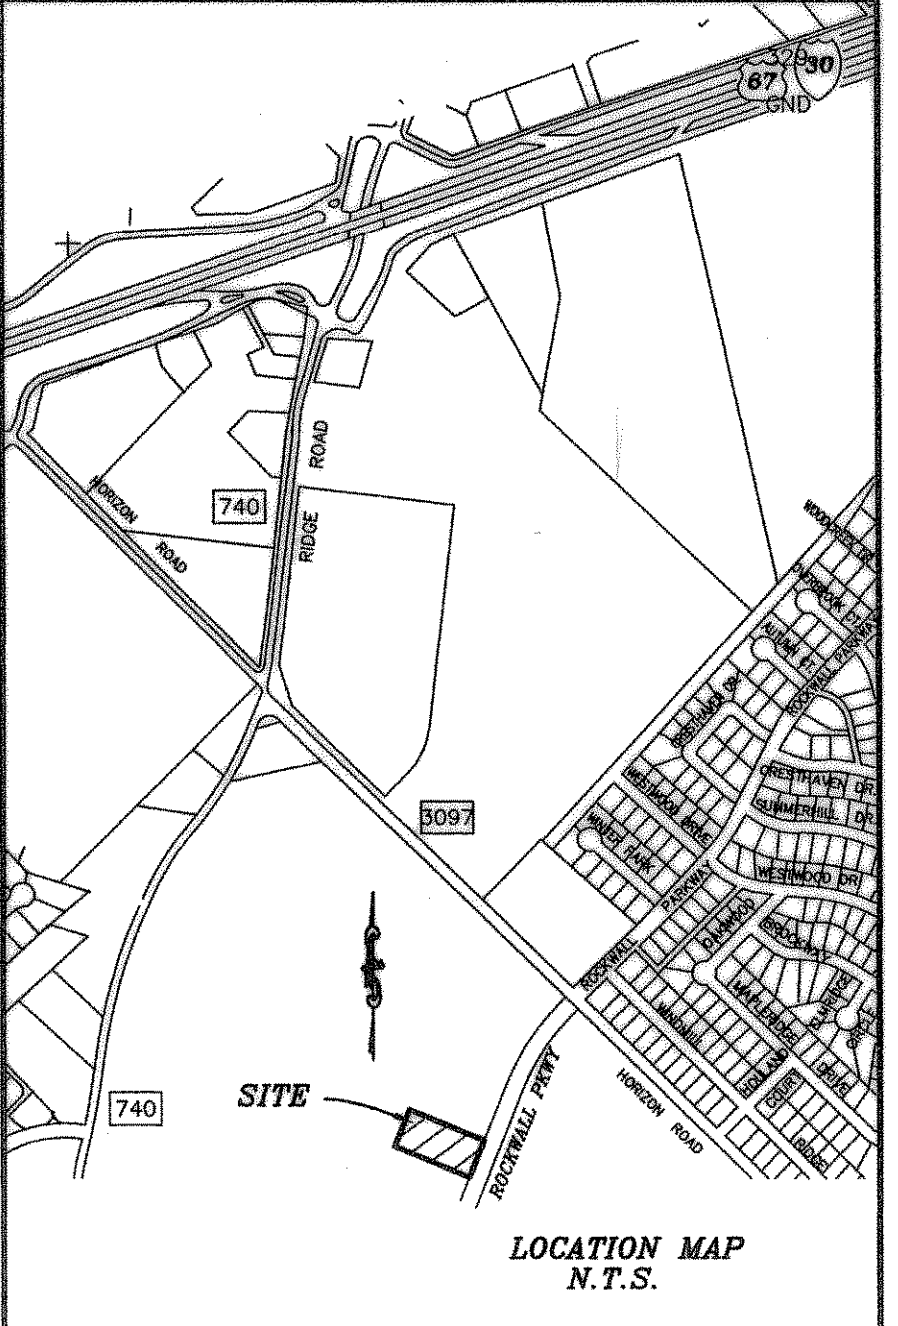

LOCATION MAP
N.T.S.

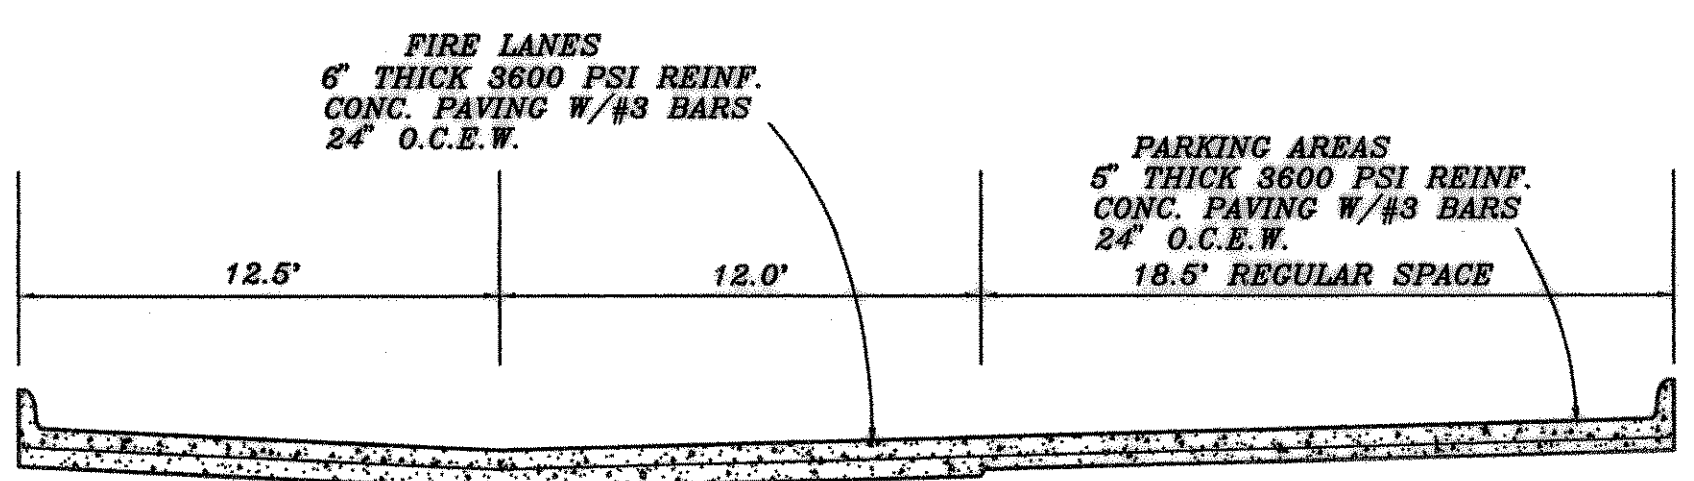

TYPICAL PAVING DETAIL



4. As - Built Survey 7-12-2001

1. Revisions requested by City of Rockwall - per First Review.	8-07-2000
2. Revisions - City of Rockwall & Fred Wynn Architect.	9-15-2000
3. Revisions requested by City of Rockwall - per Second Review.	10-02-2000

HAROLD L. EVANS
CONSULTING ENGINEER
P.O. BOX 28355
2331 GUS THOMASSON ROAD, SUITE 102
DALLAS, TEXAS 75228, (214) 328-8133

REVISION DESCRIPTION	DATE	SCALE	DESIGN	DRAWN
	7-08-00	1" = 20'	H.L.E.	L.W.C.

AS BUILT

SITE & DIMENSION CONTROL PLAN
M.R.P. ADDITION
CITY OF ROCKWALL

SHEET NO.	3
JOB NO.	0050