


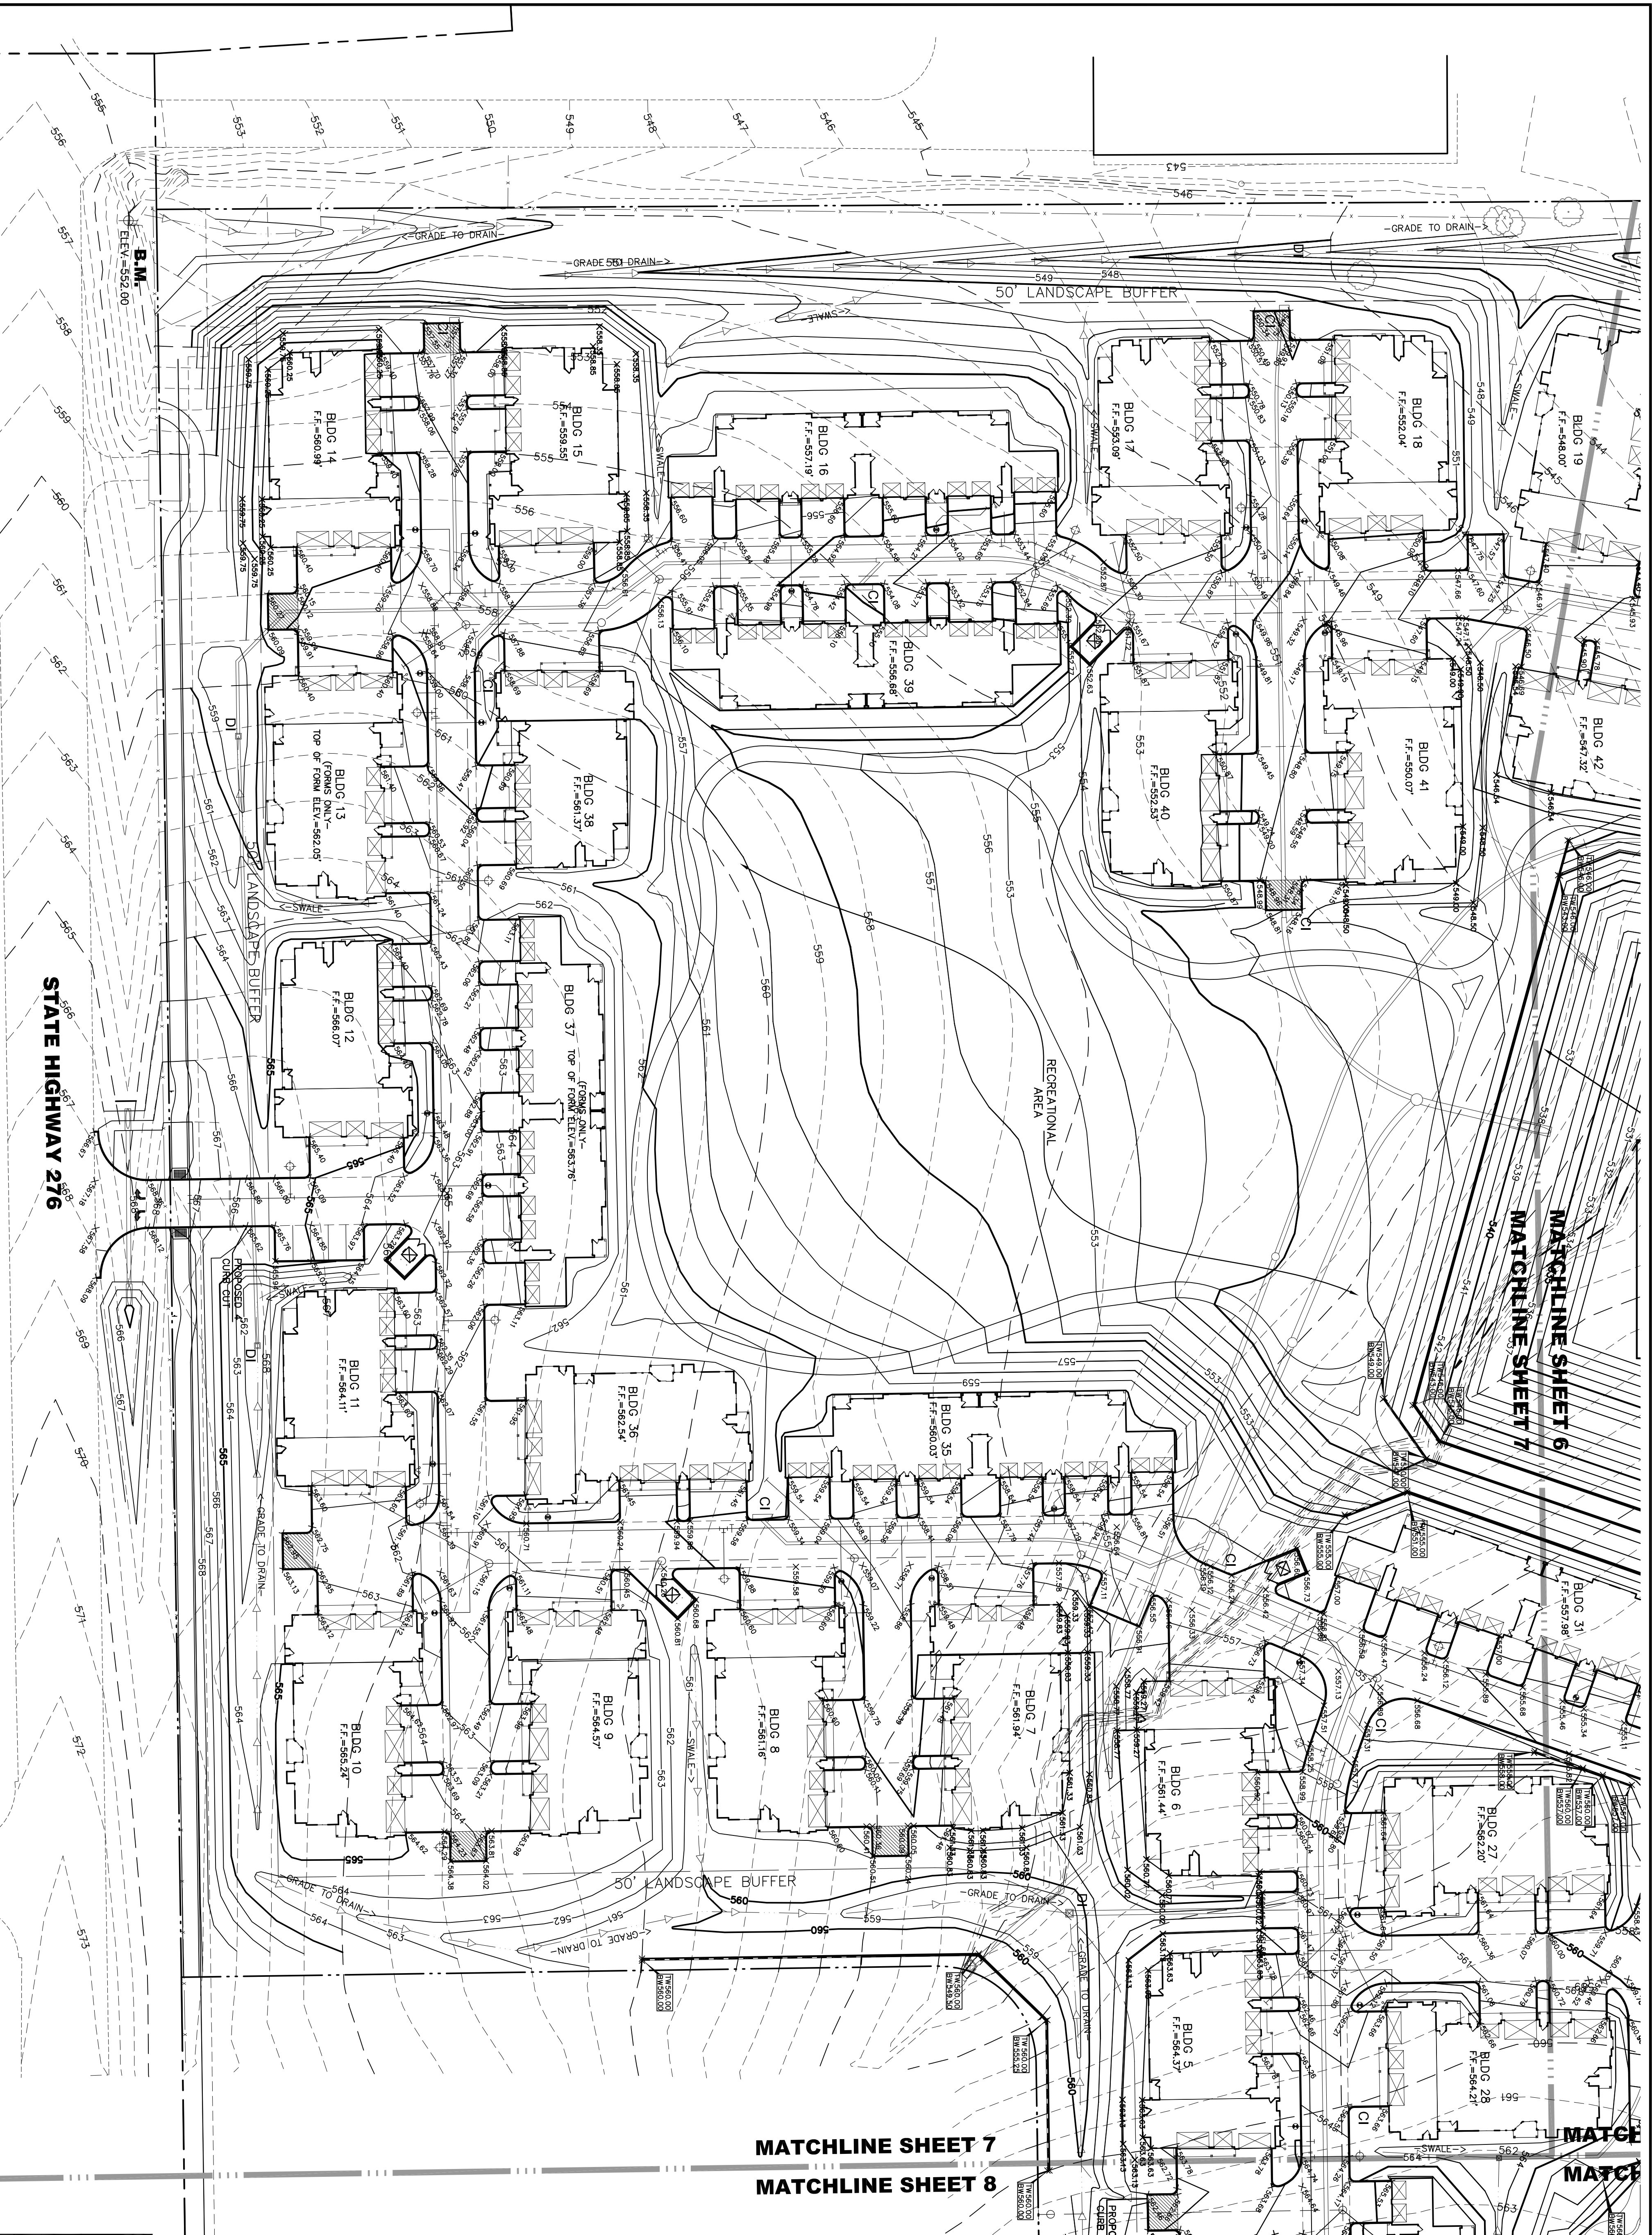


MATCHLINE SHEET 7

MATCHLINE SHEET 8

ALL SPOT GRADE SHOWN ARE TOP OF PAVEMENT UNLESS NOTED OTHERWISE.

LEGEND	
— 536 —	EXISTING MINOR CONTOUR
— 535 —	EXISTING MAJOR CONTOUR
— 536 —	PROPOSED MINOR CONTOUR
— 535 —	PROPOSED MAJOR CONTOUR
X 535.00	PROPOSED TP (U.I.O.)
FTE 548.08	PROPOSED FINISH FLOOR ELEVATION
CI	PROPOSED CURB INLET
DI	PROPOSED DRAIN INLET
	PROPOSED STORM SEWER

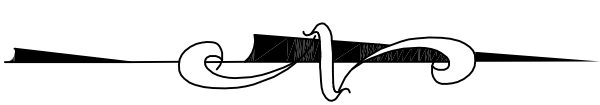

TOCS
1-800-245-4545
bticket@1-call.com



MANSIONS FAMILY - ROCKWALL, RKMCE PROJECT # 1026-005

RECORD DRAWING
RECORD INFORMATION PROVIDED BY
CONASTER CONSTRUCTION, FORT WORTH, TEXAS
ELEVATION VERIFICATION PERFORMED BY
SURVEY CONSULTANTS, INC., PLANO, TEXAS

NOTES:

1. PRIOR TO ACCEPTANCE, THE WALL ENGINEER WILL NEED TO SUBMIT A SIGNED AND SEALED LETTER STATING THAT THE WALL WAS INSPECTED DURING CONSTRUCTION AND AFTER AND IS BUILT PER DESIGN.
2. NO PART OF THE WALL (THE BLOCKS, FOOTINGS, ETC.) CAN BE IN A EASEMENT, RIGHT-OF-WAY, OR OFF-SITE.
3. REFER TO SHEET 10 FOR DETAILED DETENTION POND GRADING.



REV.	DATE	REMARKS	BY

GRADING PLAN

MANSIONS FAMILY

CITY of ROCKWALL, TEXAS

RKM Consulting Engineers, Inc.

Dallas, Texas 75251
Copyright © 2009 RKM Consulting Engineers, Inc.

CHECKED	DESIGN	DRAWN	JOB	DATE	SCALE
---------	--------	-------	-----	------	-------

RKM	JRY	JRY	1026-005	05/27/09	1"=40'

OF 33