

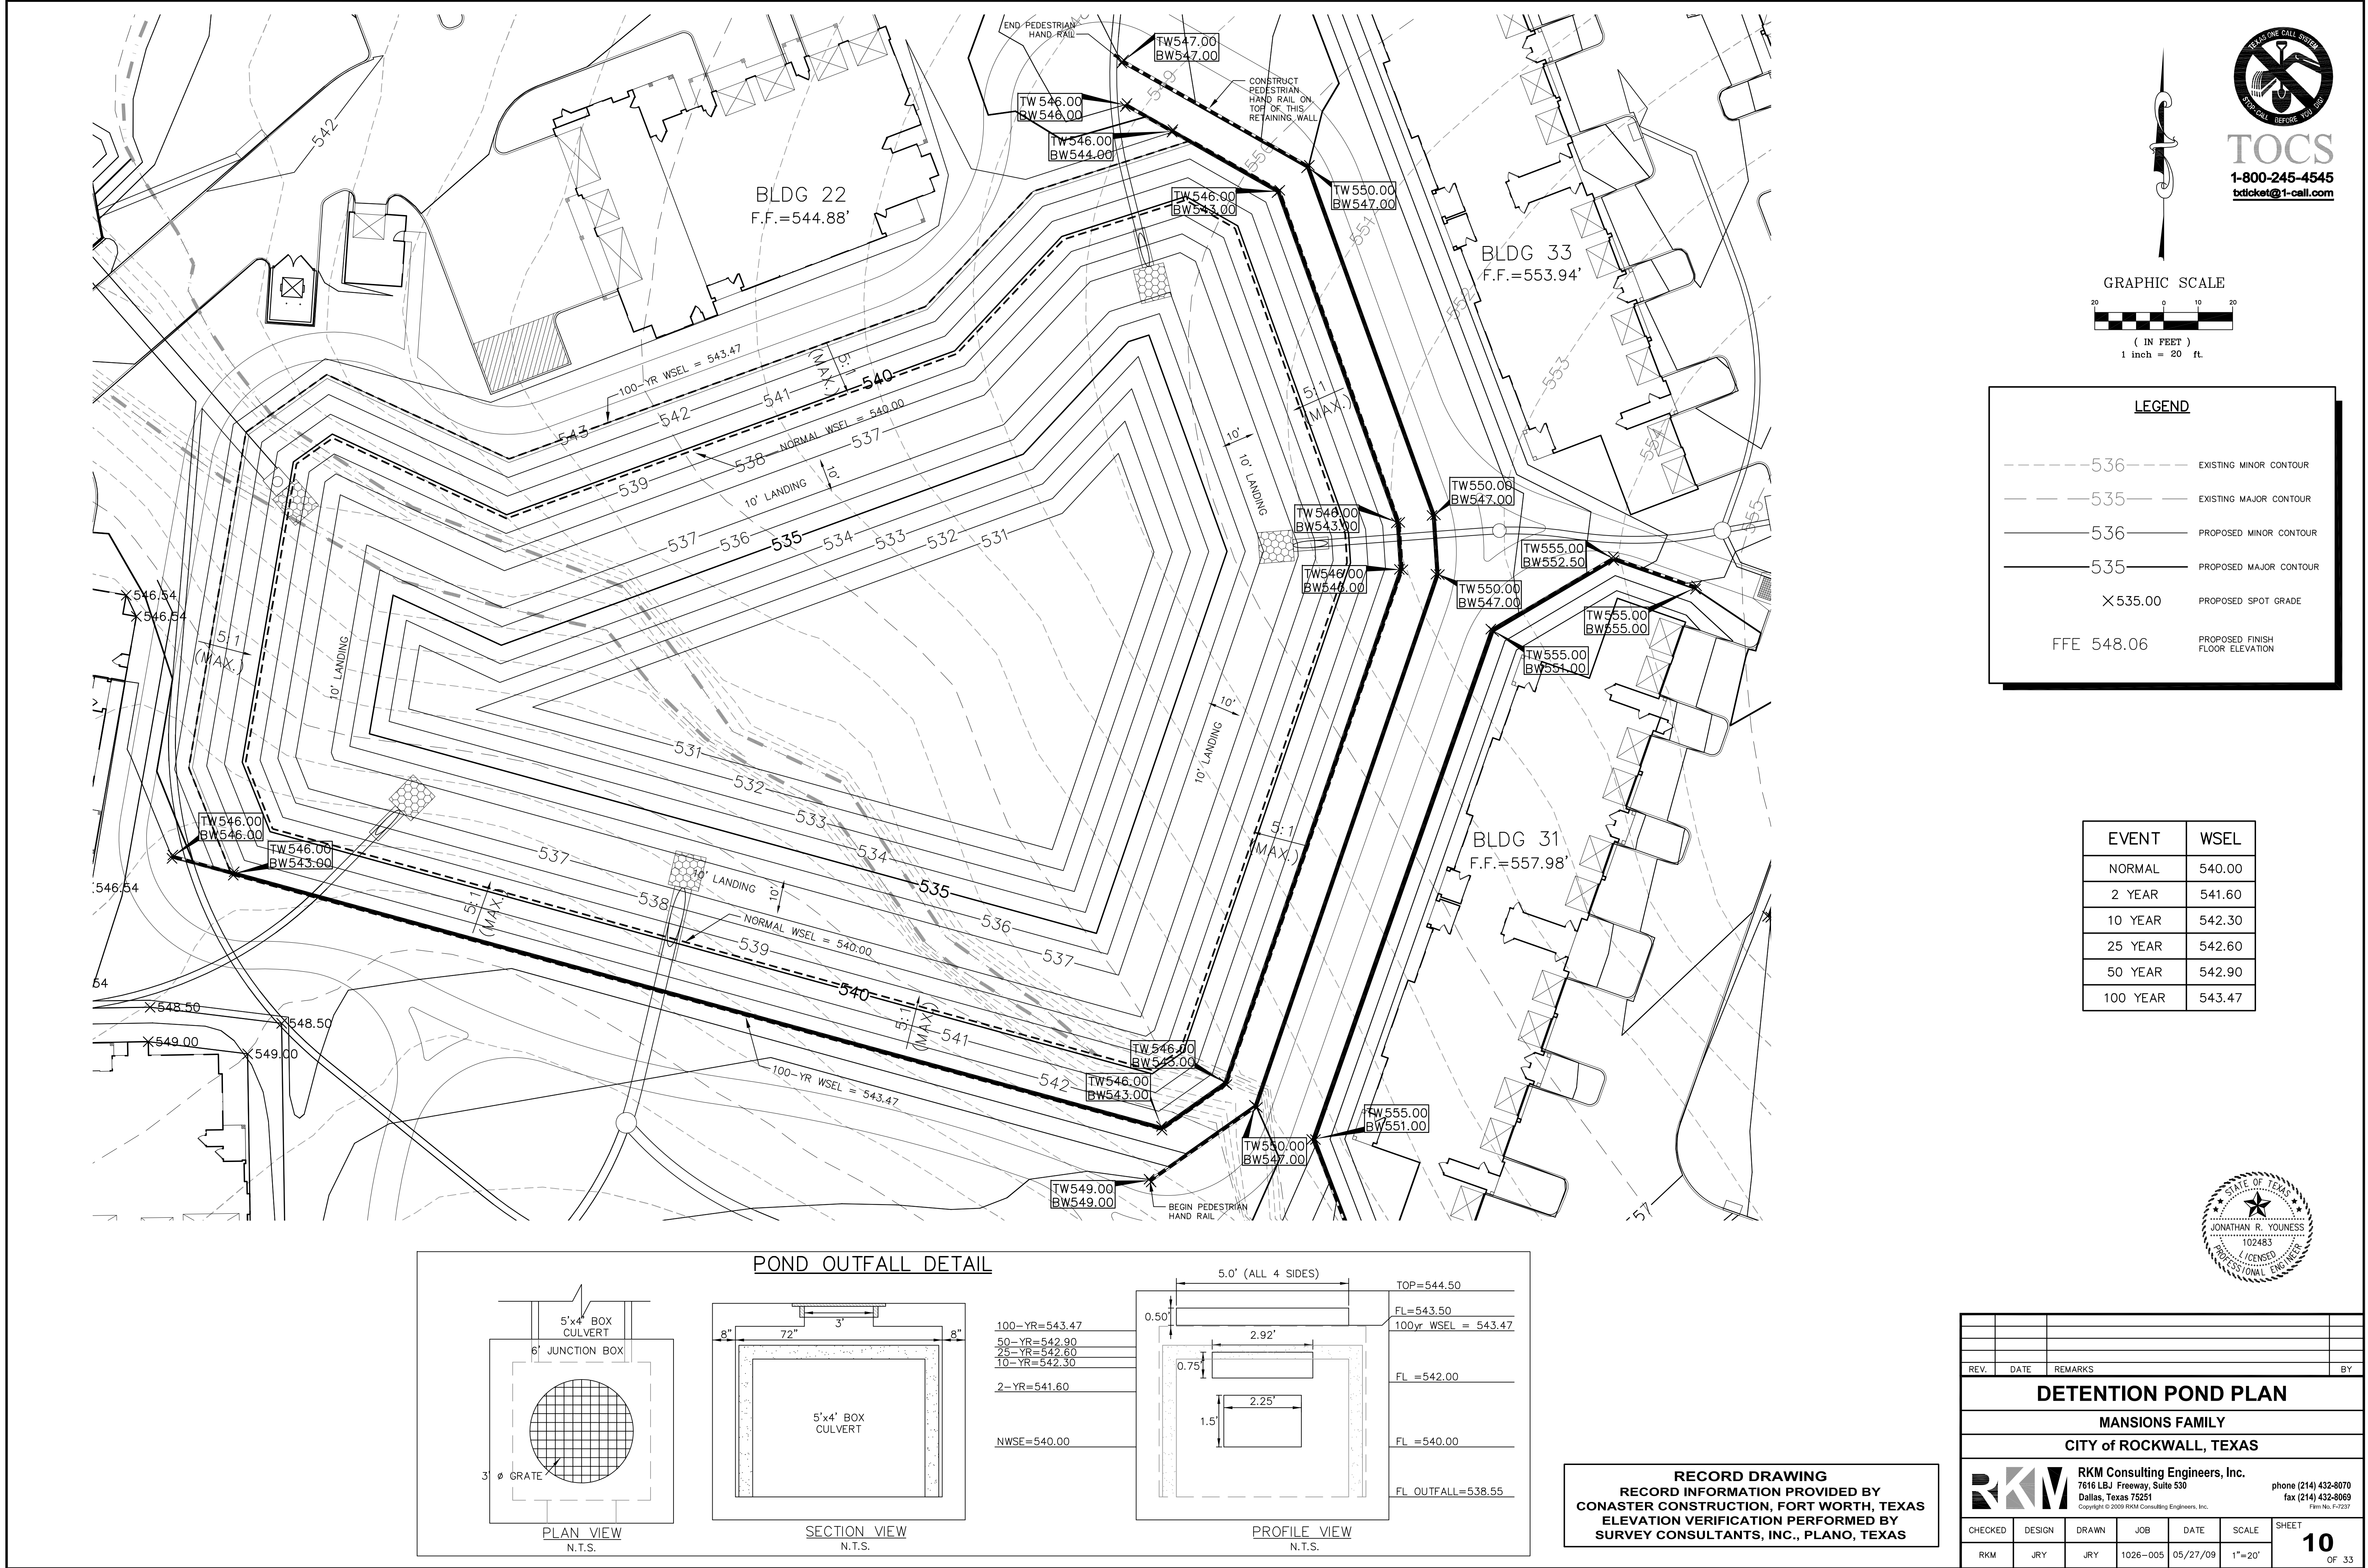
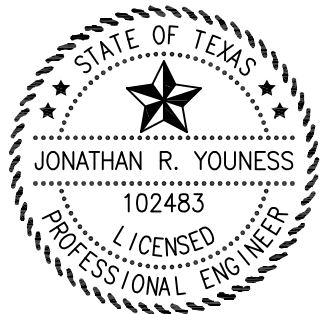


LEGEND	
---	EXISTING MINOR CONTOUR
- - -	EXISTING MAJOR CONTOUR
---	PROPOSED MINOR CONTOUR
- - -	PROPOSED MAJOR CONTOUR
X	PROPOSED SPOT GRADE
FFE 548.06	PROPOSED FINISH FLOOR ELEVATION


EVENT	WSEL
NORMAL	540.00
2 YEAR	541.60
10 YEAR	542.30
25 YEAR	542.60
50 YEAR	542.90
100 YEAR	543.47

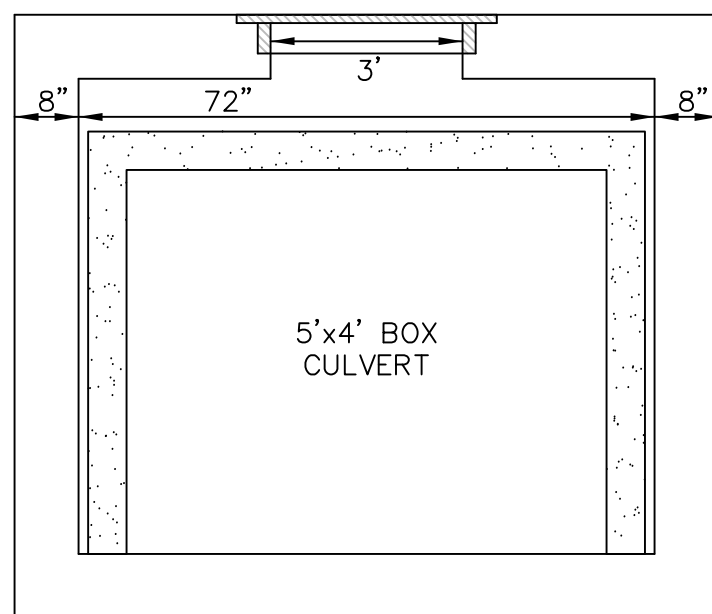

POND OUTFALL DETAIL

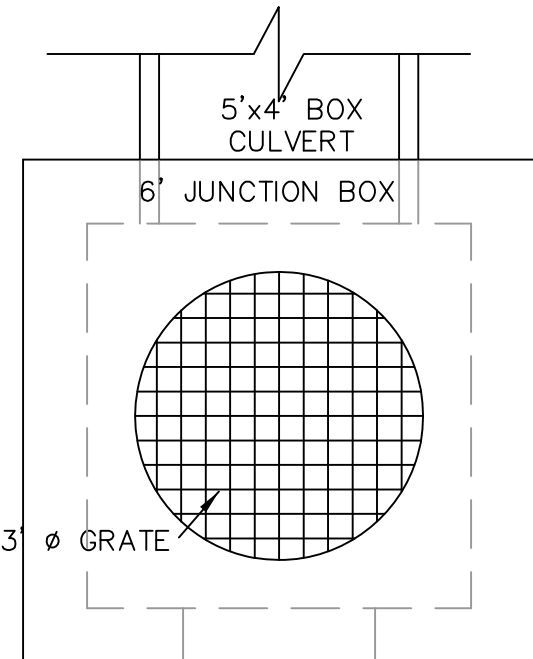

100-YR=543.47
50-YR=542.90
25-YR=542.60
10-YR=542.30
2-YR=541.60
NWSE=540.00

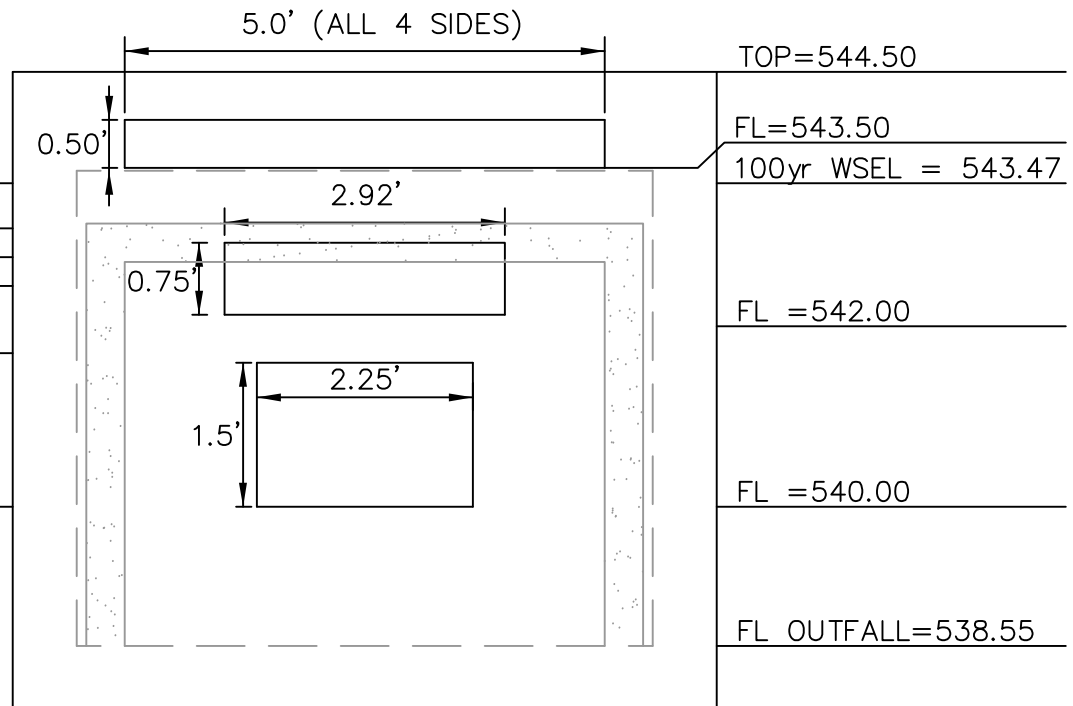

RECORD DRAWING
RECORD INFORMATION PROVIDED BY
CONASTER CONSTRUCTION, FORT WORTH, TEXAS
ELEVATION VERIFICATION PERFORMED BY
SURVEY CONSULTANTS, INC., PLANO, TEXAS

REV.	DATE	REMARKS					BY
DETENTION POND PLAN							
MANSIONS FAMILY							
CITY of ROCKWALL, TEXAS							
		RKM Consulting Engineers, Inc. 7616 LBJ Freeway, Suite 530 Dallas, Texas 75251 Copyright © 2009 RKM Consulting Engineers, Inc.				phone (214) 432-8070 fax (214) 432-8069 Firm No. F-7237	
CHECKED	DESIGN	DRAWN	JOB	DATE	SCALE	SHEET	
RKM	JRY	JRY	1026-005	05/27/09	1"=20'	10	OF 33