




TOCS
1-800-245-4545
bticket@1-call.com

MANSIONS SENIOR, RKMCE PROJECT # 1026-005

CIVIL CONSTRUCTION PLANS FOR **MANSIONS SENIOR** 18.17 GROSS ACRE TRACT B J.M. ALLEN SURVEY, ABSTRACT NO. 2 ROCKWALL COUNTY, TEXAS

CIVIL ENGINEER: RKM CONSULTING ENGINEERS, INC.
7616 LBJ FREEWAY, SUITE 530
DALLAS, TEXAS 75251
(214) 432-8070 PH
(214) 432-8069 FAX
JONATHAN R. YOUNESS, P.E.

APPLICANT/OWNER: WESTERN RIM INVESTMENT ADVISORS, INC.
601 CANYON DRIVE, SUITE 101
COPPELL, TEXAS 75019
(972) 471-8700 PH
(972) 471-8789 FAX
MATT HILES

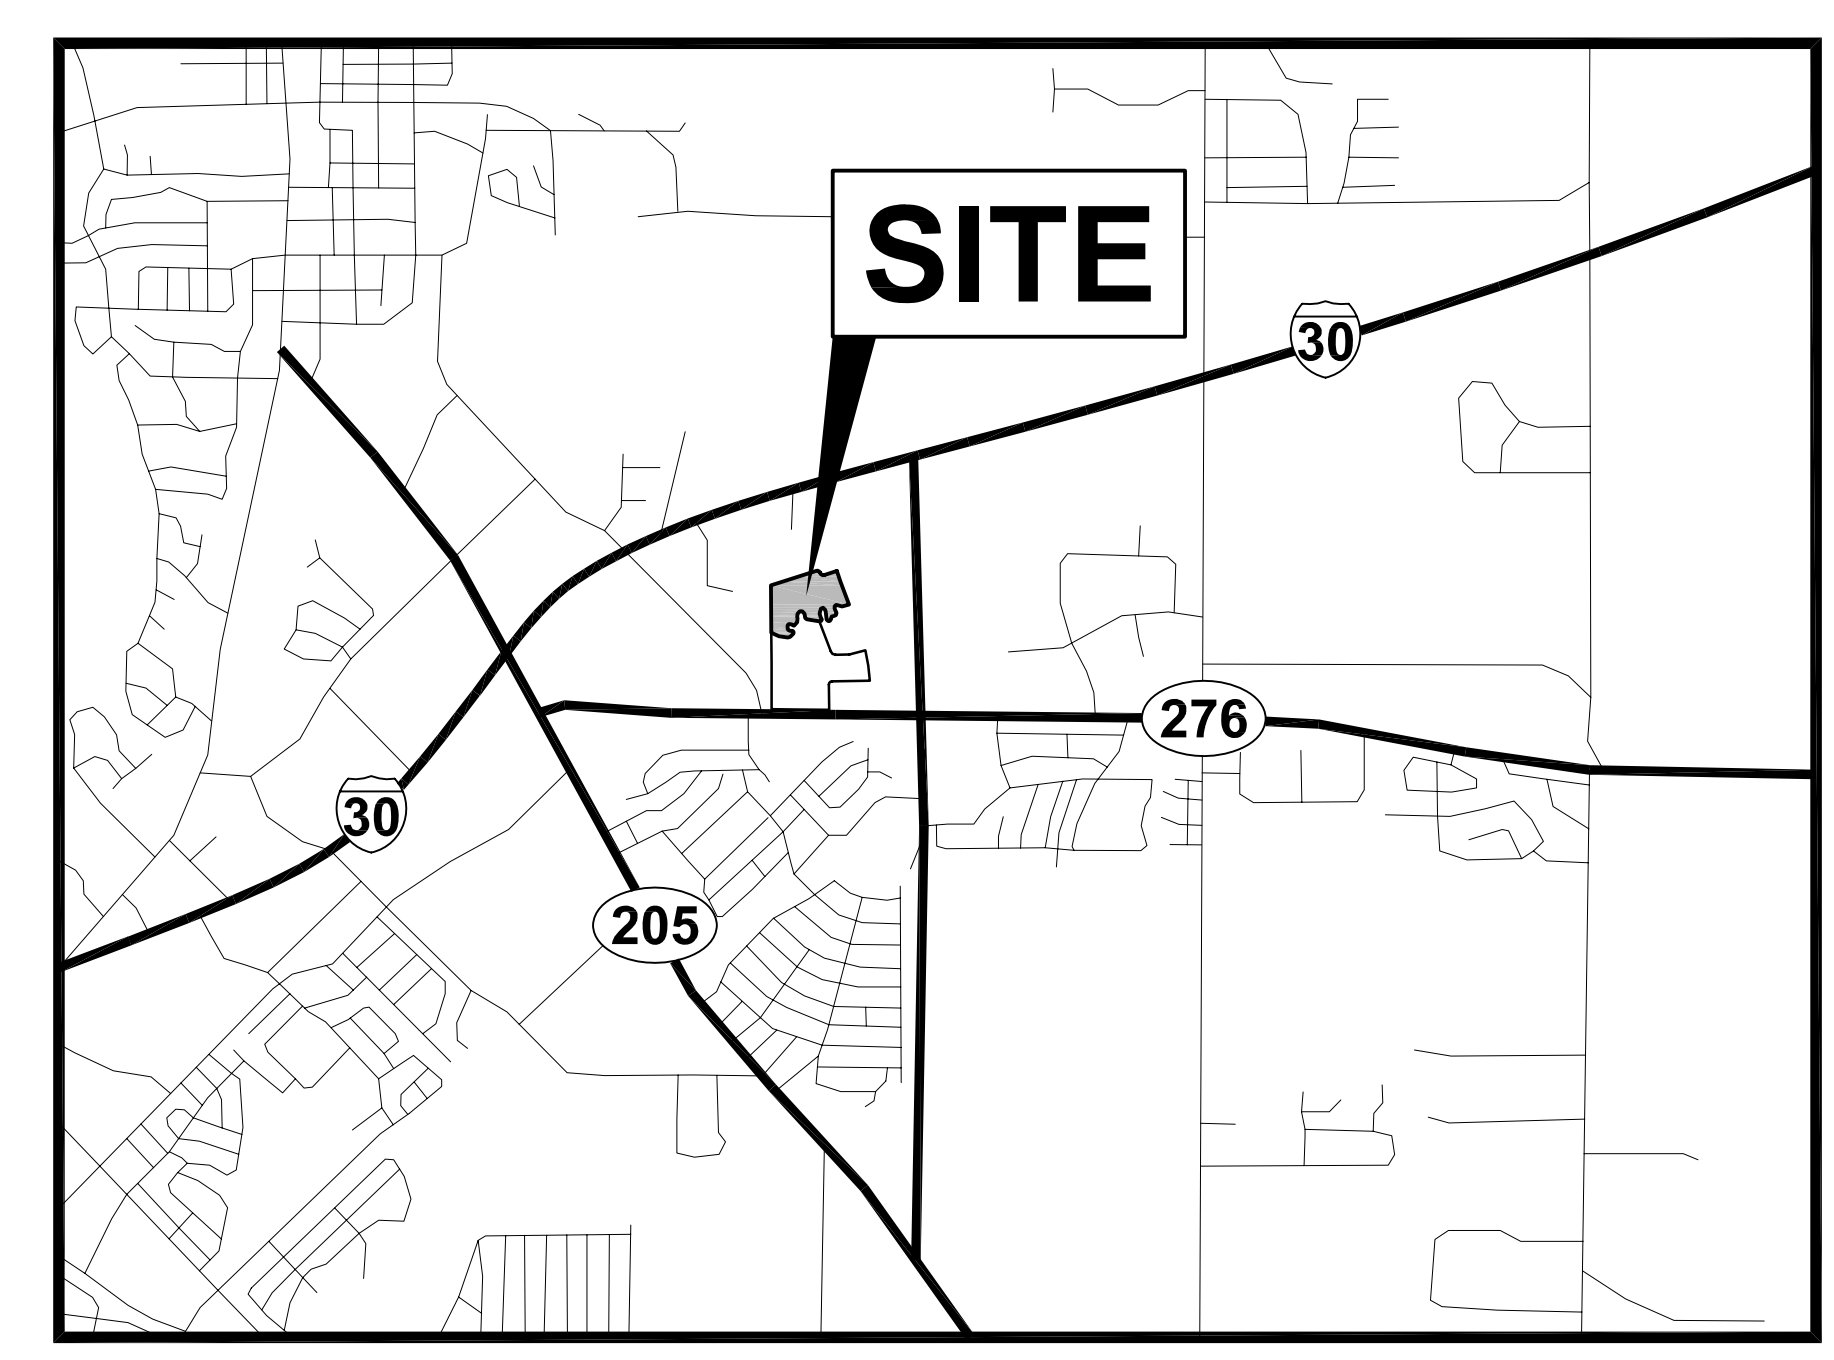

LOCATION MAP
N.T.S.

SHEET INDEX	
SHEET NO.	SHEET TITLE
1	COVER SHEET
2	GENERAL NOTES
3	DIMENSION CONTROL & PAVING PLAN
4	OFFSITE PAVING AND GRADING PLAN
5	GRADING PLAN
6	DRAINAGE AREA MAP
7a & 7b	DETENTION POND PLANS
8a & 8b	DETENTION POND CALCULATIONS
9 ~ 10	STORM SEWER CALCULATIONS
11	STORM SEWER PLAN
12 ~ 14	STORM SEWER PROFILES
15	UTILITY PLAN
16	SANITARY SEWER PROFILES
17	EROSION CONTROL PLAN
18	EROSION CONTROL DETAILS
19 ~ 20	SITE DETAILS


*
BUFFALO CREEK GRAVITY SEWER LINE STA. 169+50 TO STA. 195+50
PLANS PREPARED BY BIRKHOFF, HENDRICKS & CONWAY, L.L.P.,
INCLUDED IN THIS SET.

SUBMITTAL LOG

- 1ST SUBMITTAL TO CITY OF ROCKWALL NOT FOR CONSTRUCTION 08/21/2008
- 2ND SUBMITTAL TO CITY OF ROCKWALL FOR CONSTRUCTION PERMIT 12/10/2008
- 3RD SUBMITTAL TO CITY OF ROCKWALL FOR REVIEW 01/16/2009
- 4TH SUBMITTAL TO CITY OF ROCKWALL FOR CONSTRUCTION PERMIT 02/05/2009

FEBRUARY 2009

RECORD DRAWING
RECORD INFORMATION PROVIDED BY
CONASTER CONSTRUCTION, FORT WORTH, TEXAS
ELEVATION VERIFICATION PERFORMED BY
SURVEY CONSULTANTS, INC., PLANO, TEXAS

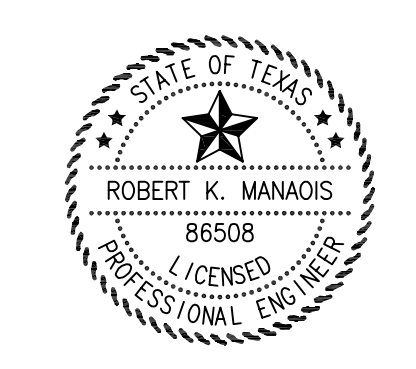

RKM RKM Consulting Engineers, Inc.
7616 LBJ Freeway, Suite 530
Dallas, Texas 75251
Copyright © 2008 RKM Consulting Engineers, Inc.

phone (214) 432-8070
fax (214) 432-8069