


RECORD DRAWING
 RECORD INFORMATION PROVIDED BY
 COMASTER CONSTRUCTION, FORT WORTH, TEXAS
 ELEVATION CONTROL PERFORMED BY
 SURVEY CONSULTANTS, INC., PLANO, TEXAS

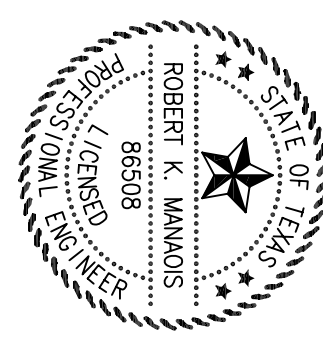

DIMENSION CONTROL & PAVING PLAN

MANSON'S SENIOR
 CITY OF ROCKWALL, TEXAS

REV.	DATE	REMARKS	BY

RKM Consulting Engineers, Inc.
 7616 EBI Freeway, Suite 500
 Dallas, Texas 75251
 Phone (214) 433-8070
 Fax (214) 433-8069

TOCS
 1-800-245-4545
 tocs@aol.com

CHECKED: JRY
 DESIGN: JRY
 DRAWN: JRY
 JOB: 1026-005
 DATE: 02/18/09
 SCALE: 1"=40'
 SHEET: 3 OF 20