


**205 BYPASS
JOHN KING BLVD.**




LEGEND


 6" CONCRETE PAVING
 (3,600 PS W/ LIME TREATED SUBGRADE
 - 6 SACK FOR MACHINE PLACED - 6.5
 SACK FOR HAND PLACED)

RECORD DRAWING
 RECORD INFORMATION PROVIDED BY
 CONASTER CONSTRUCTION, FORT WORTH, TEXAS
 ELEVATION VERIFICATION PERFORMED BY
 SURVEY CONSULTANTS, INC., PLANO, TEXAS



TOCS
 1-800-245-4545
 tkc@tocs.com

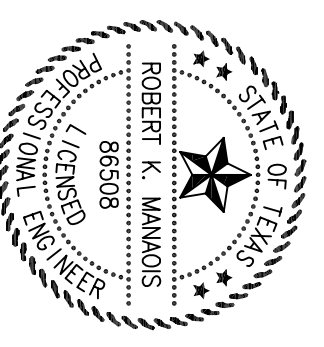

REV.	DATE	REMARKS	BY

OFFSITE PAVING AND GRADING PLAN

MANSIONS SENIOR
 CITY OF ROCKWALL, TEXAS



RKM Consulting Engineers, Inc.
 7616 LBJ Freeway, Suite 530
 Dallas, Texas 75247
 Phone (214) 432-8070
 Fax (214) 432-8069

CHECKED	DESIGN	DRAWN	JOB	DATE	SCALE	SHEET
RKM	JRY	JRY	1026-005	02/18/09	1"=40'	4 OF 20