


LEGEND	
---	EXISTING MINOR CONTOUR
---	EXISTING MAJOR CONTOUR
---	PROPOSED MINOR CONTOUR
---	PROPOSED MAJOR CONTOUR
X 535.00	PROPOSED TP (U.N.G.) ELEVATION
---	PROPOSED FINISH FLOOR ELEVATION
---	100 YEAR FLOOD PLAN
---	LANDSCAPE WALL

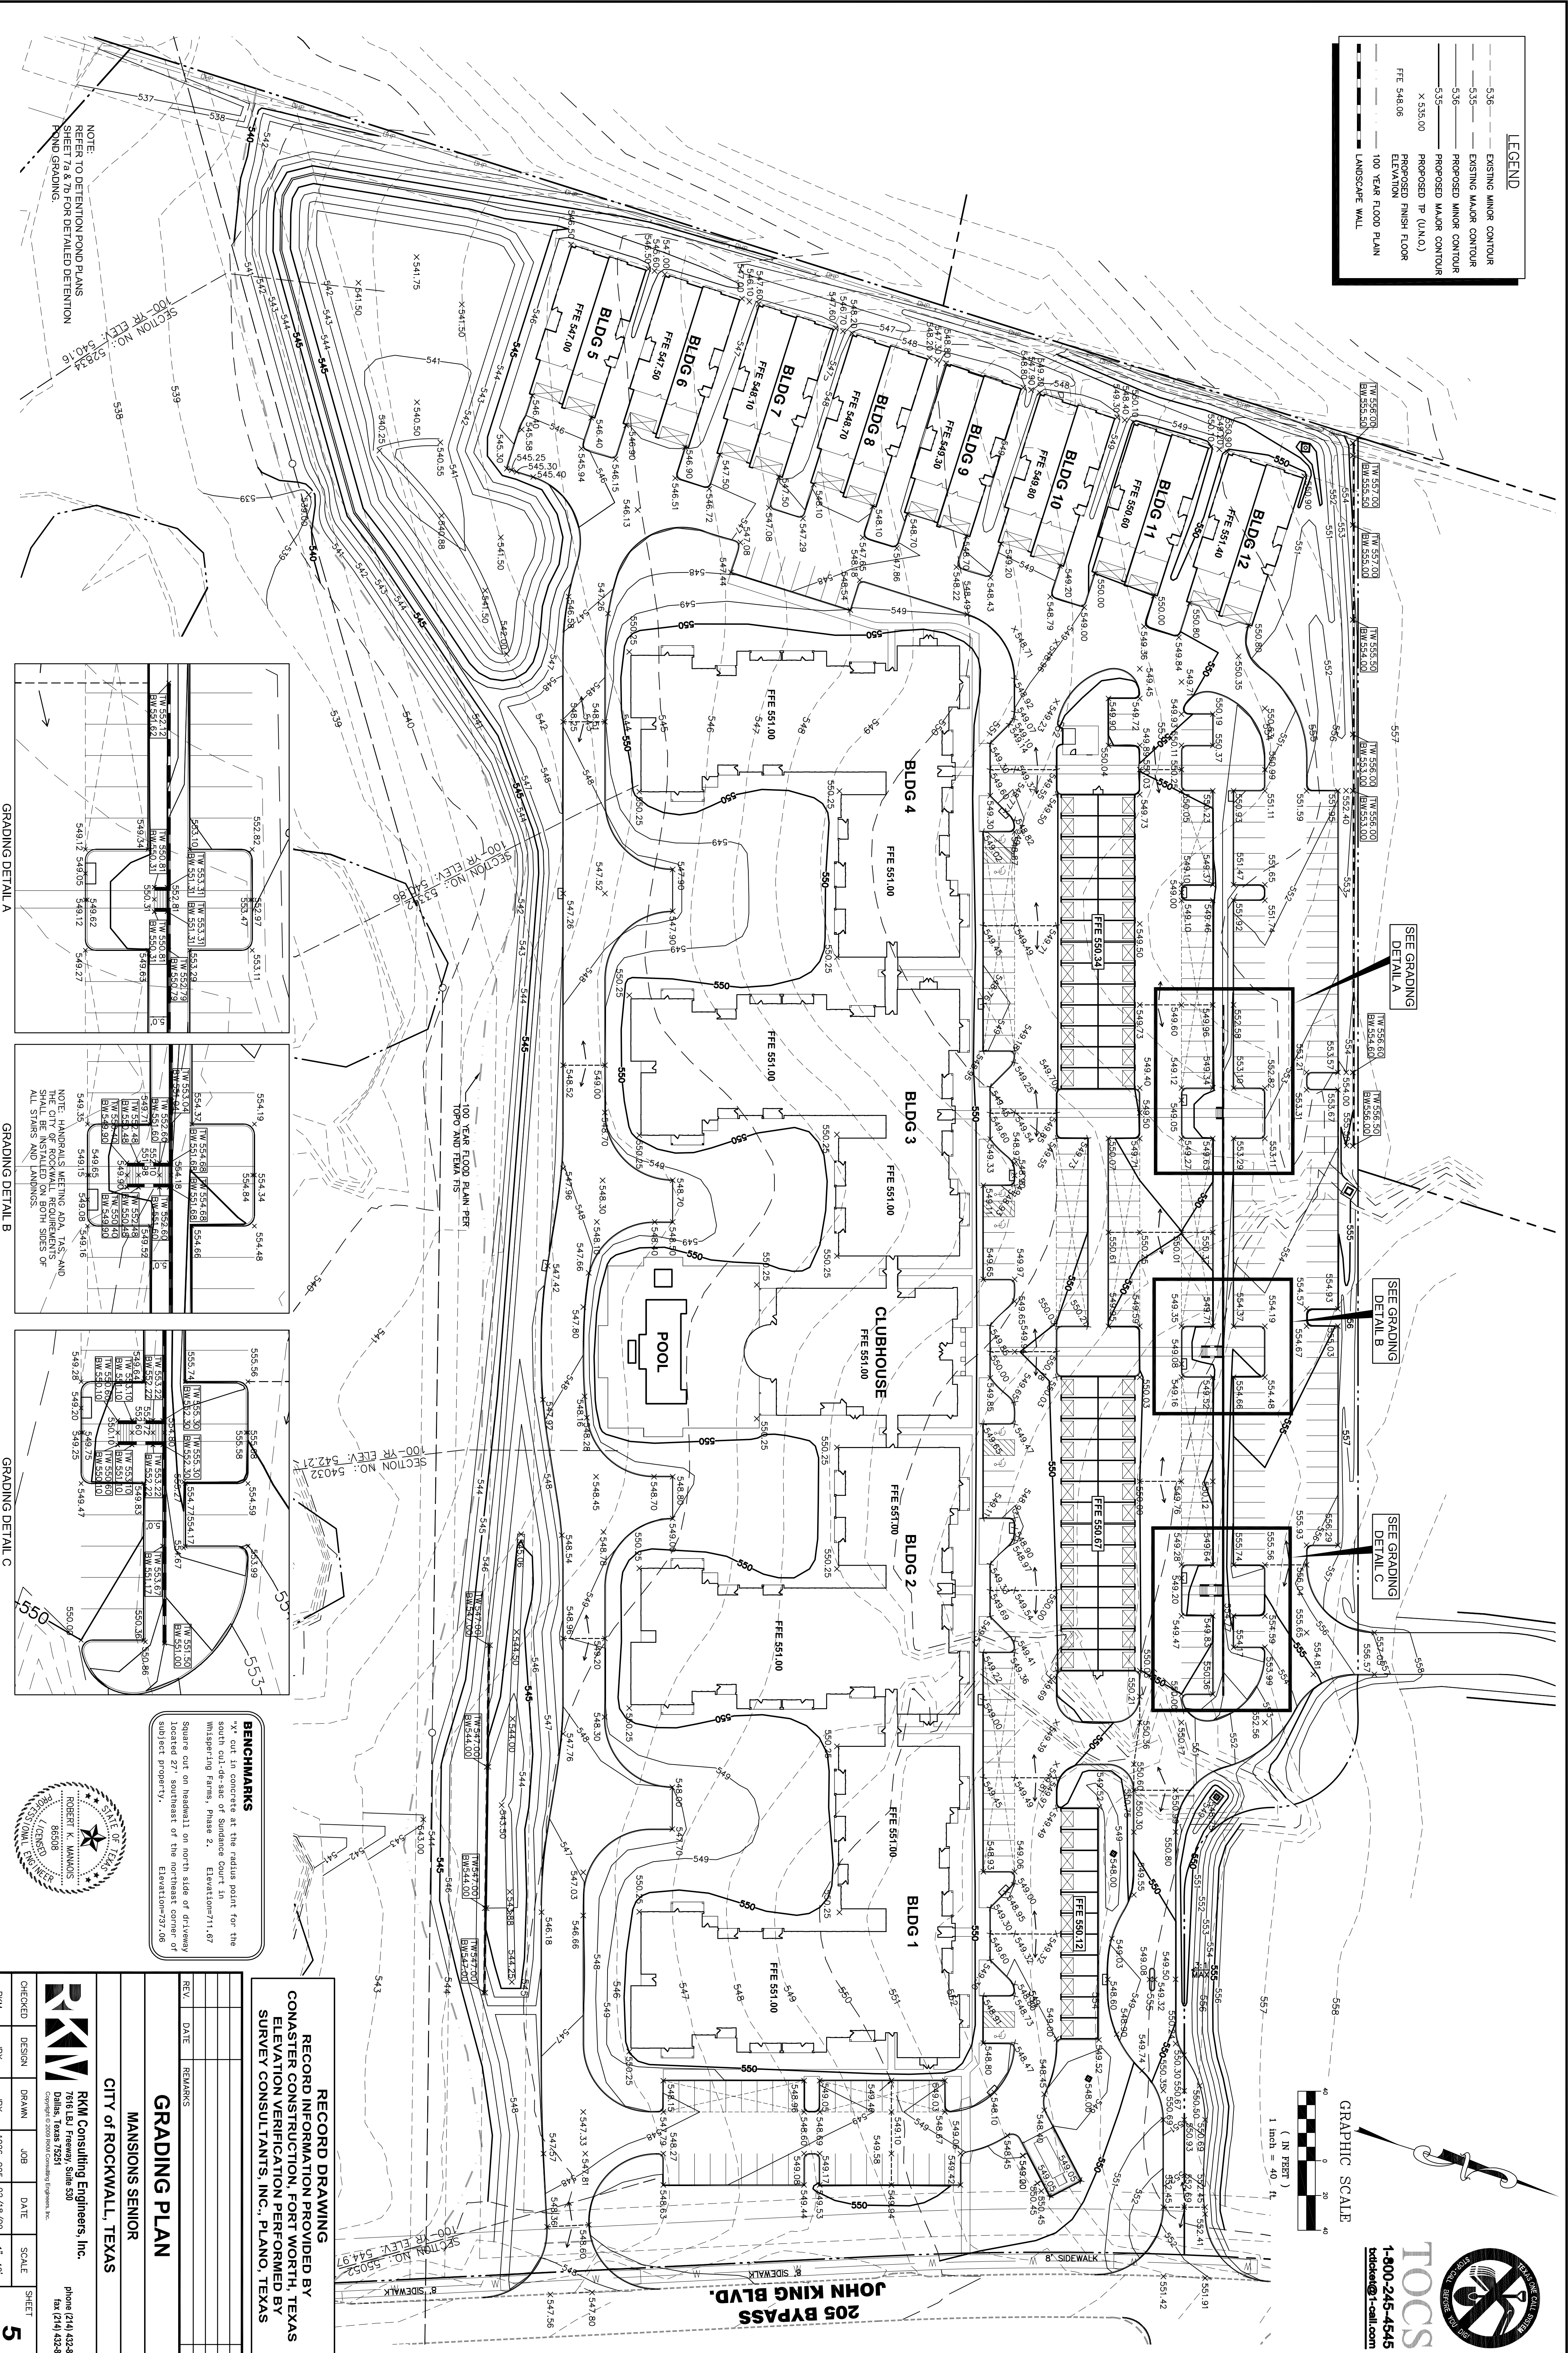

SEE GRADING DETAIL A
SEE GRADING DETAIL B
SEE GRADING DETAIL C


TOCS
1-800-245-4545
tocs.com

RKM
RKM Consulting Engineers, Inc.
7616 EBI Freeway, Suite 500
Dallas, Texas 75251
phone (214) 432-8070
fax (214) 432-8069

RECORD DRAWING
RECORD INFORMATION PROVIDED BY
CONASTER CONSTRUCTION, FORT WORTH, TEXAS
ELEVATION VERIFICATION PERFORMED BY
SURVEY CONSULTANTS, INC., PLANO, TEXAS

REV	DATE	REMARKS	BY

BENCHMARKS
"X" cut in concrete at the radius point for the south cul-de-sac of Sundance Court in Whispering Farms, Phase 2. Elevation=711.67
Square cut on sidewalk on north side of driveway located 27' southeast of the northeast corner of subject property. Elevation=737.06

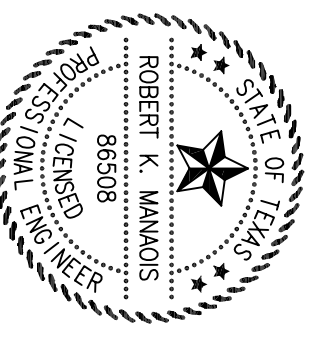

GRADING PLAN
MANSIONS SENIOR
CITY OF ROCKWALL, TEXAS

CHECKED: RKM
DESIGN: RKM
DATE: 10/28-005
JOB: 02/18/09
SCALE: 1"=40'
SHEET: 5 OF 20