



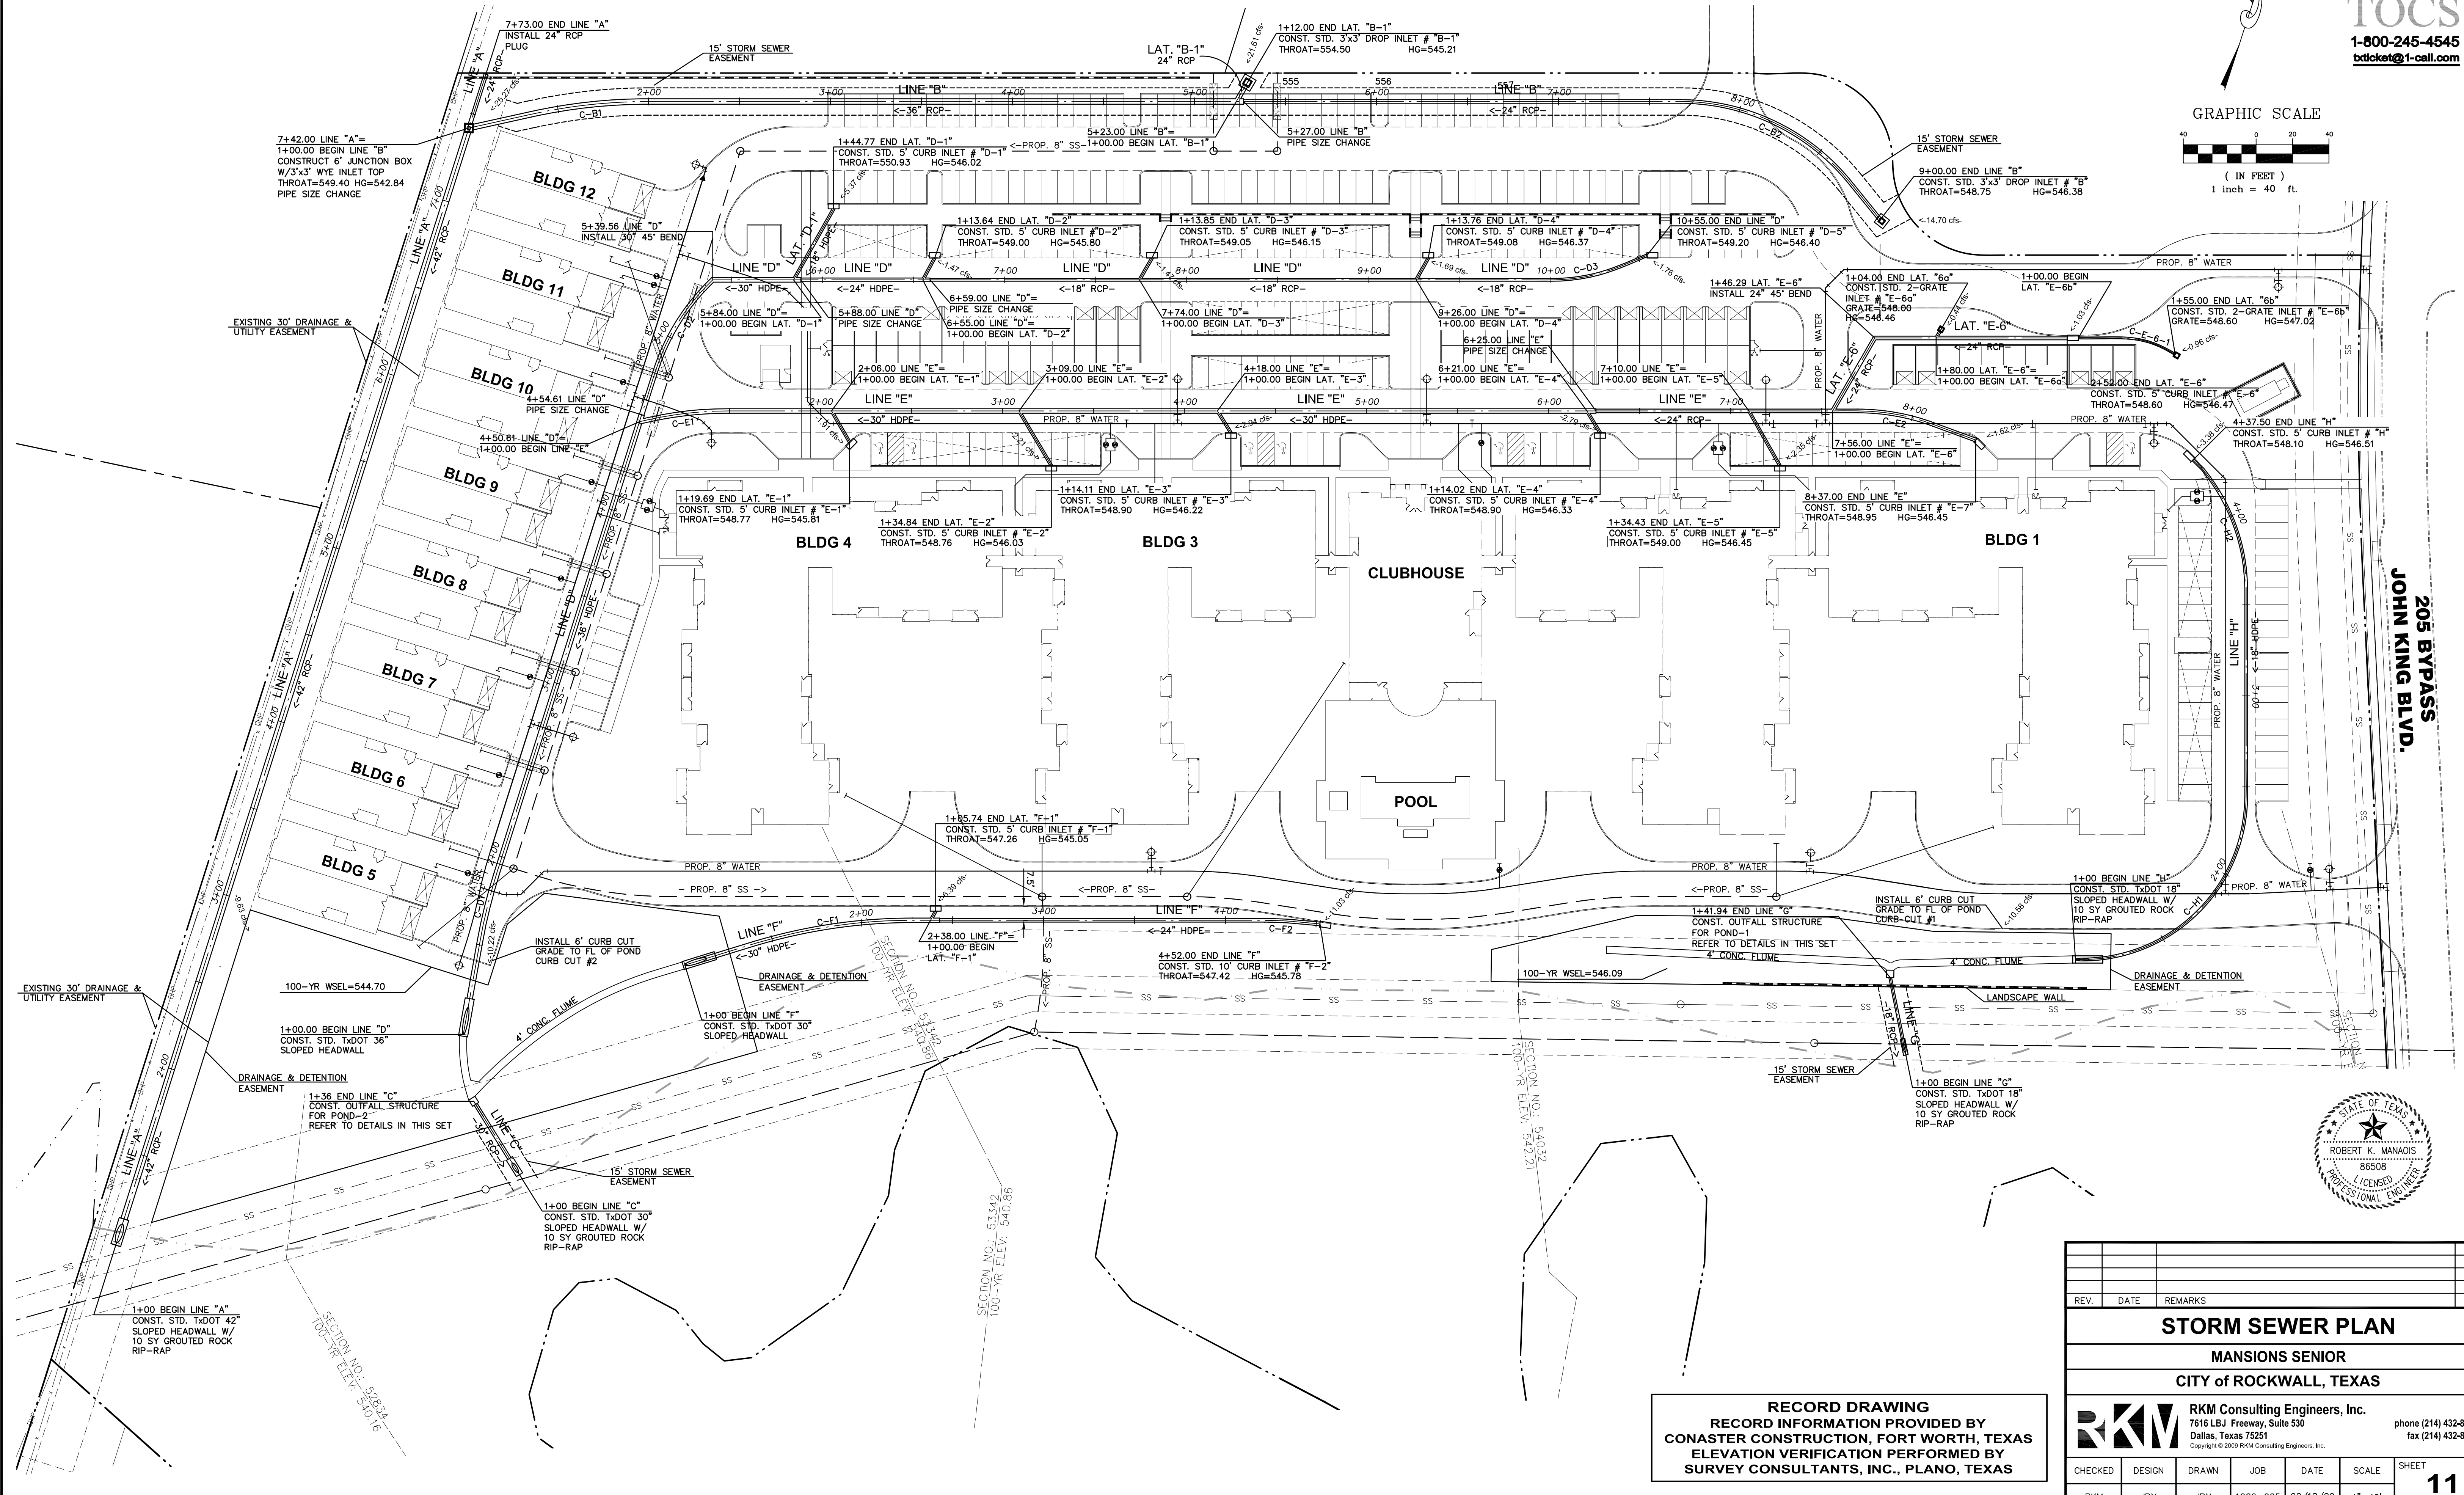

**TOCS**  
1-800-245-4545  
tcdicket@1-call.com

MANIONS SENIOR - RMNCE PROJECT # 1026-005

STORM SEWER CENTER LINE CURVE DATA											
C-B1	C-B2	C-D1	C-D2	C-D3	C-E1	C-E2	C-E-6-1	C-F1	C-F2	C-H1	C-H2
PC STA. 1+34.92	PC STA. 7+66.86	PC STA. 1+51.92	PC STA. 4+79.13	PC STA. 10+00.51	PC STA. 1+05.63	PC STA. 7+69.79	PC STA. 1+24.08	PC STA. 1+38.46	PC STA. 4+21.32	PC STA. 1+03.83	PC STA. 3+58.77
PT STA. 2+00.14	PT STA. 8+73.46	PT STA. 1+90.62	PT STA. 5+39.56	PT STA. 10+40.07	PT STA. 1+49.11	PT STA. 8+12.09	PT STA. 1+50.17	PT STA. 2+27.97	PT STA. 4+40.15	PT STA. 2+43.20	PT STA. 4+30.25
Δ = 122°27'21"	Δ = 50°54'04"	Δ = 07°23'26"	Δ = 28°51'13"	Δ = 22°39'54"	Δ = 122°27'20"	Δ = 201°14'7"	Δ = 29°54'16"	Δ = 17°05'44"	Δ = 05°23'48"	Δ = 90°00'00"	Δ = 39°04'40"
R = 300.00'	R = 120.00'	R = 300.00'	R = 120.00'	R = 100.00'	R = 200.00'	R = 120.00'	R = 50.00'	R = 300.00'	R = 200.00'	R = 90.00'	R = 104.80'
L = 65.22'	L = 106.60'	L = 38.70'	L = 60.43'	L = 39.56'	L = 43.48'	L = 26.09'	L = 89.51'	L = 89.51'	L = 18.83'	L = 141.37'	L = 71.48'
C = 65.09'	C = 103.14'	C = 38.67'	C = 59.79'	C = 39.30'	C = 43.39'	C = 59.79'	C = 42.08'	C = 89.18'	C = 18.83'	C = 127.28'	C = 70.10'
T = 32.74'	T = 57.11'	T = 19.37'	T = 30.87'	T = 20.04'	T = 21.83'	T = 21.37'	T = 13.35'	T = 48.09'	T = 9.43'	T = 9.00'	T = 37.19'

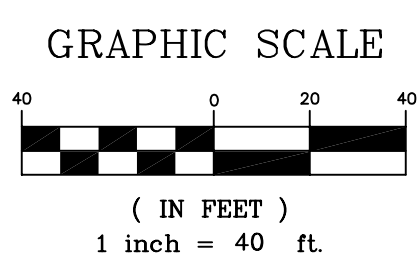

205 BYPASS  
JOHN KING BLVD.

REV.	DATE	REMARKS	BY

**STORM SEWER PLAN**  
MANSIONS SENIOR  
CITY OF ROCKWALL, TEXAS

**RECORD DRAWING**  
RECORD INFORMATION PROVIDED BY  
CONASTER CONSTRUCTION, FORT WORTH, TEXAS  
ELEVATION VERIFICATION PERFORMED BY  
SURVEY CONSULTANTS, INC., PLANO, TEXAS

CHECKED	DESIGN	DRAWN	JOB	DATE	SCALE	SHEET
RKM	JRY	JRY	1026-005	02/18/09	1"=40'	<b>11</b>

OF 20