



**STORM SEWER LINE "A"**

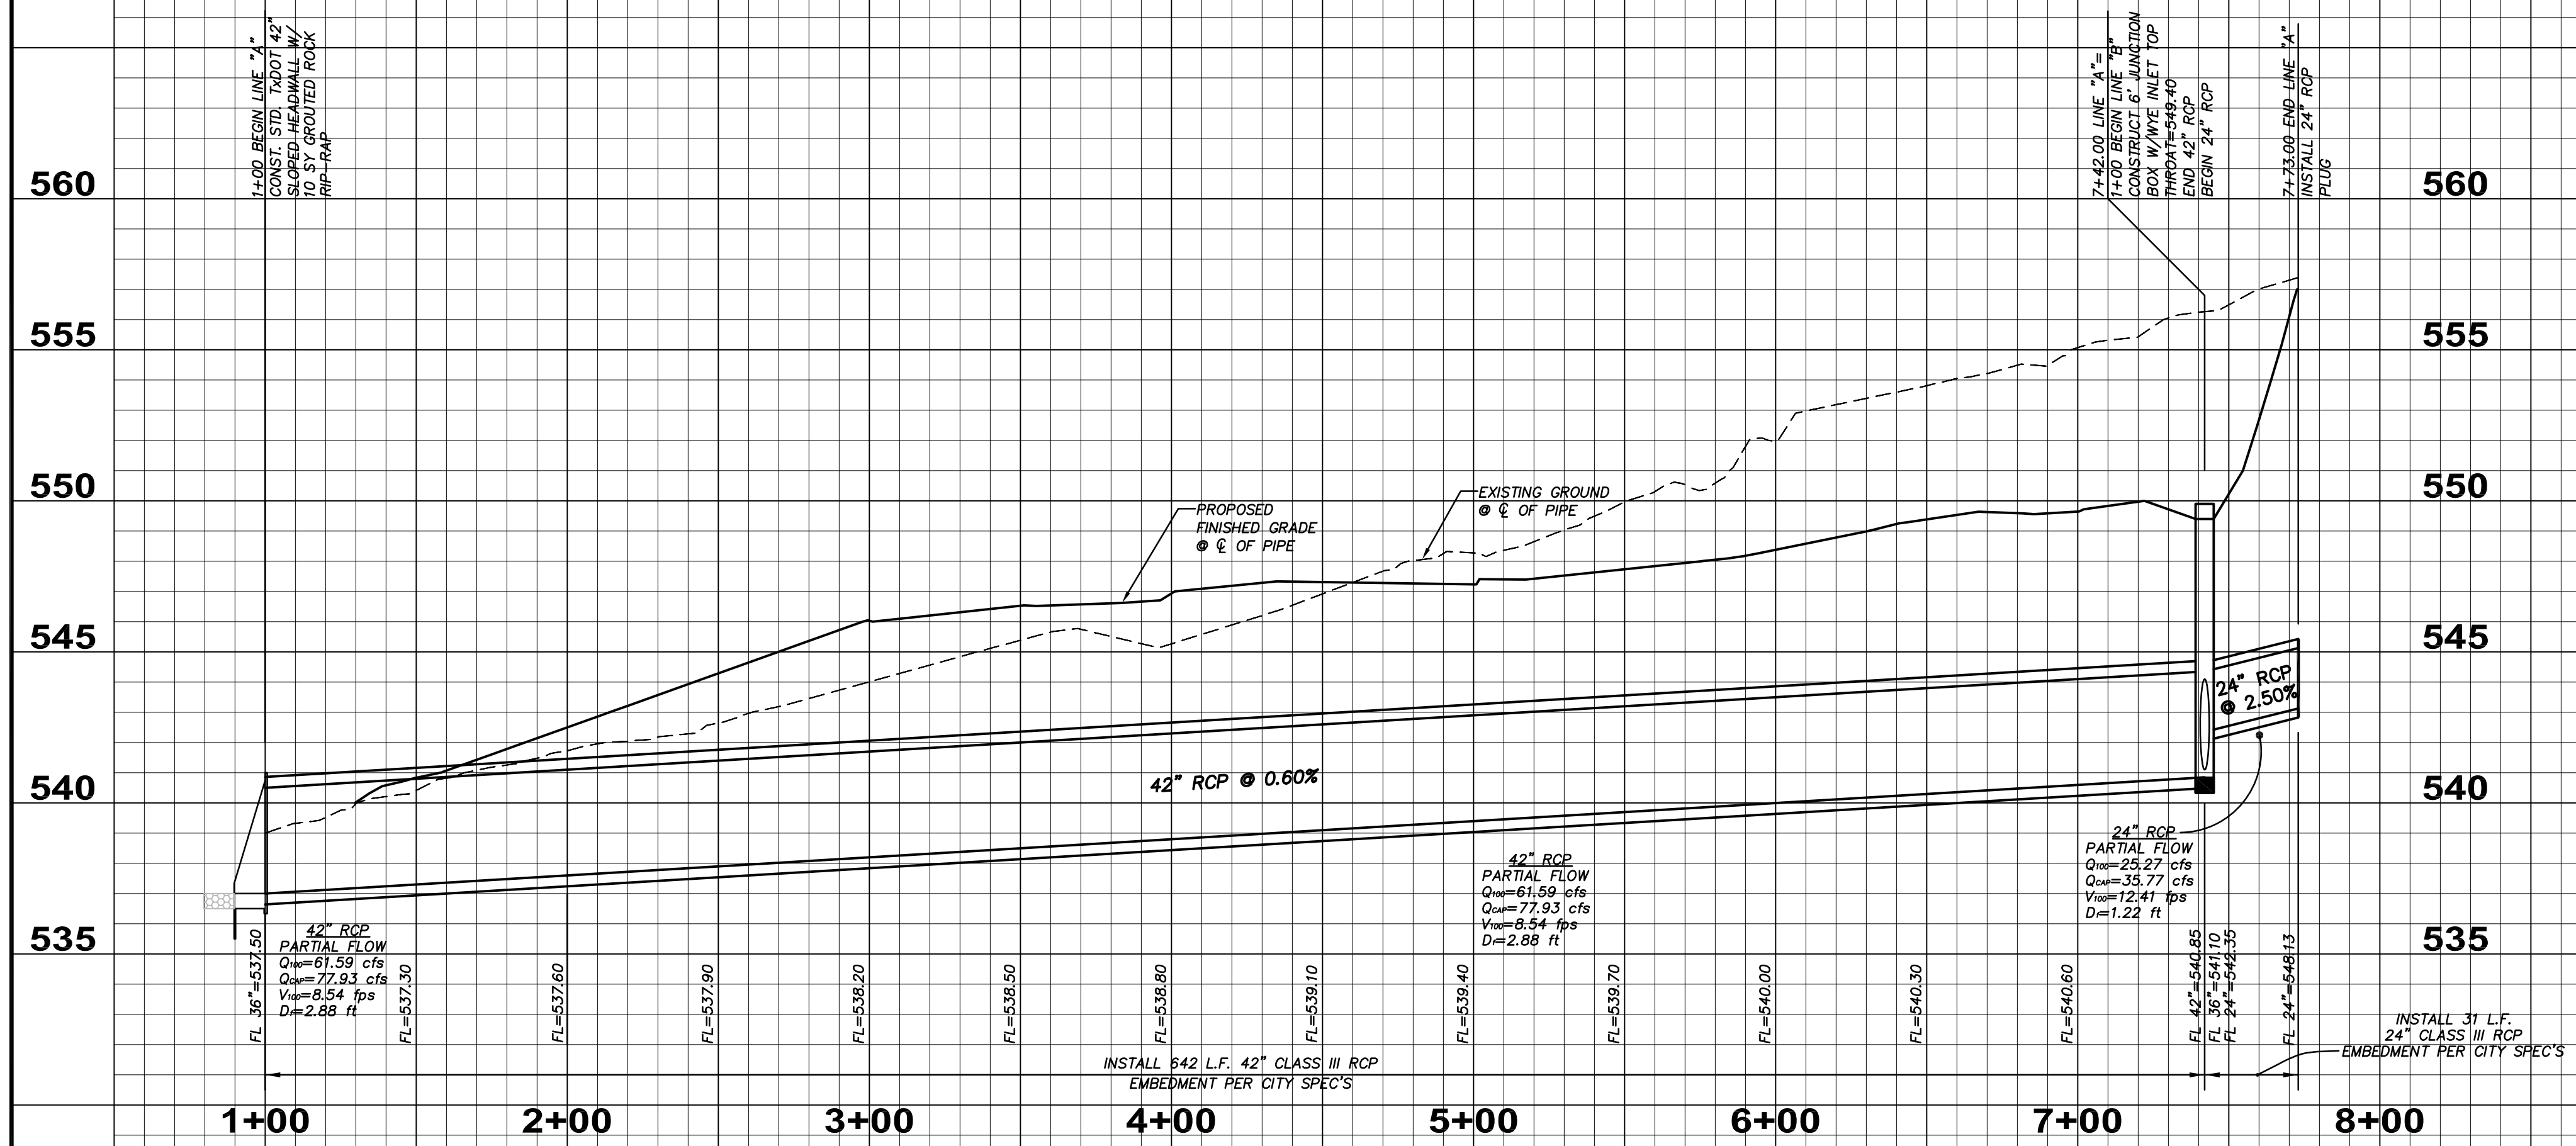


**STORM SEWER LINE "C"**

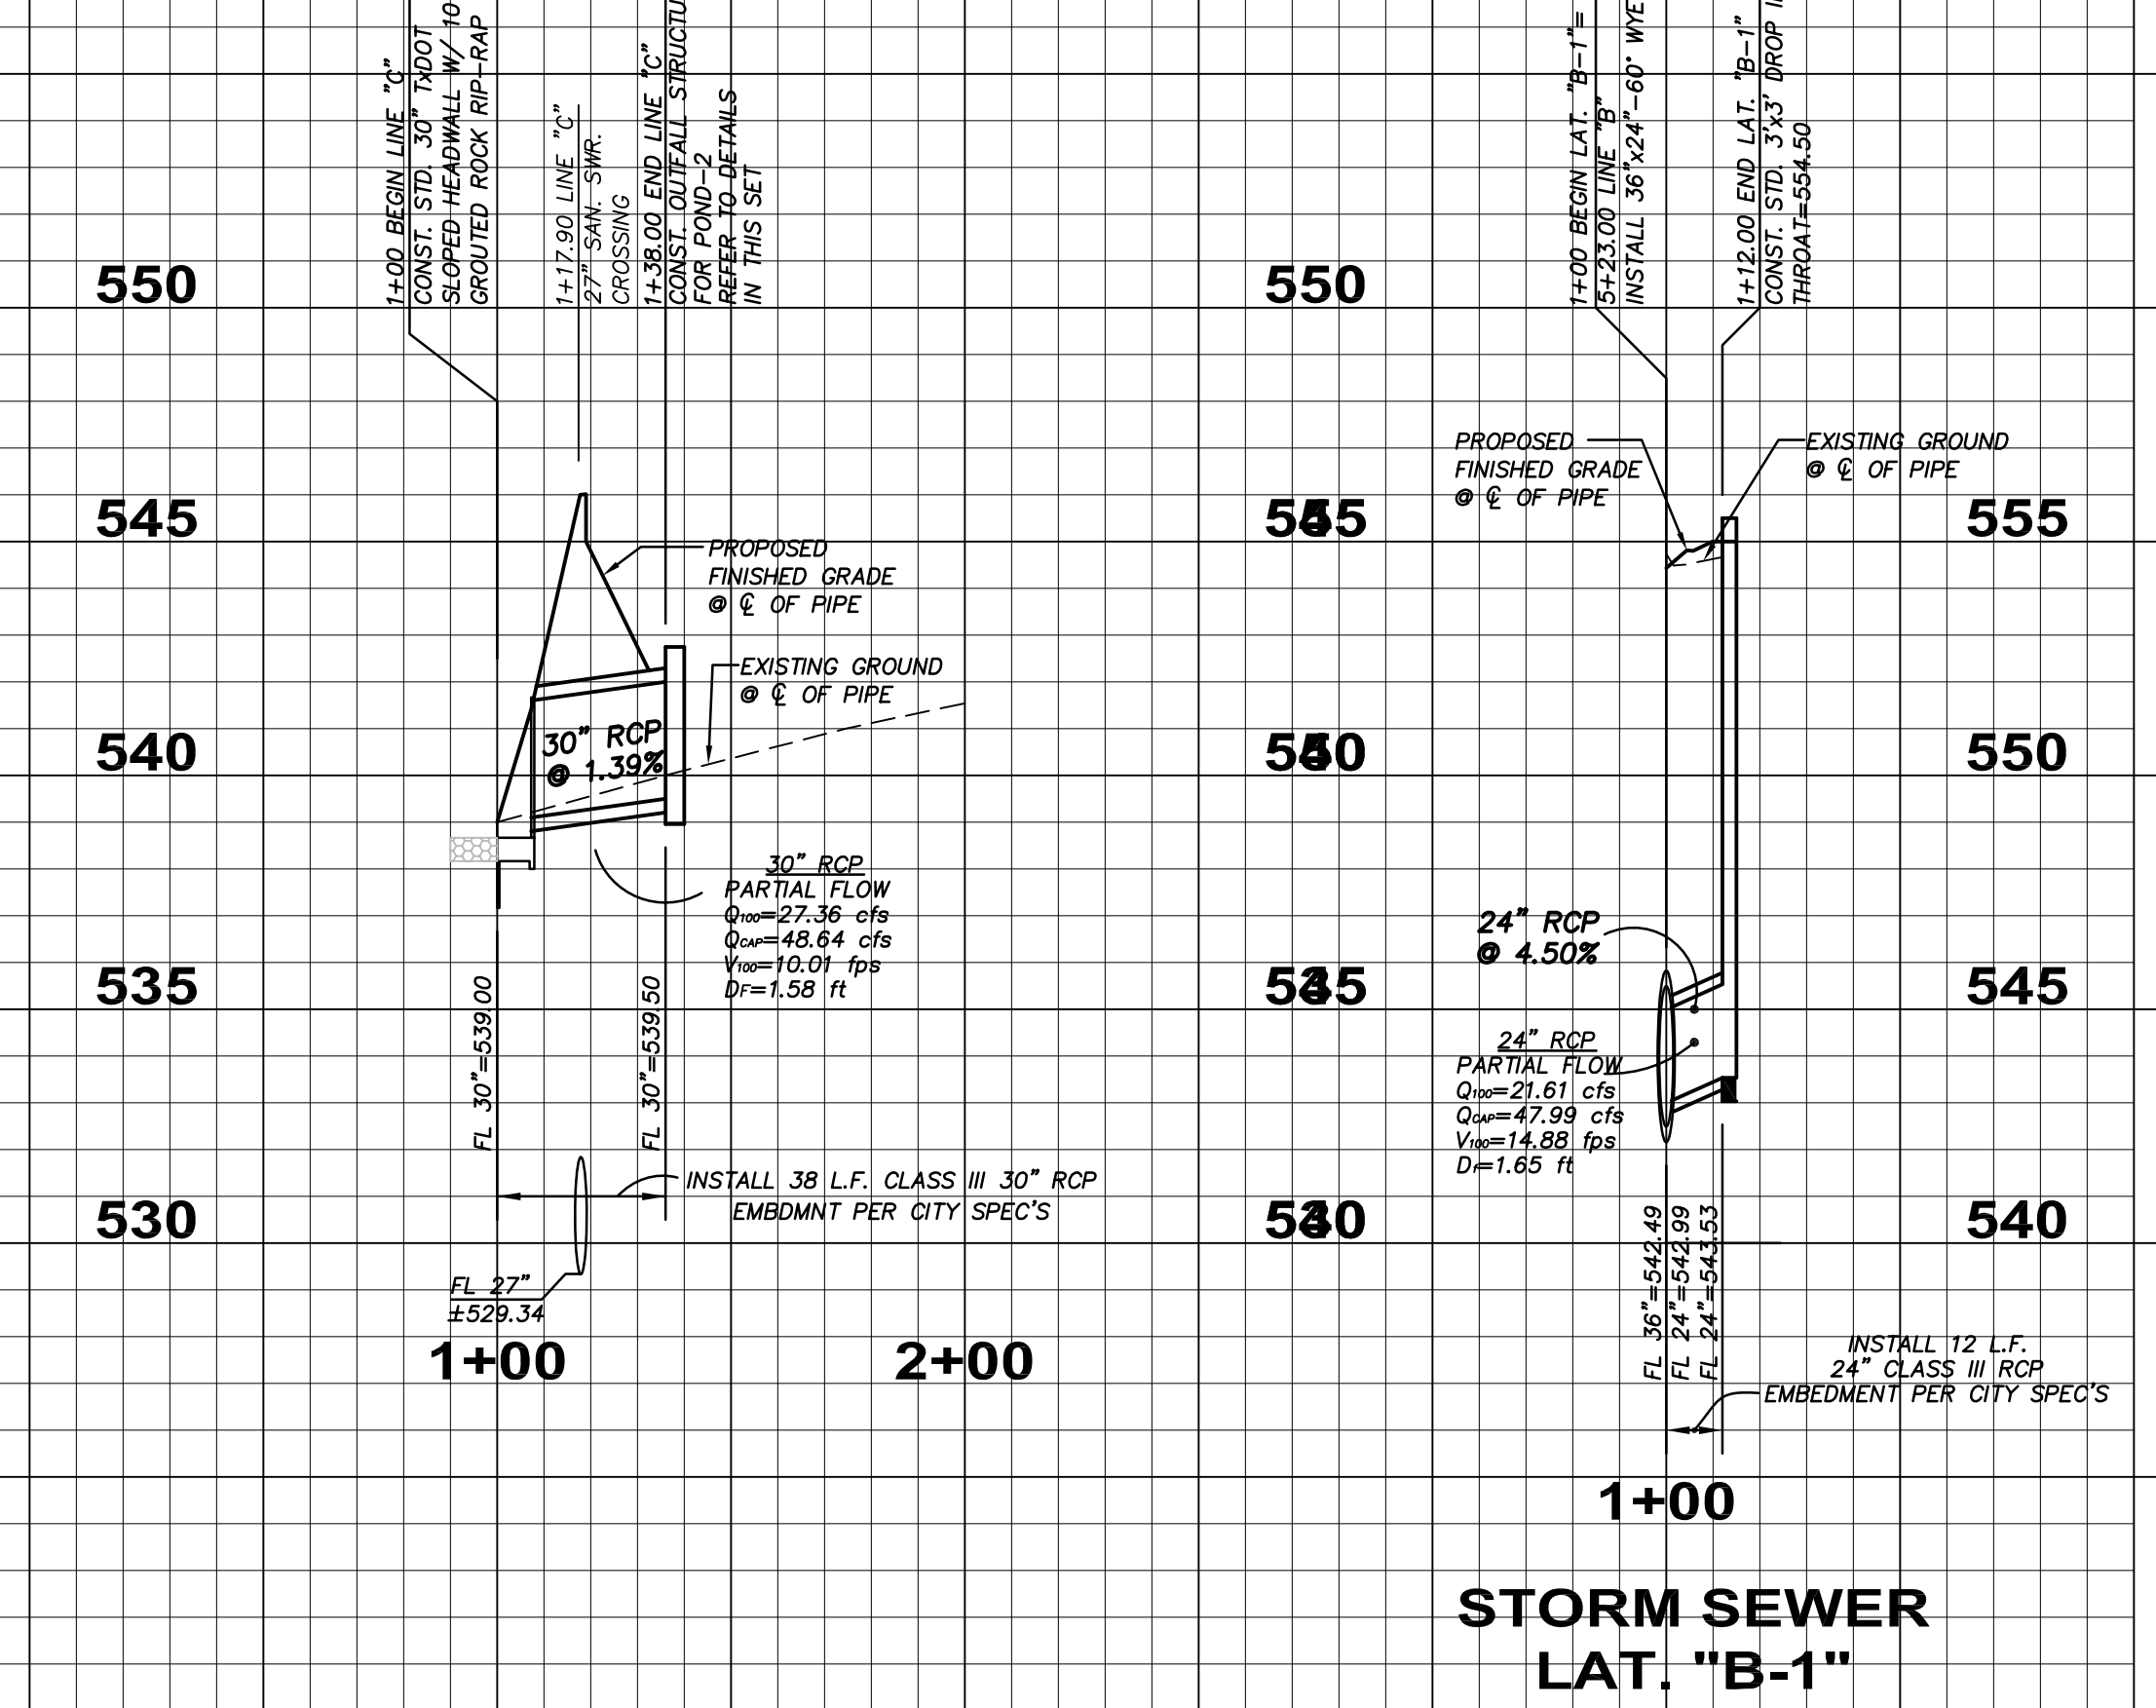

**STORM SEWER LAT. "B-1"**

**STORM SEWER LINE "B"**

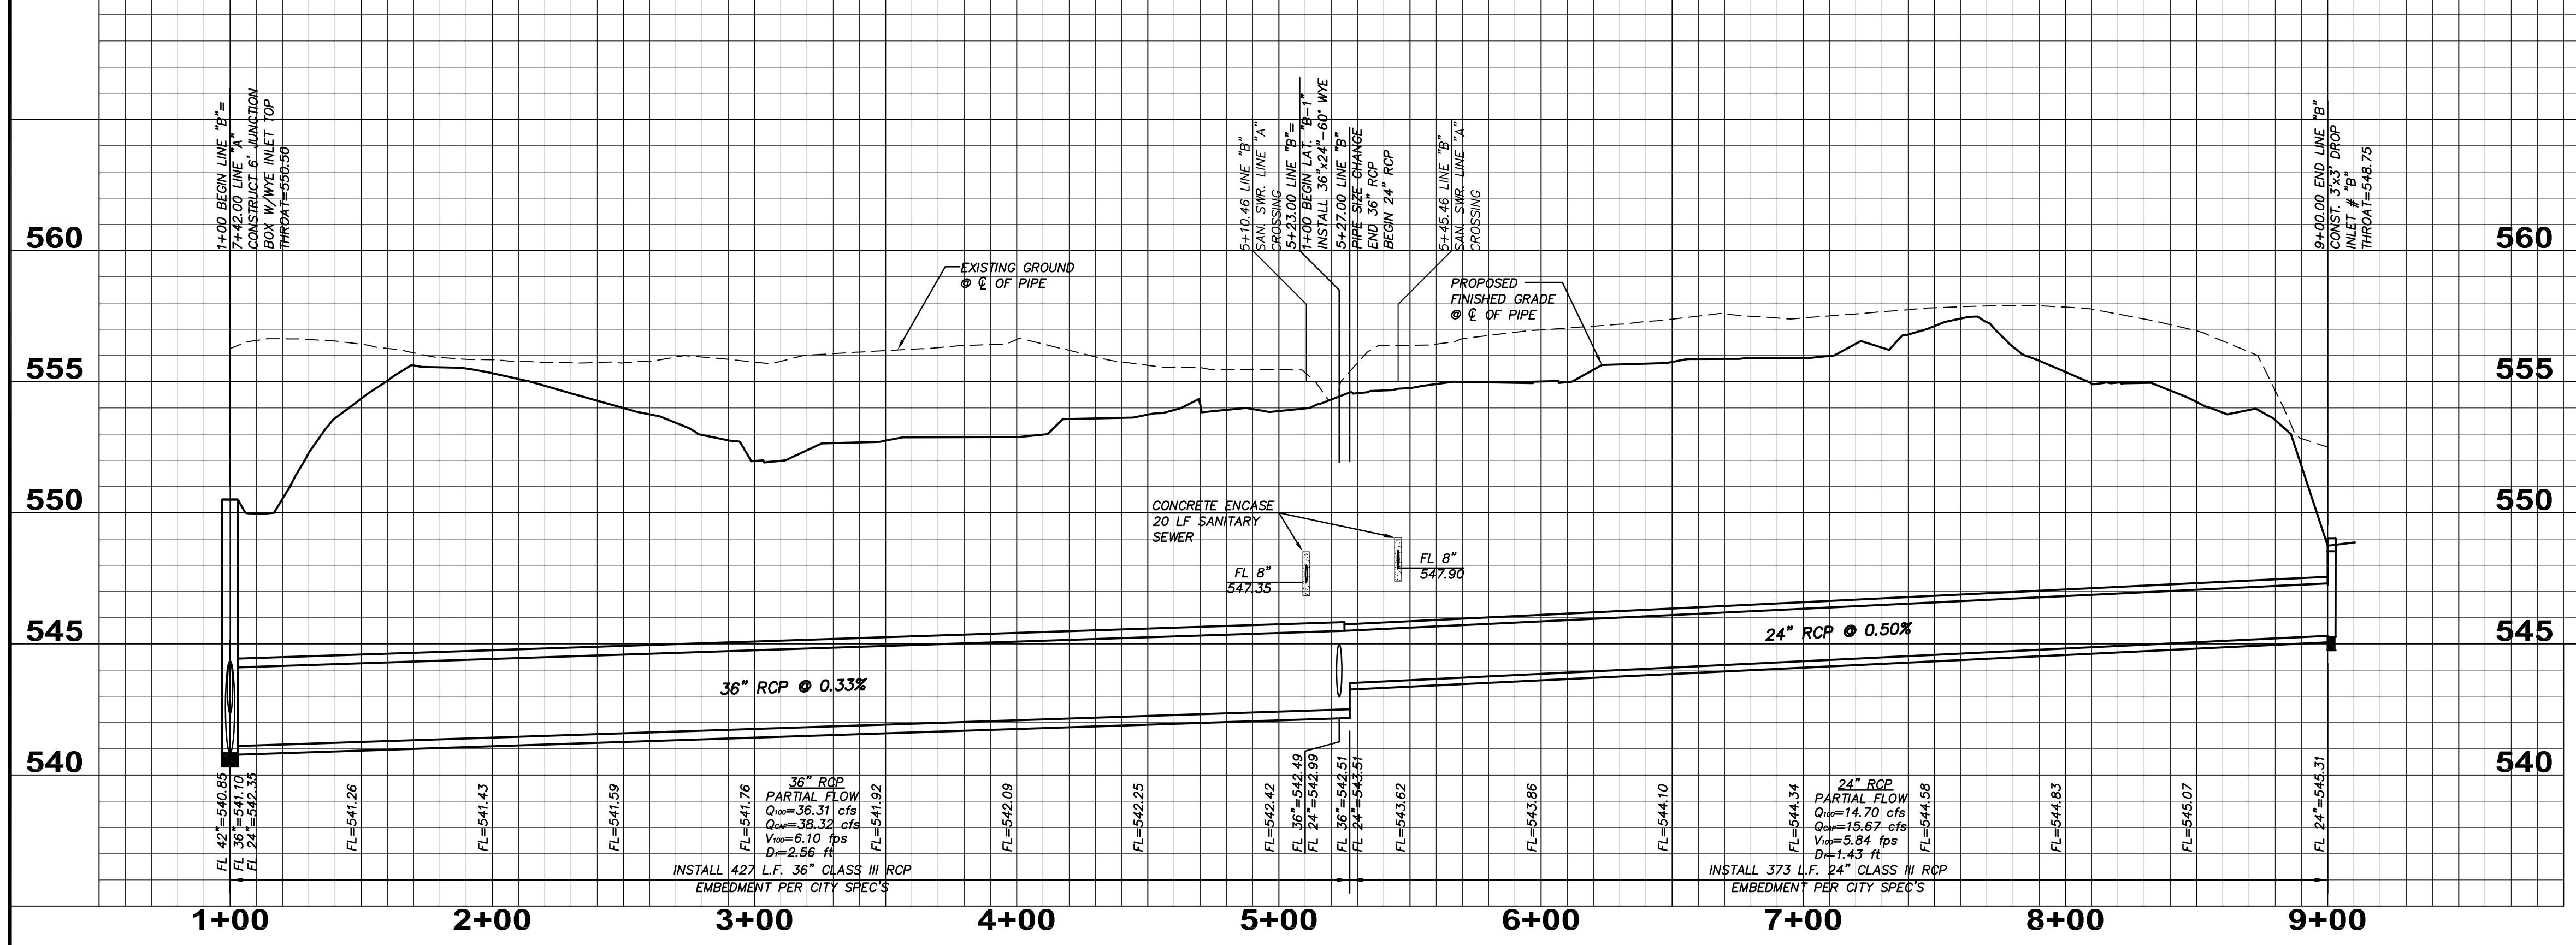

**RECORD DRAWING**  
RECORD INFORMATION PROVIDED BY  
CONASTER CONSTRUCTION, FORT WORTH, TEXAS  
ELEVATION VERIFICATION PERFORMED BY  
SURVEY CONSULTANTS, INC., PLANO, TEXAS

REV.	DATE	REMARKS	BY
<b>STORM SEWER PROFILES</b>			
MANSIONS SENIOR CITY of ROCKWALL, TEXAS			
<b>RKM</b> Consulting Engineers, Inc. 7616 LBJ Freeway, Suite 530 Dallas, Texas 75251 phone (214) 432-8070 fax (214) 432-8069			
CHECKED	DESIGN	DRAWN	JOB
RKM	JRY	JRY	1026-005
DATE	SCALE	SHEET	
02/18/09	1"=40' (H) 1"=4' (V)	<b>12</b>	OF 20

