



**STORM SEWER LINE "D"**


**STORM SEWER LAT. "D-1"**

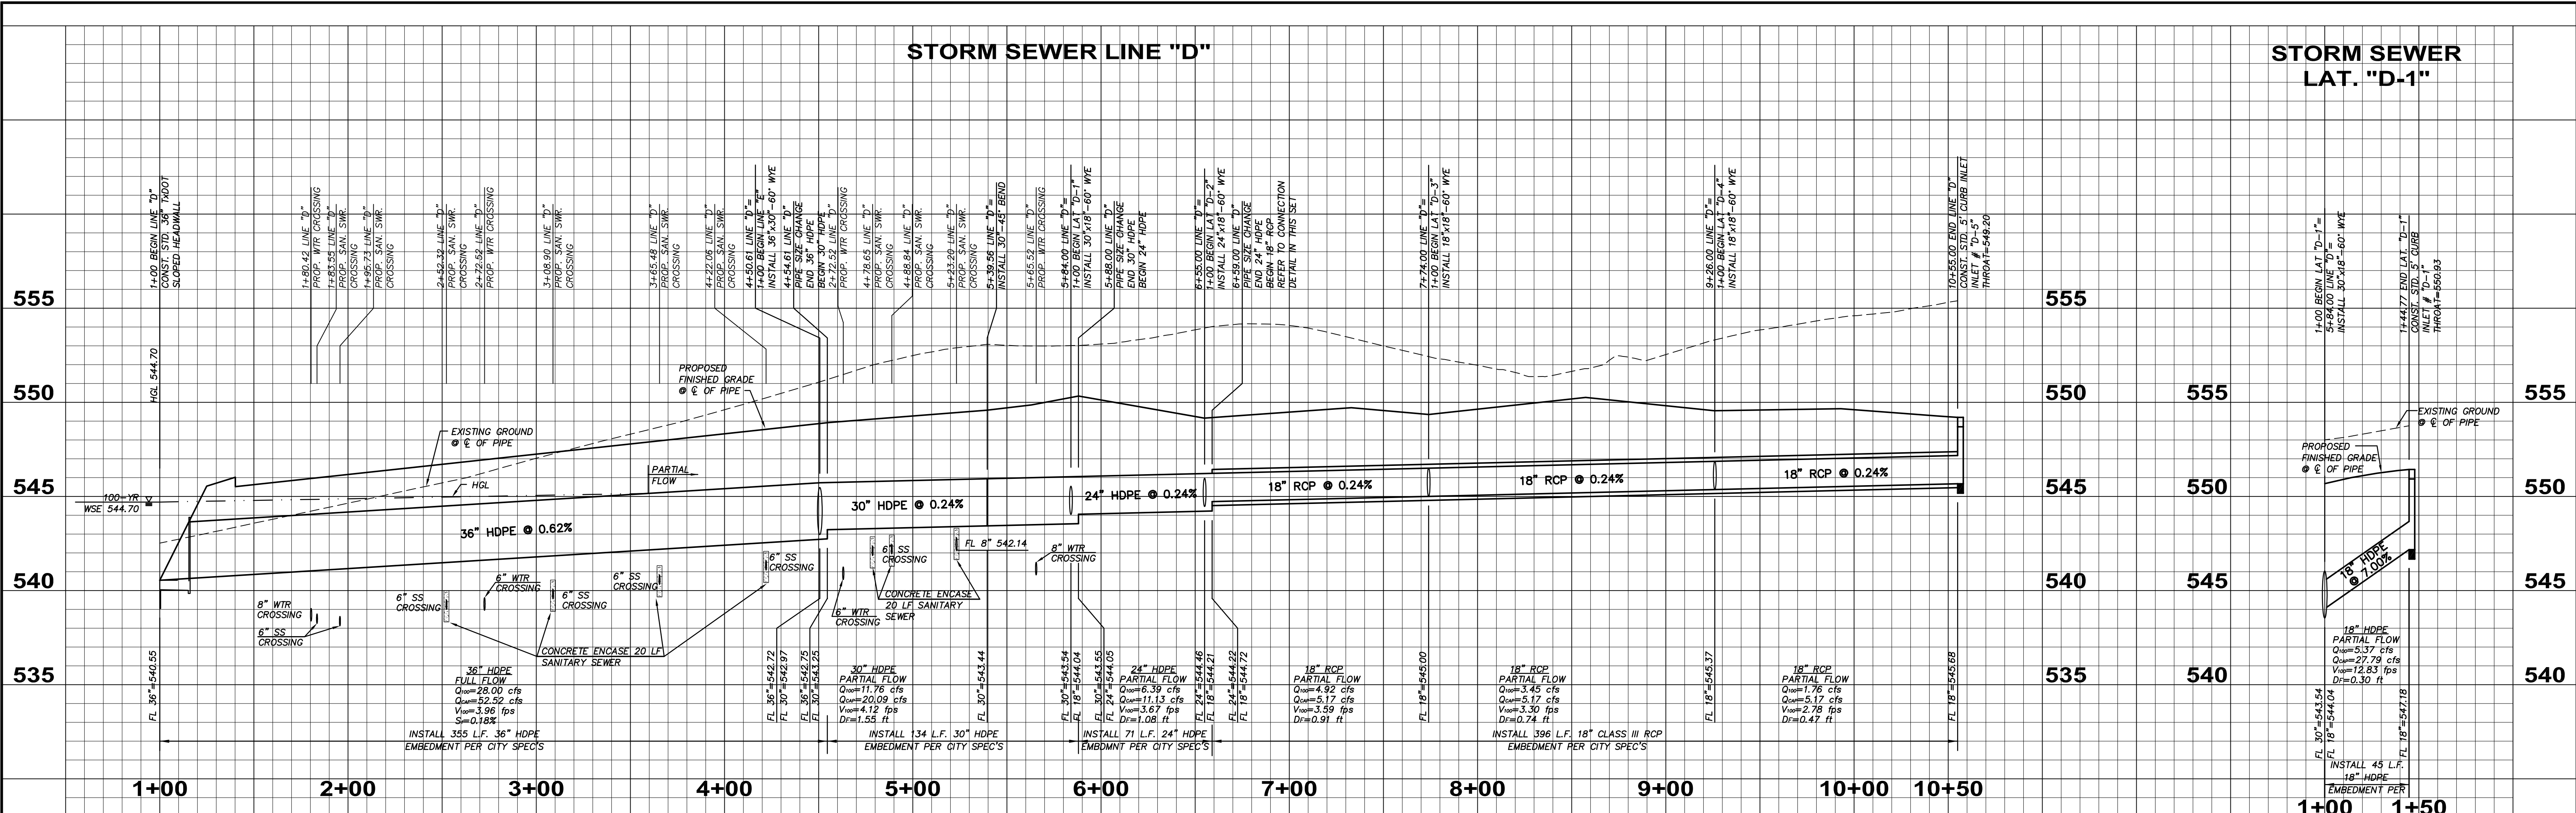

**STORM SEWER LAT. "E-6"**

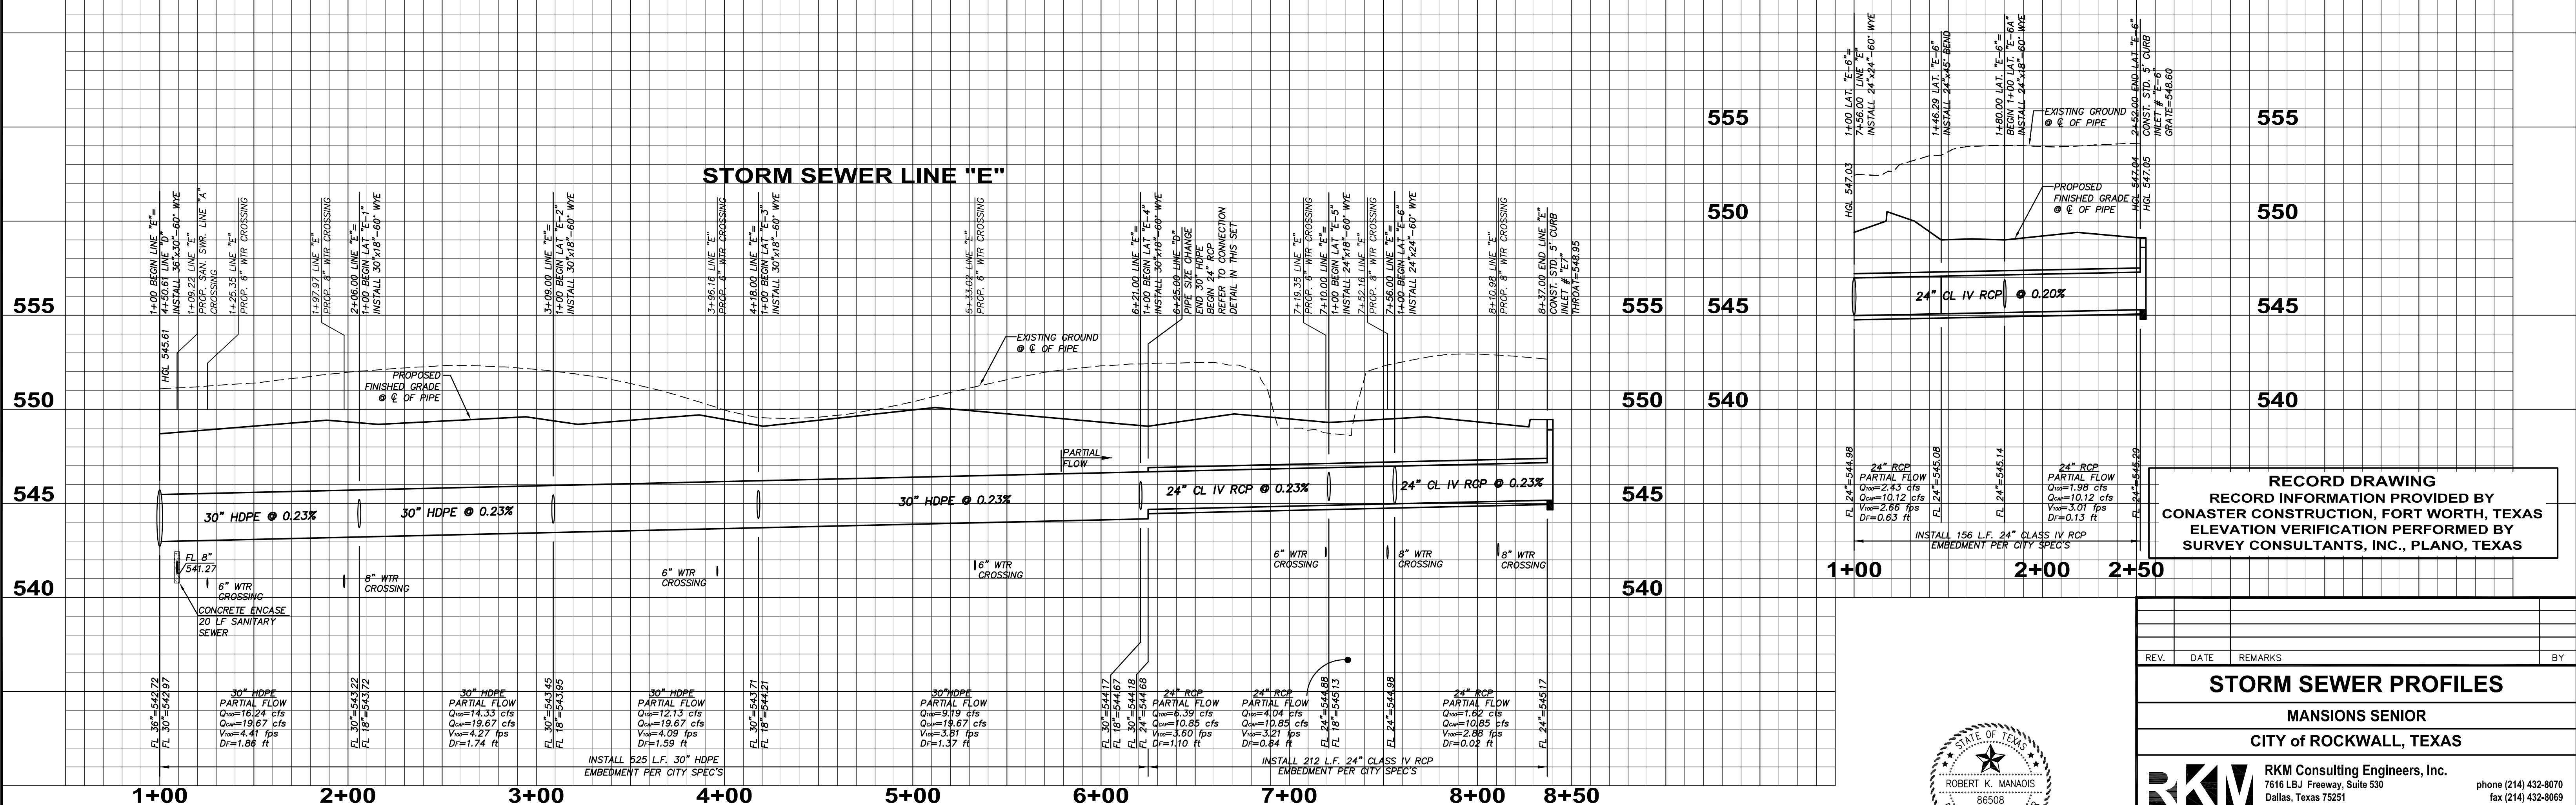

**RECORD DRAWING**  
 RECORD INFORMATION PROVIDED BY  
 CONASTER CONSTRUCTION, FORT WORTH, TEXAS  
 ELEVATION VERIFICATION PERFORMED BY  
 SURVEY CONSULTANTS, INC., PLANO, TEXAS

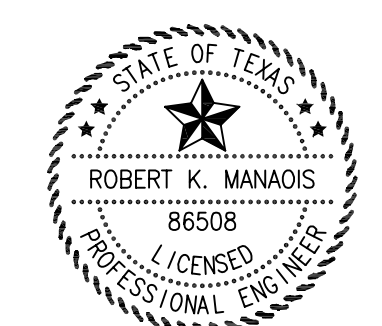

REV.	DATE	REMARKS	BY

**STORM SEWER PROFILES**

MANSIONS SENIOR  
 CITY OF ROCKWALL, TEXAS

**RKM** Consulting Engineers, Inc.  
 7616 LBJ Freeway, Suite 530 Dallas, Texas 75251  
 phone (214) 432-8070  
 fax (214) 432-8069

CHECKED	DESIGN	DRAWN	JOB	DATE	SCALE	SHEET
RKM	JRY		1026-005	02/18/09	1"=40' (H) 1"=4' (V)	<b>13</b>

OF 20