




STORM SEWER LINE "F"

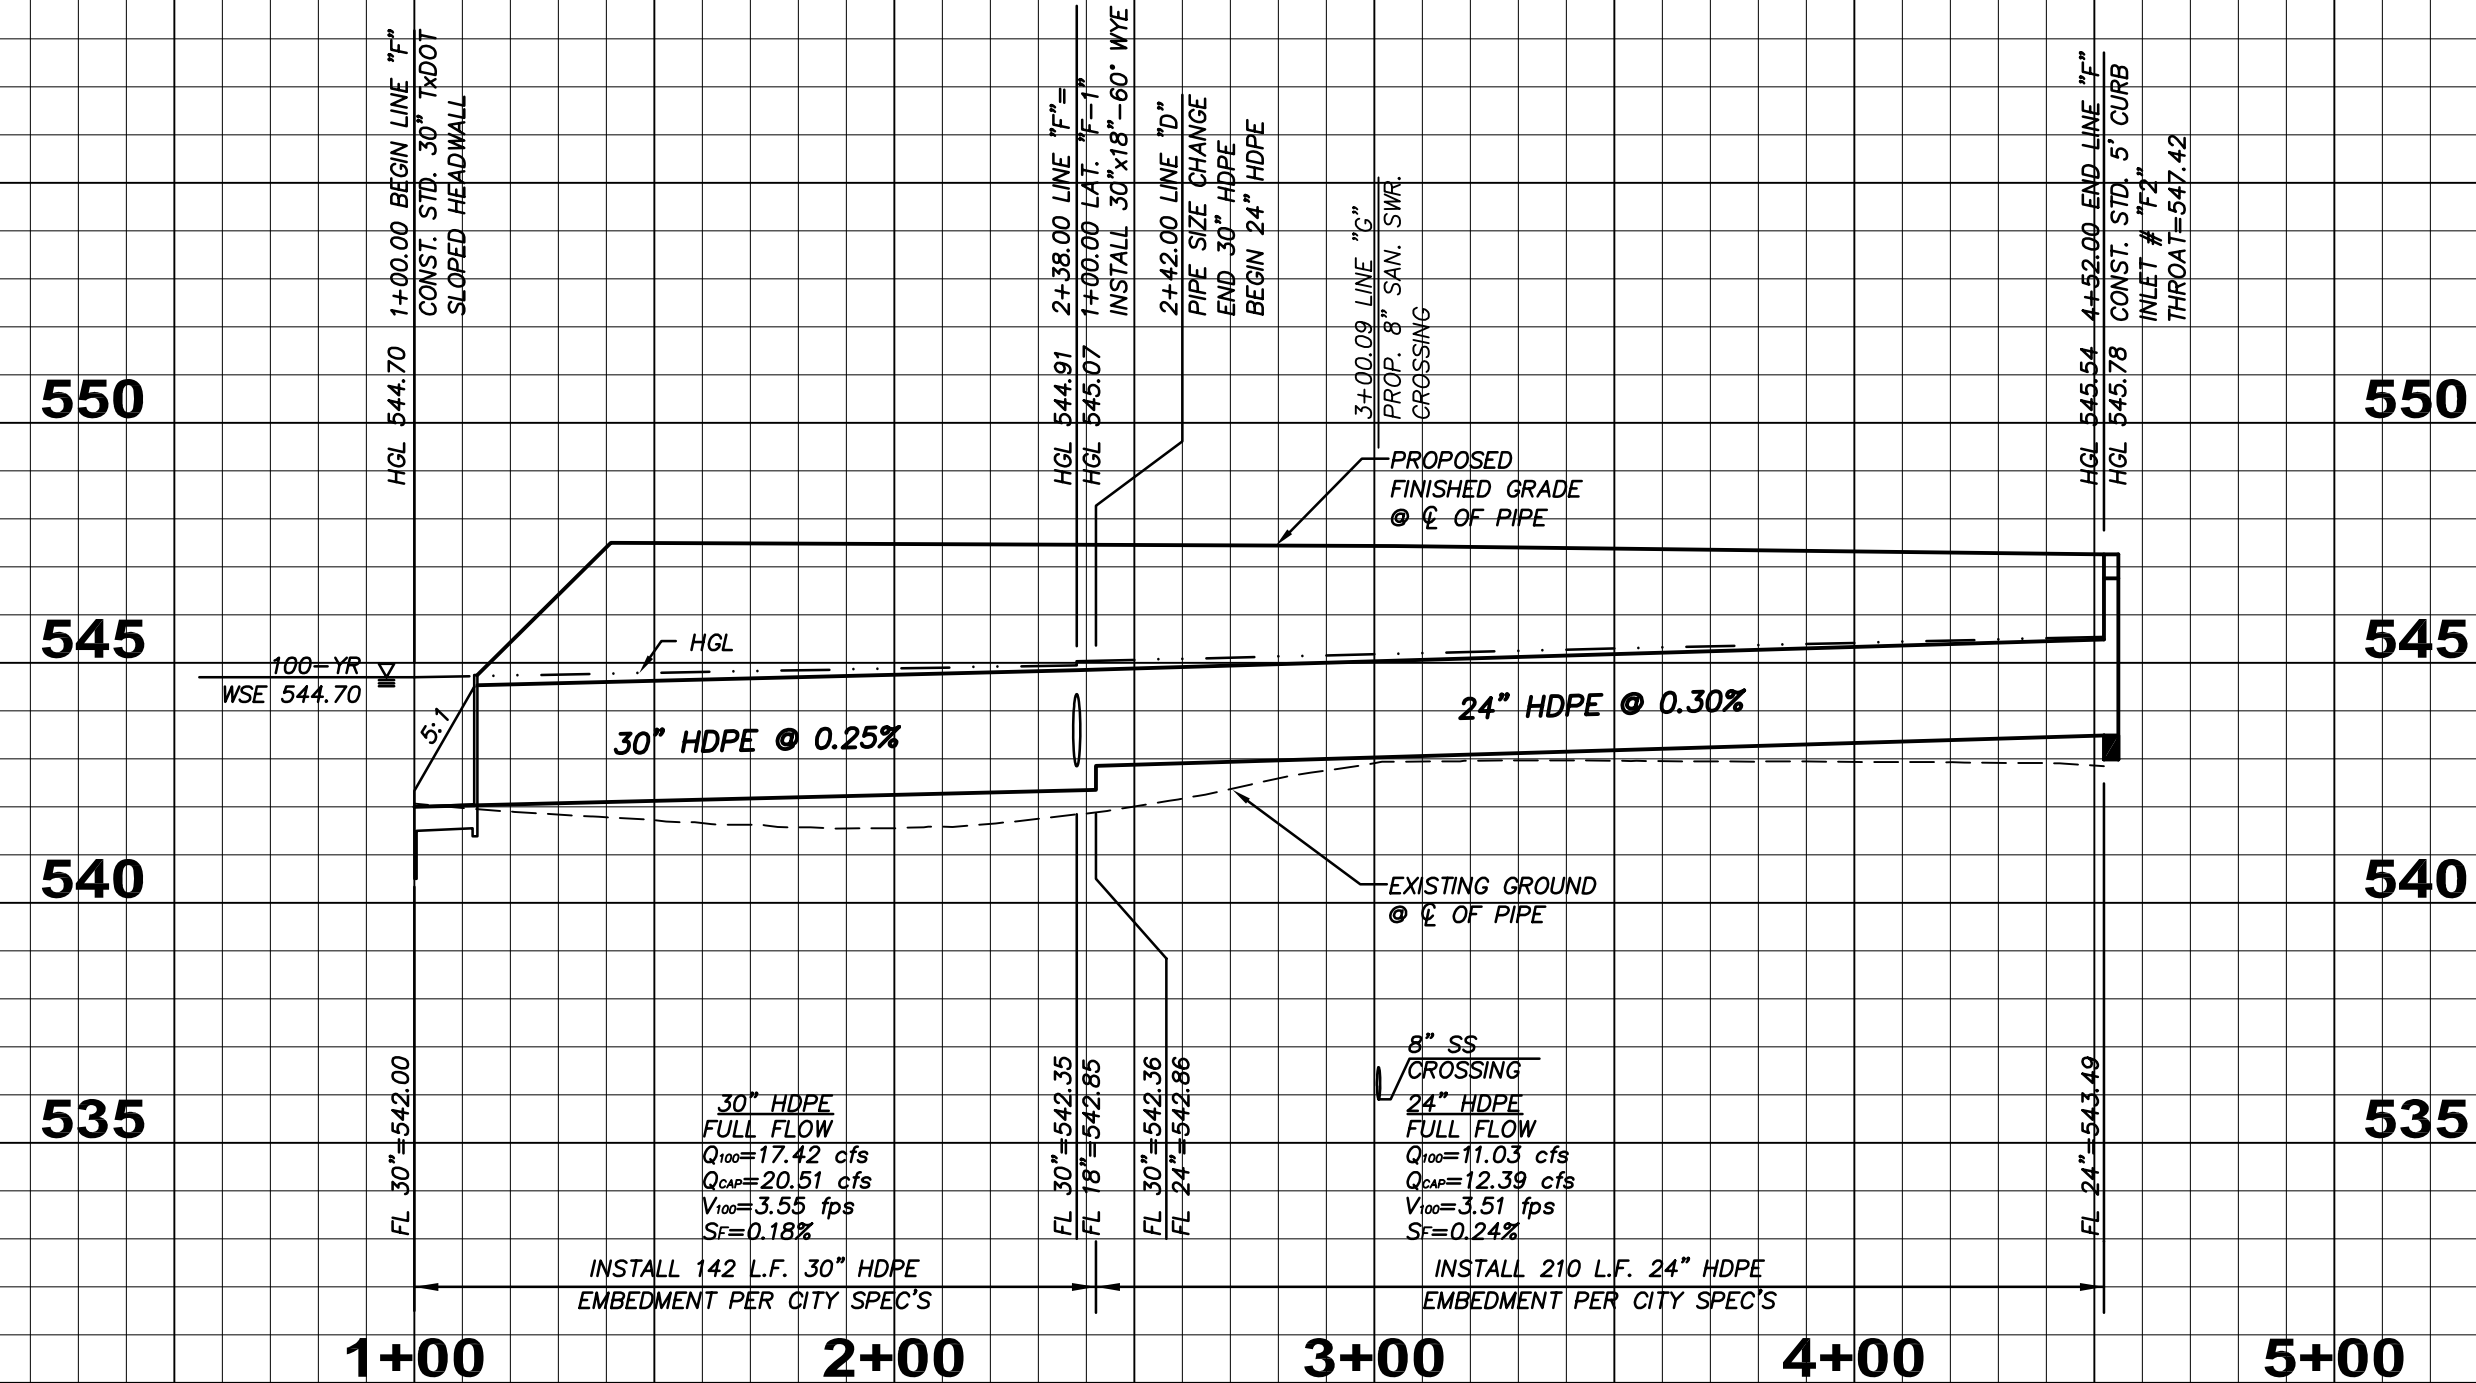

STORM SEWER LINE "G"

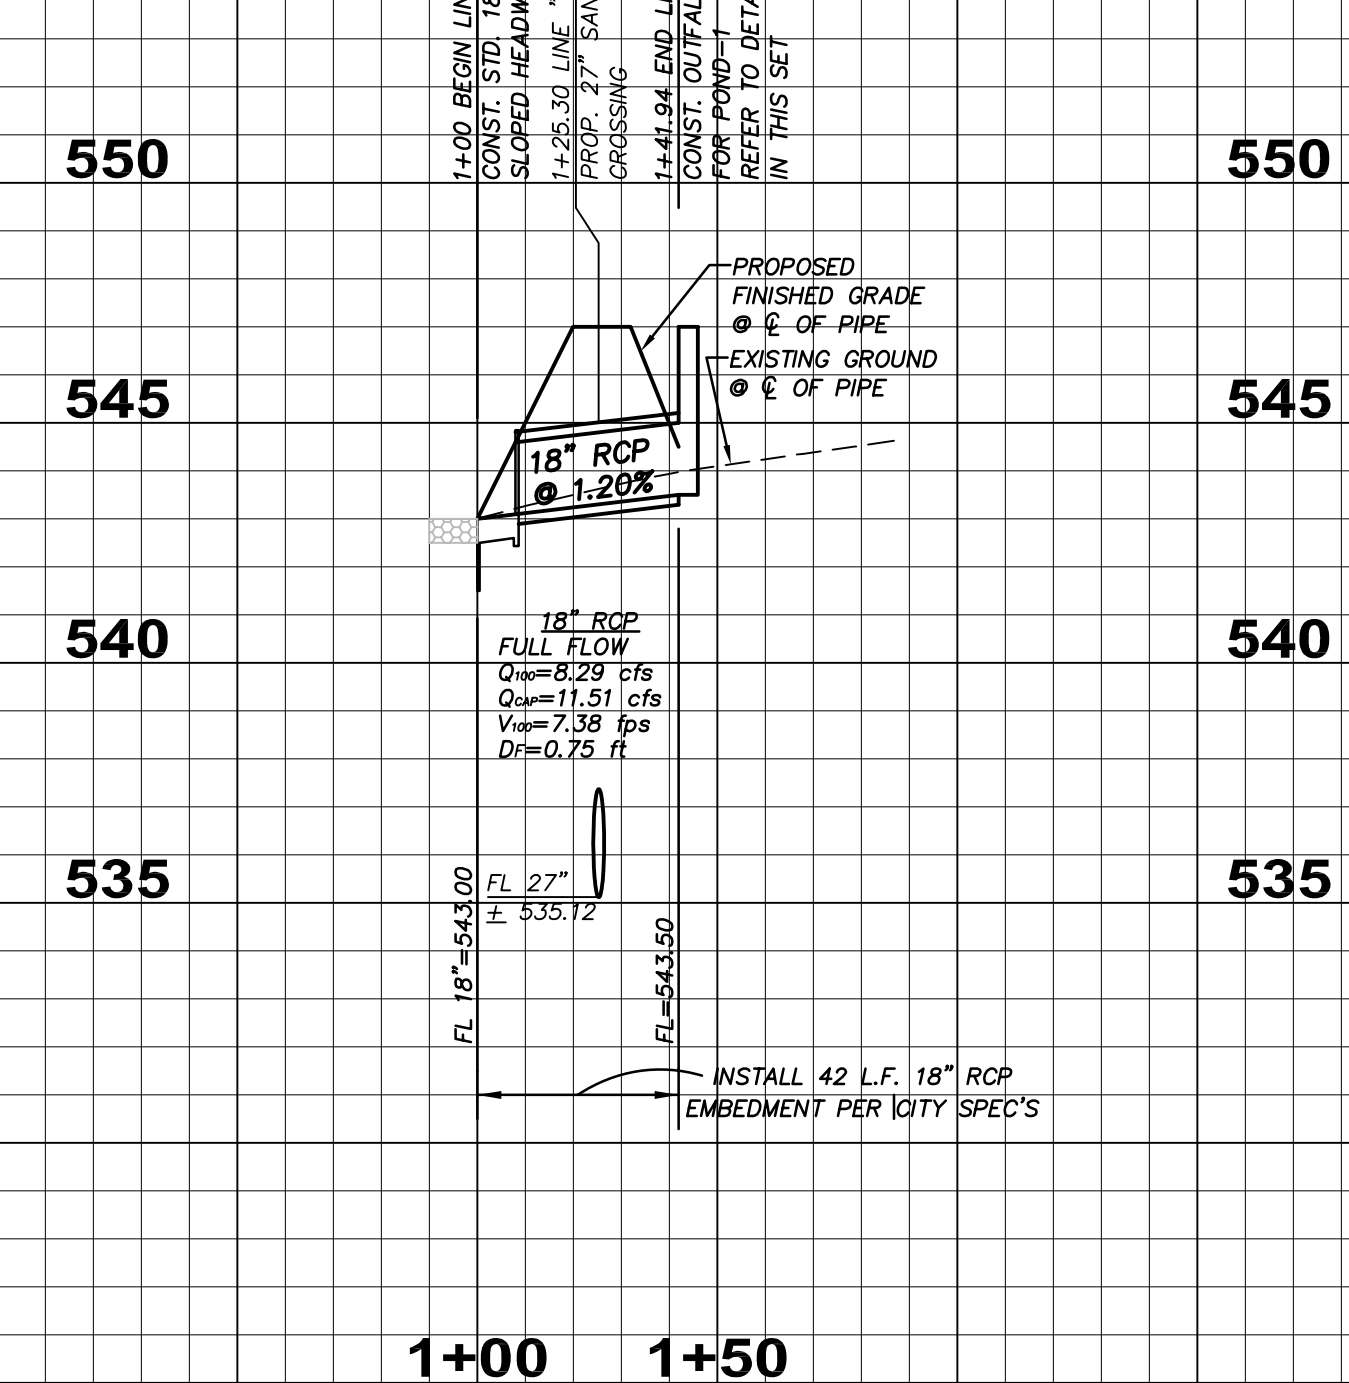

STORM SEWER LINE "H"

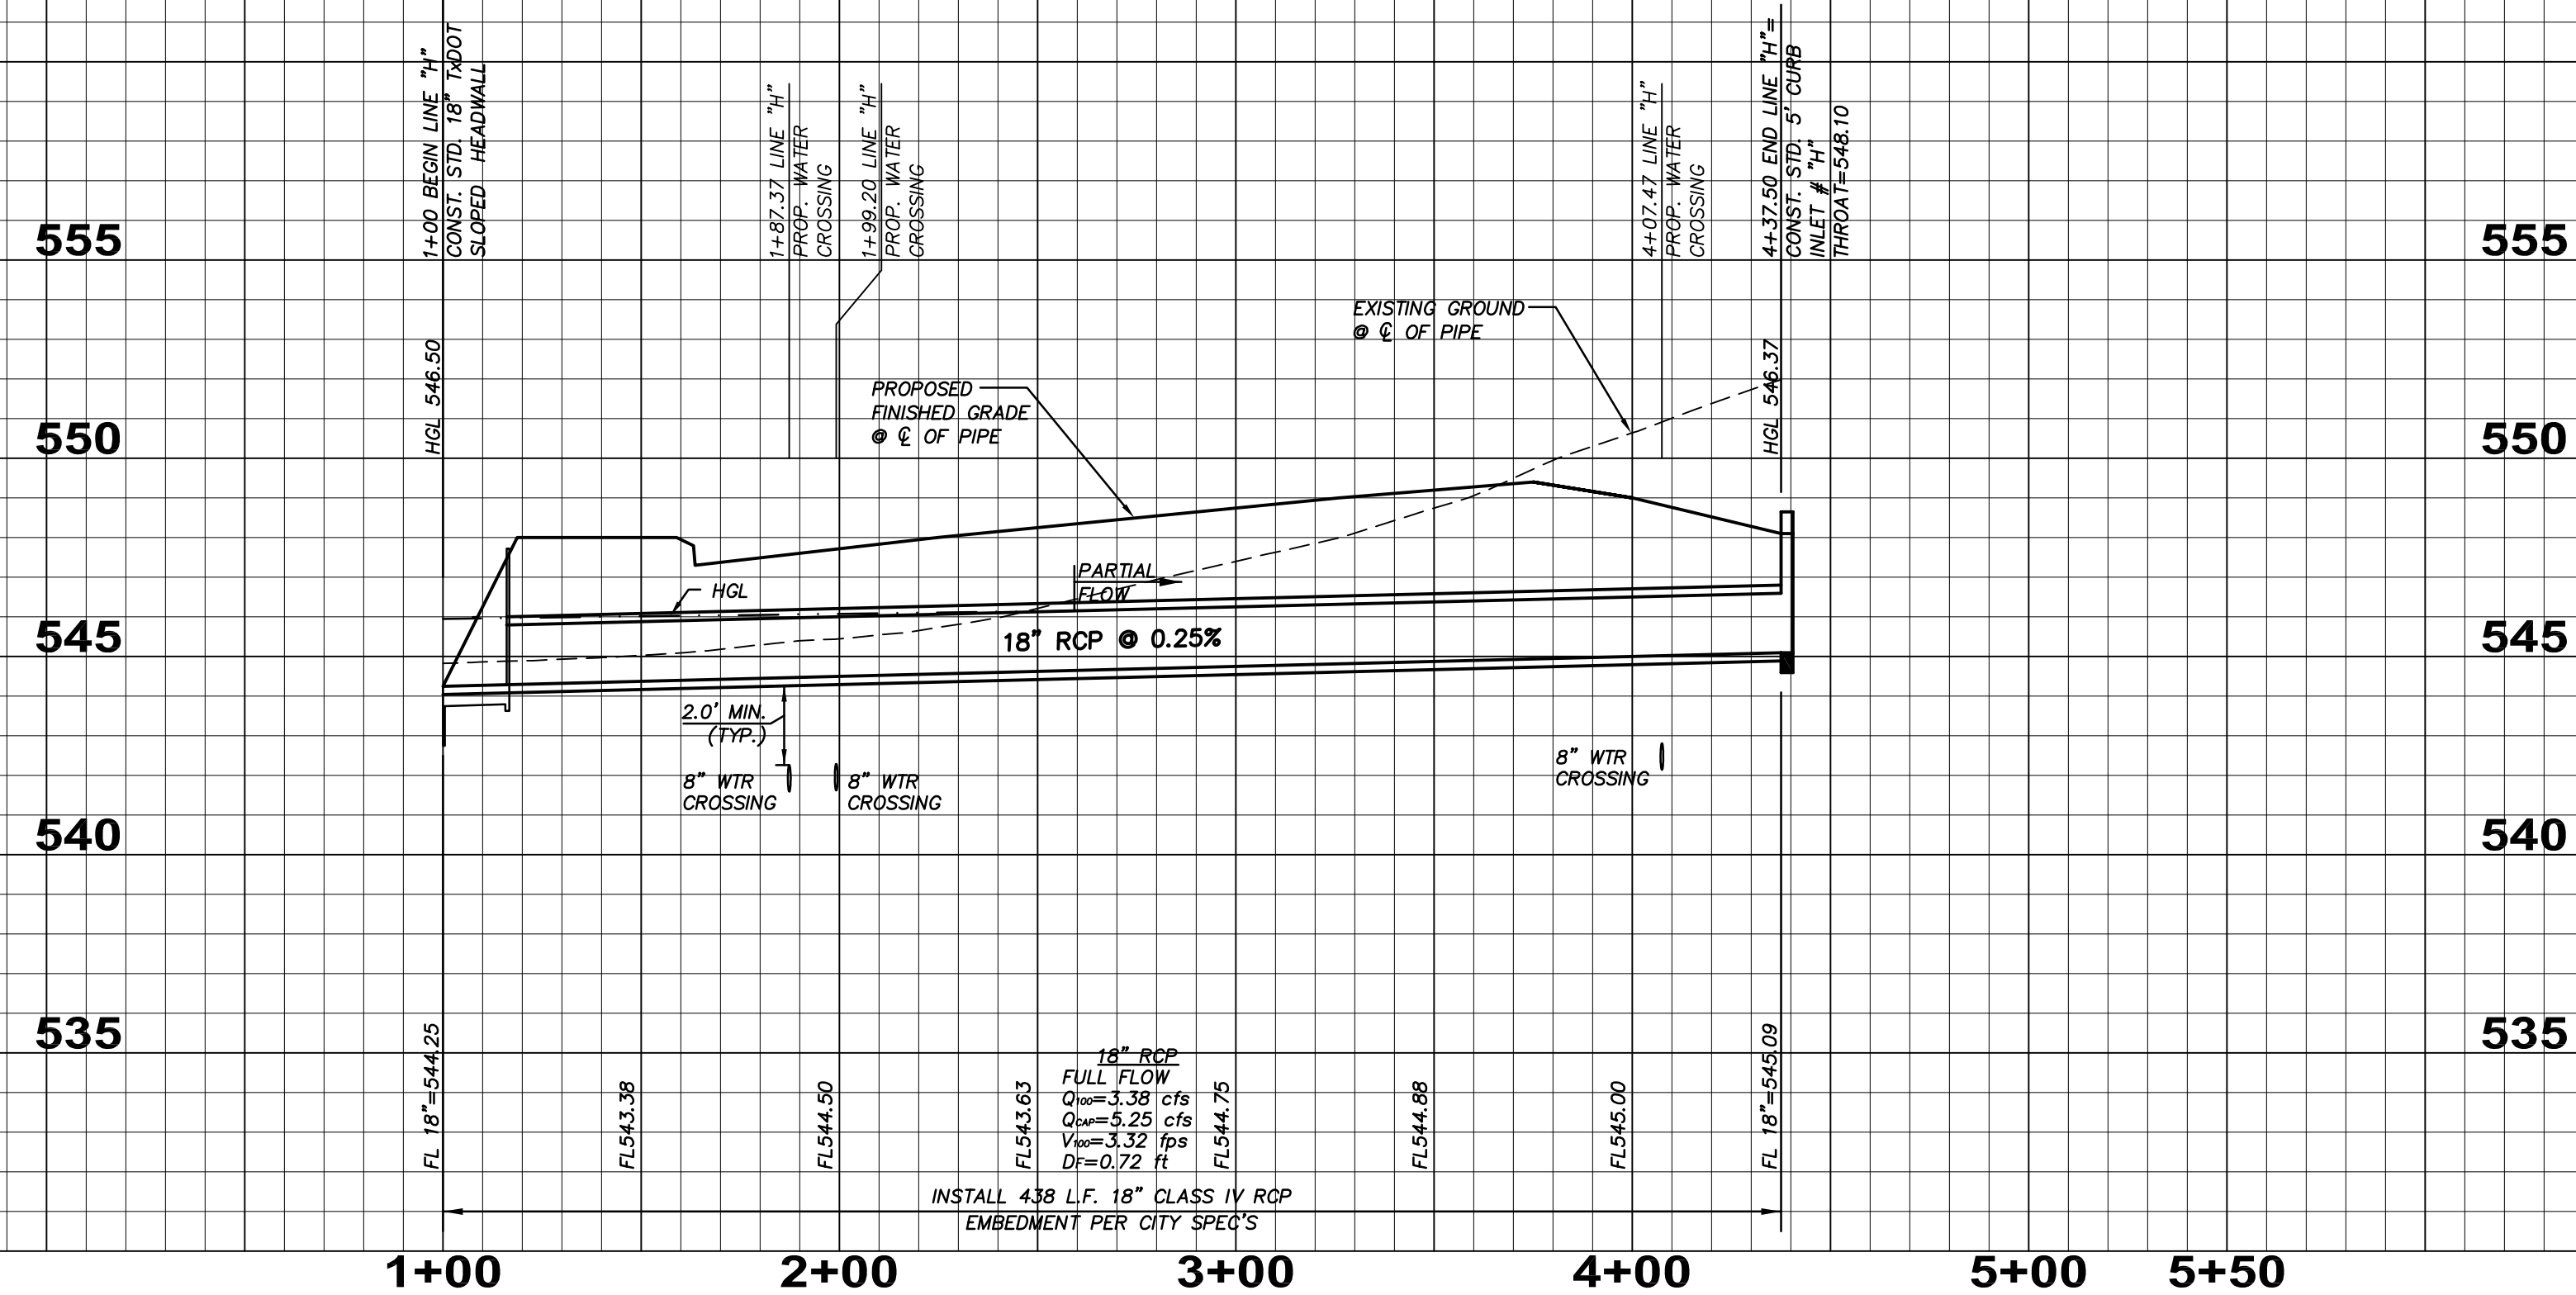

RECORD DRAWING
 RECORD INFORMATION PROVIDED BY
 CONASTER CONSTRUCTION, FORT WORTH, TEXAS
 ELEVATION VERIFICATION PERFORMED BY
 SURVEY CONSULTANTS, INC., PLANO, TEXAS

REV.	DATE	REMARKS	BY
STORM SEWER PROFILES			
MANSIONS SENIOR			
CITY OF ROCKWALL, TEXAS			
RKM		RKM Consulting Engineers, Inc. 7616 LBJ Freeway, Suite 530 Dallas, Texas 75251 86508 Copyright © 2008 RKM Consulting Engineers, Inc.	
phone (214) 432-8070			fax (214) 432-8069
CHECKED	DESIGN	DRAWN	JOB
RKM	JRY	JRY	1026-005
DATE	SCALE	SHEET	
02/18/09	1"=40' (H) 1"=4' (V)	14	
			OF 20

