



**SANITARY SEWER LINE "A"**

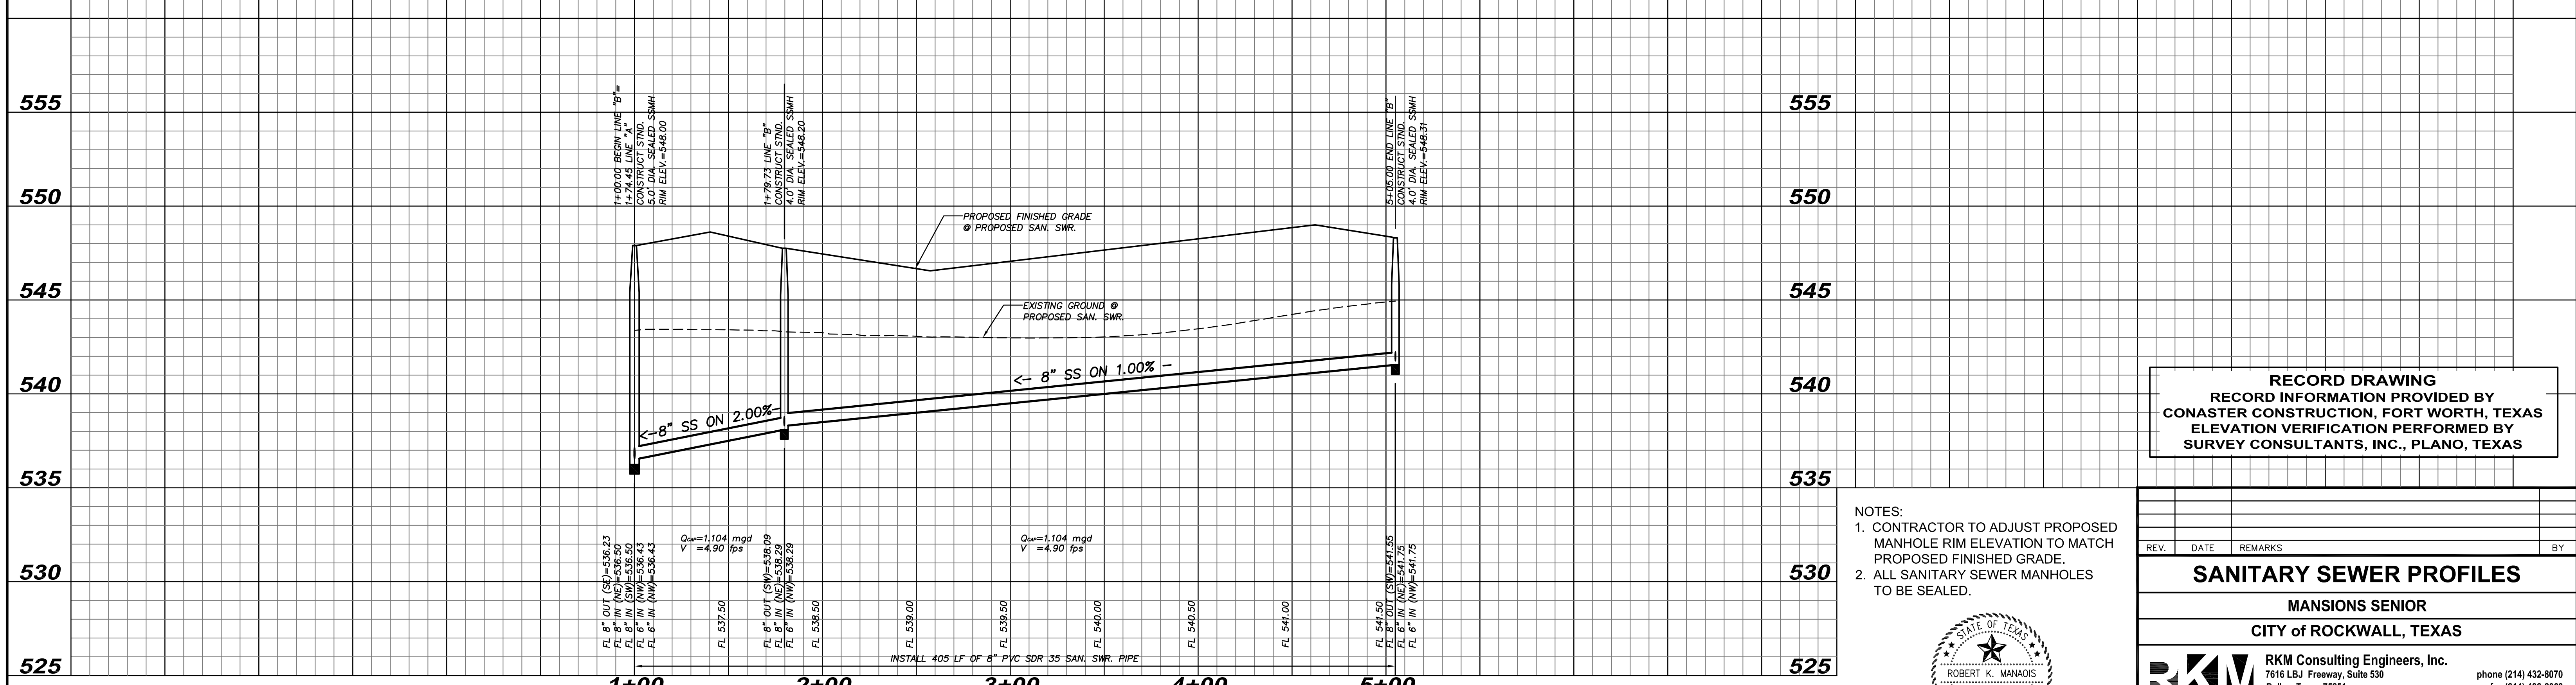

**SANITARY SEWER LINE "B"**

**RECORD DRAWING**  
 RECORD INFORMATION PROVIDED BY  
 CONASTER CONSTRUCTION, FORT WORTH, TEXAS  
 ELEVATION VERIFICATION PERFORMED BY  
 SURVEY CONSULTANTS, INC., PLANO, TEXAS

- NOTES:  
 1. CONTRACTOR TO ADJUST PROPOSED MANHOLE RIM ELEVATION TO MATCH PROPOSED FINISHED GRADE.  
 2. ALL SANITARY SEWER MANHOLES TO BE SEALED.

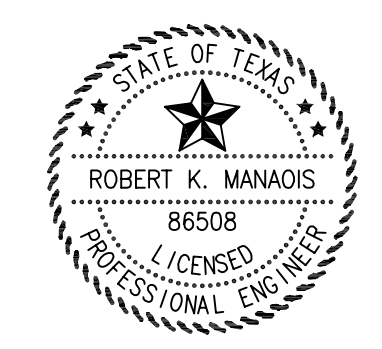

REV.	DATE	REMARKS	BY

**SANITARY SEWER PROFILES**

MANSIONS SENIOR  
 CITY OF ROCKWALL, TEXAS

**RKM** RKM Consulting Engineers, Inc.  
 7616 LBJ Freeway, Suite 530 Dallas, Texas 75251  
 phone (214) 432-8070 fax (214) 432-8069

CHECKED	DESIGN	DRAWN	JOB	DATE	SCALE	SHEET
RKM	JRY	JRY	1026-005	02/18/09	1"=40' (H) 1"=4' (V)	<b>16</b>

OF 20